

23-11-16
6-12-15
13-12-15

PROFILE AND DECK PLANS.

SCALE 1/8 INCH = ONE FOOT.

DIMENSIONS 380'0" x 53'0" x 26'9" M.L.D.

TO CLASS 100A.1 AT LLOYD'S.

Shelter deck with freeboard

See General Arrang.

Note: This plan submitted in conjunction with the midship section and details of bulkheads, Tank top and Centre line Bulkhead plans.


Amended Profile & deck plans to be submitted embodying later requirements.

Bulkhead vertical stiffeners

28' to tank deck	→ 7 x 8 1/2 x 57 B.P.
30' "	" " " " " " " " " " " "
31' "	" " " " " " " " " " " "
32' "	" " " " " " " " " " " "
33' "	" " " " " " " " " " " "

FORECASTLE DECK.

BEAMS 7' 6" x 42" B.R. ON EVERY FRAME.
DECK 5' 3 1/2" PITCH PLATE.

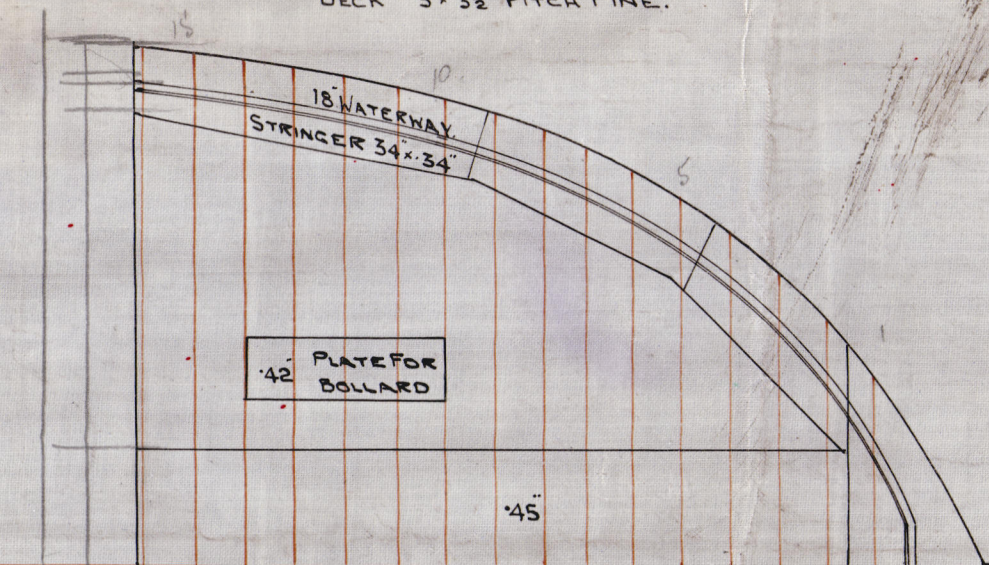


Vertical space between expansion tanks to be adopted for use as a summer tank.

The small hatchways on the weather deck over the oil space to be arranged at each end of the oil compartments as near to the transverse stiff bulkheads as possible but to clear brackets at top of bulkhead stiffeners. These hatchways to be 3' x 3' by 8' high.

For position of hatchways see General Arrangement plan as approved by the Admiralty. The hatchways to central space (summer tank) are to be 6'0" x 4'0" and 8' high, arranged one at each end of each oil space.

For Position of Pump Room see General Arrangement Plan. Admiralty require pump room to be 14 feet minimum length.

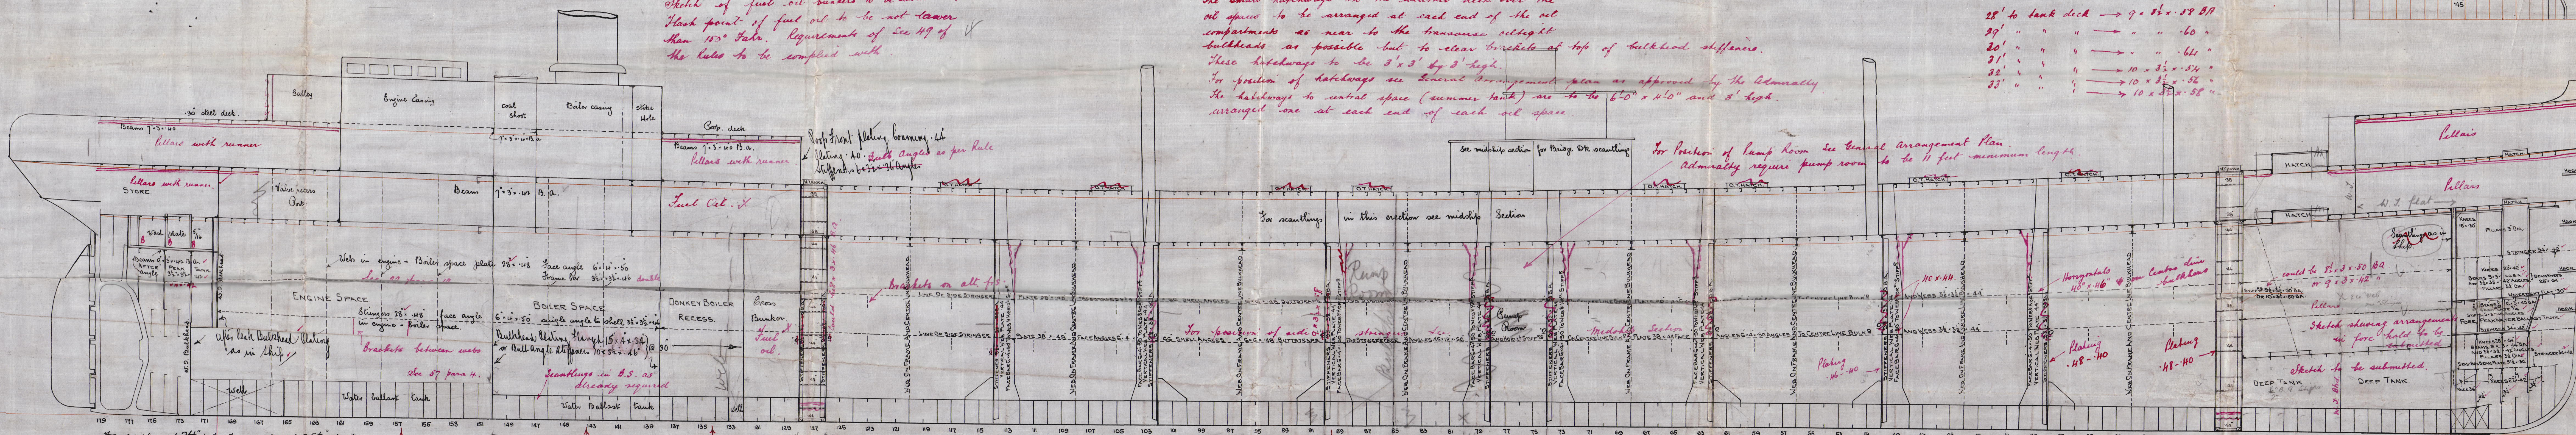

AWNING DECK.

MAIN DECK.

Nº 505 OIL STEAMER.

80
 9589


W970-0117

© 20

Lloyd's Register
Foundation