

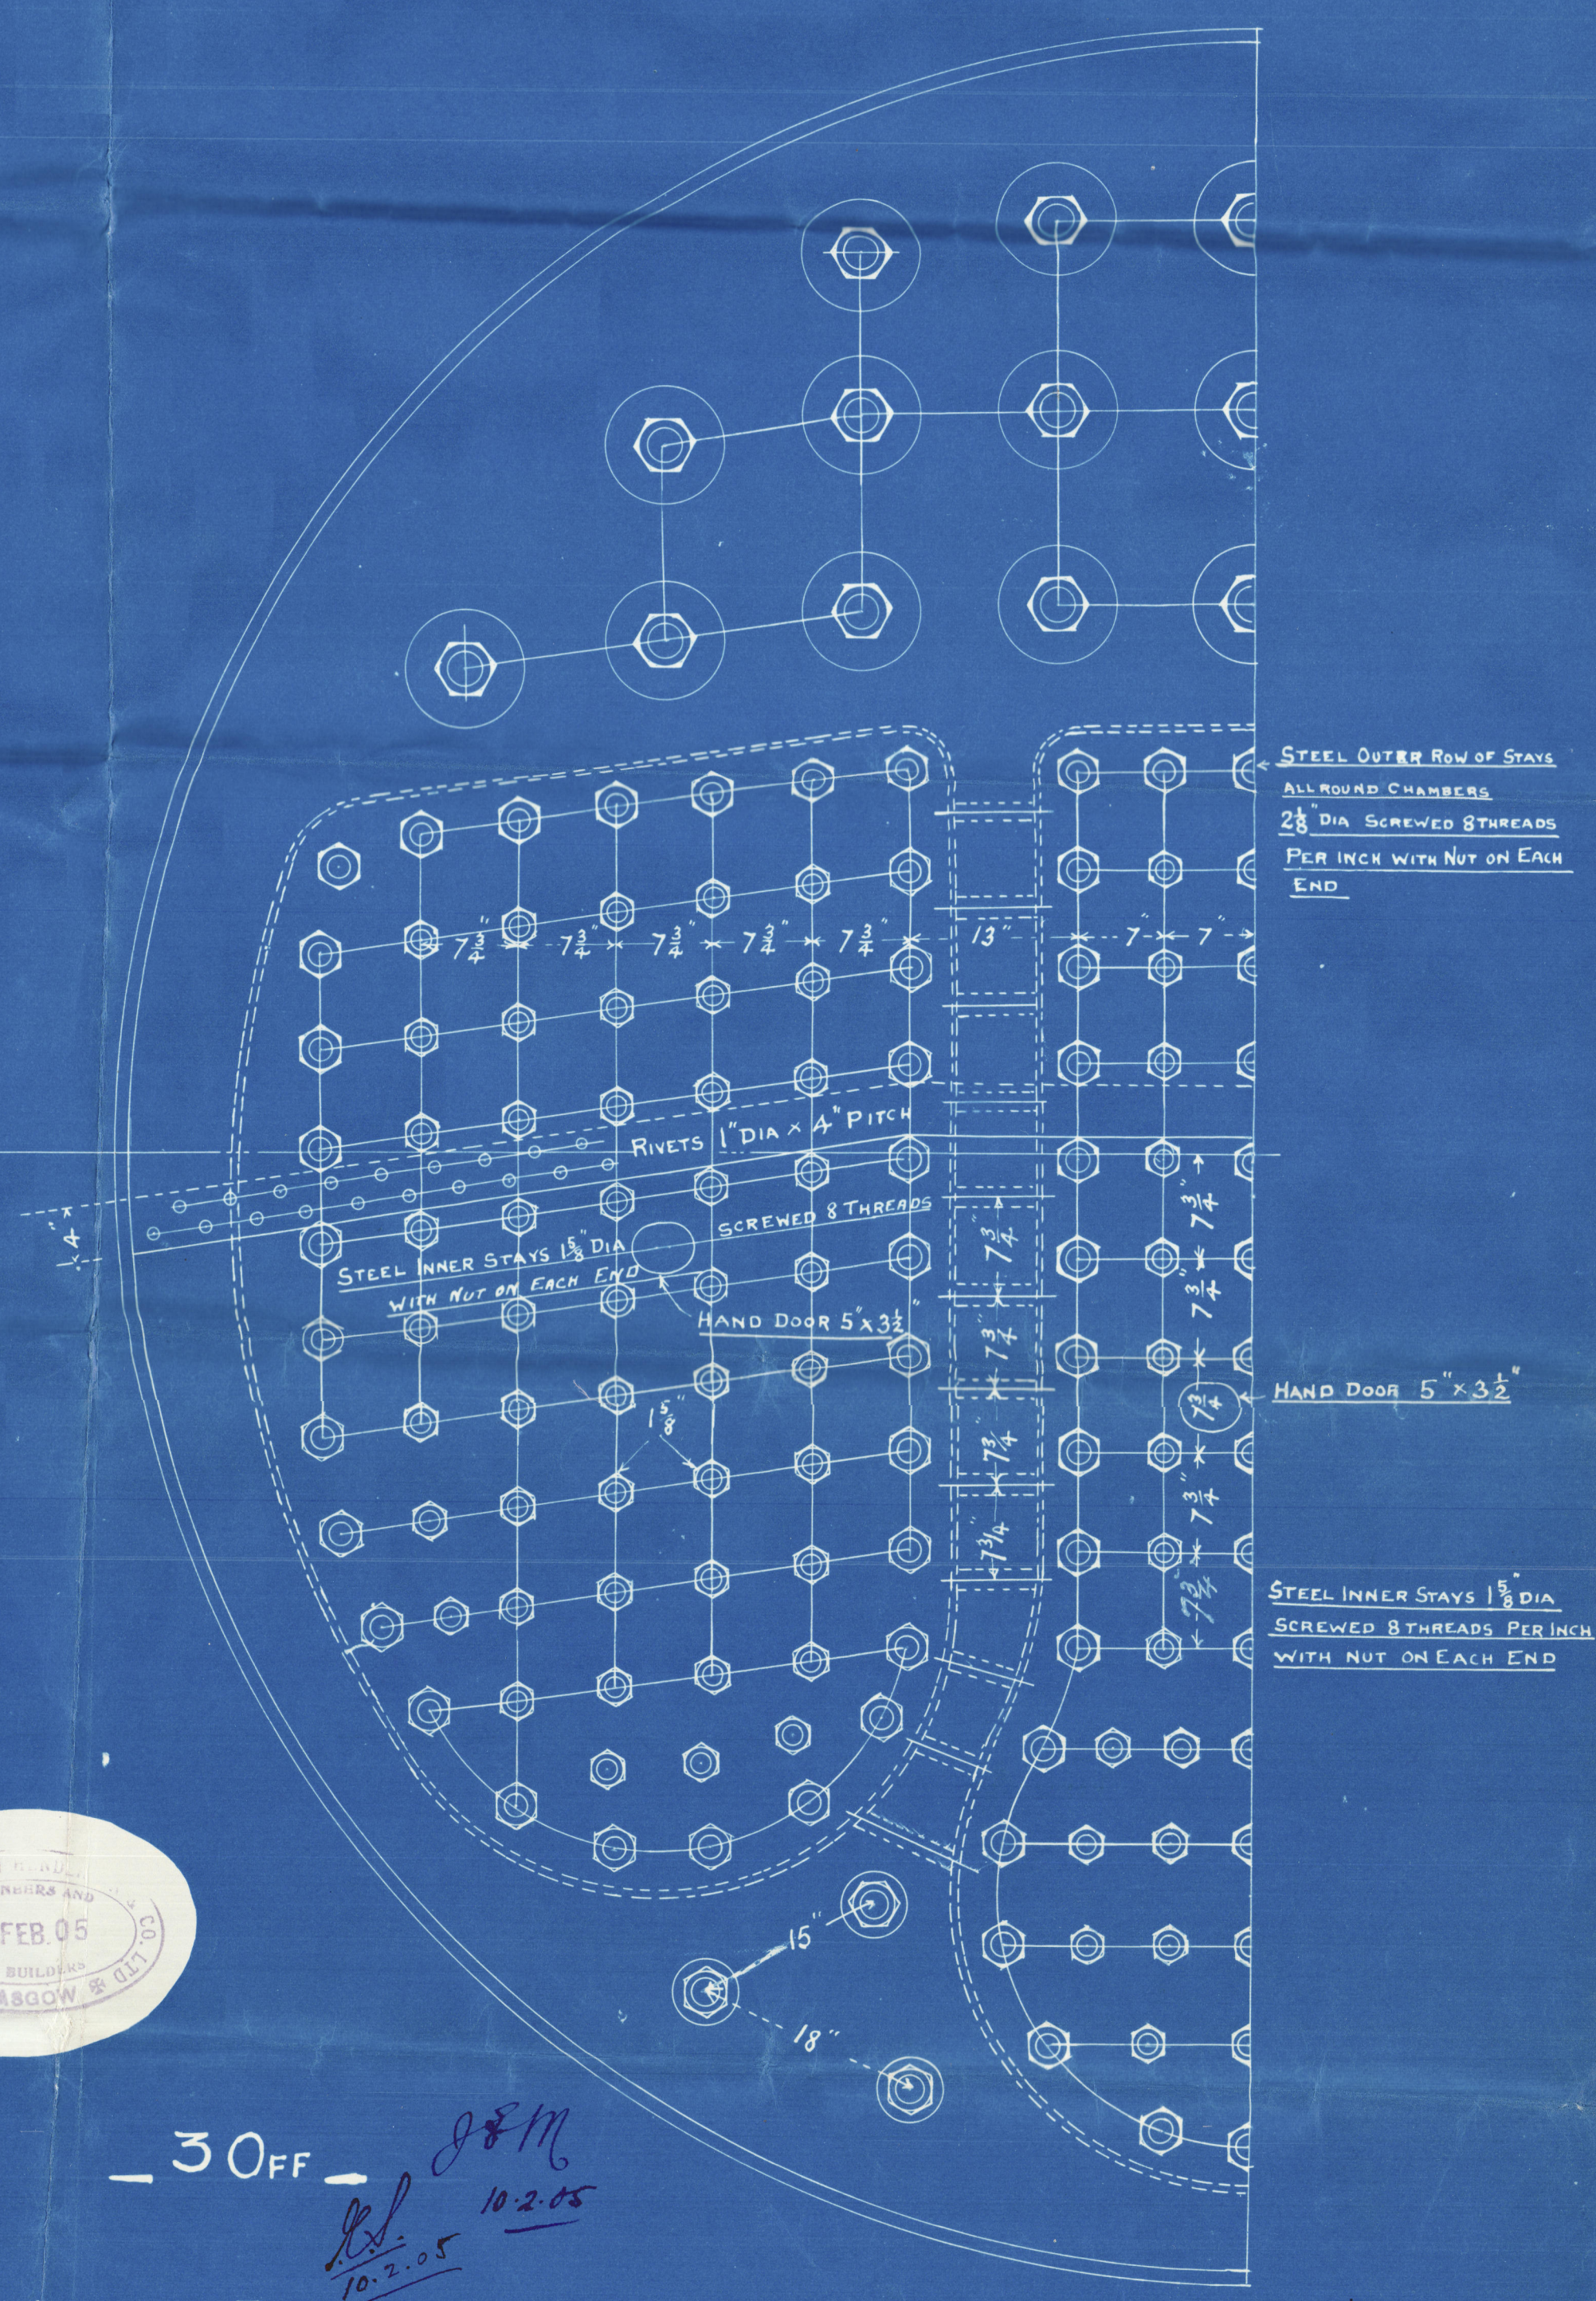
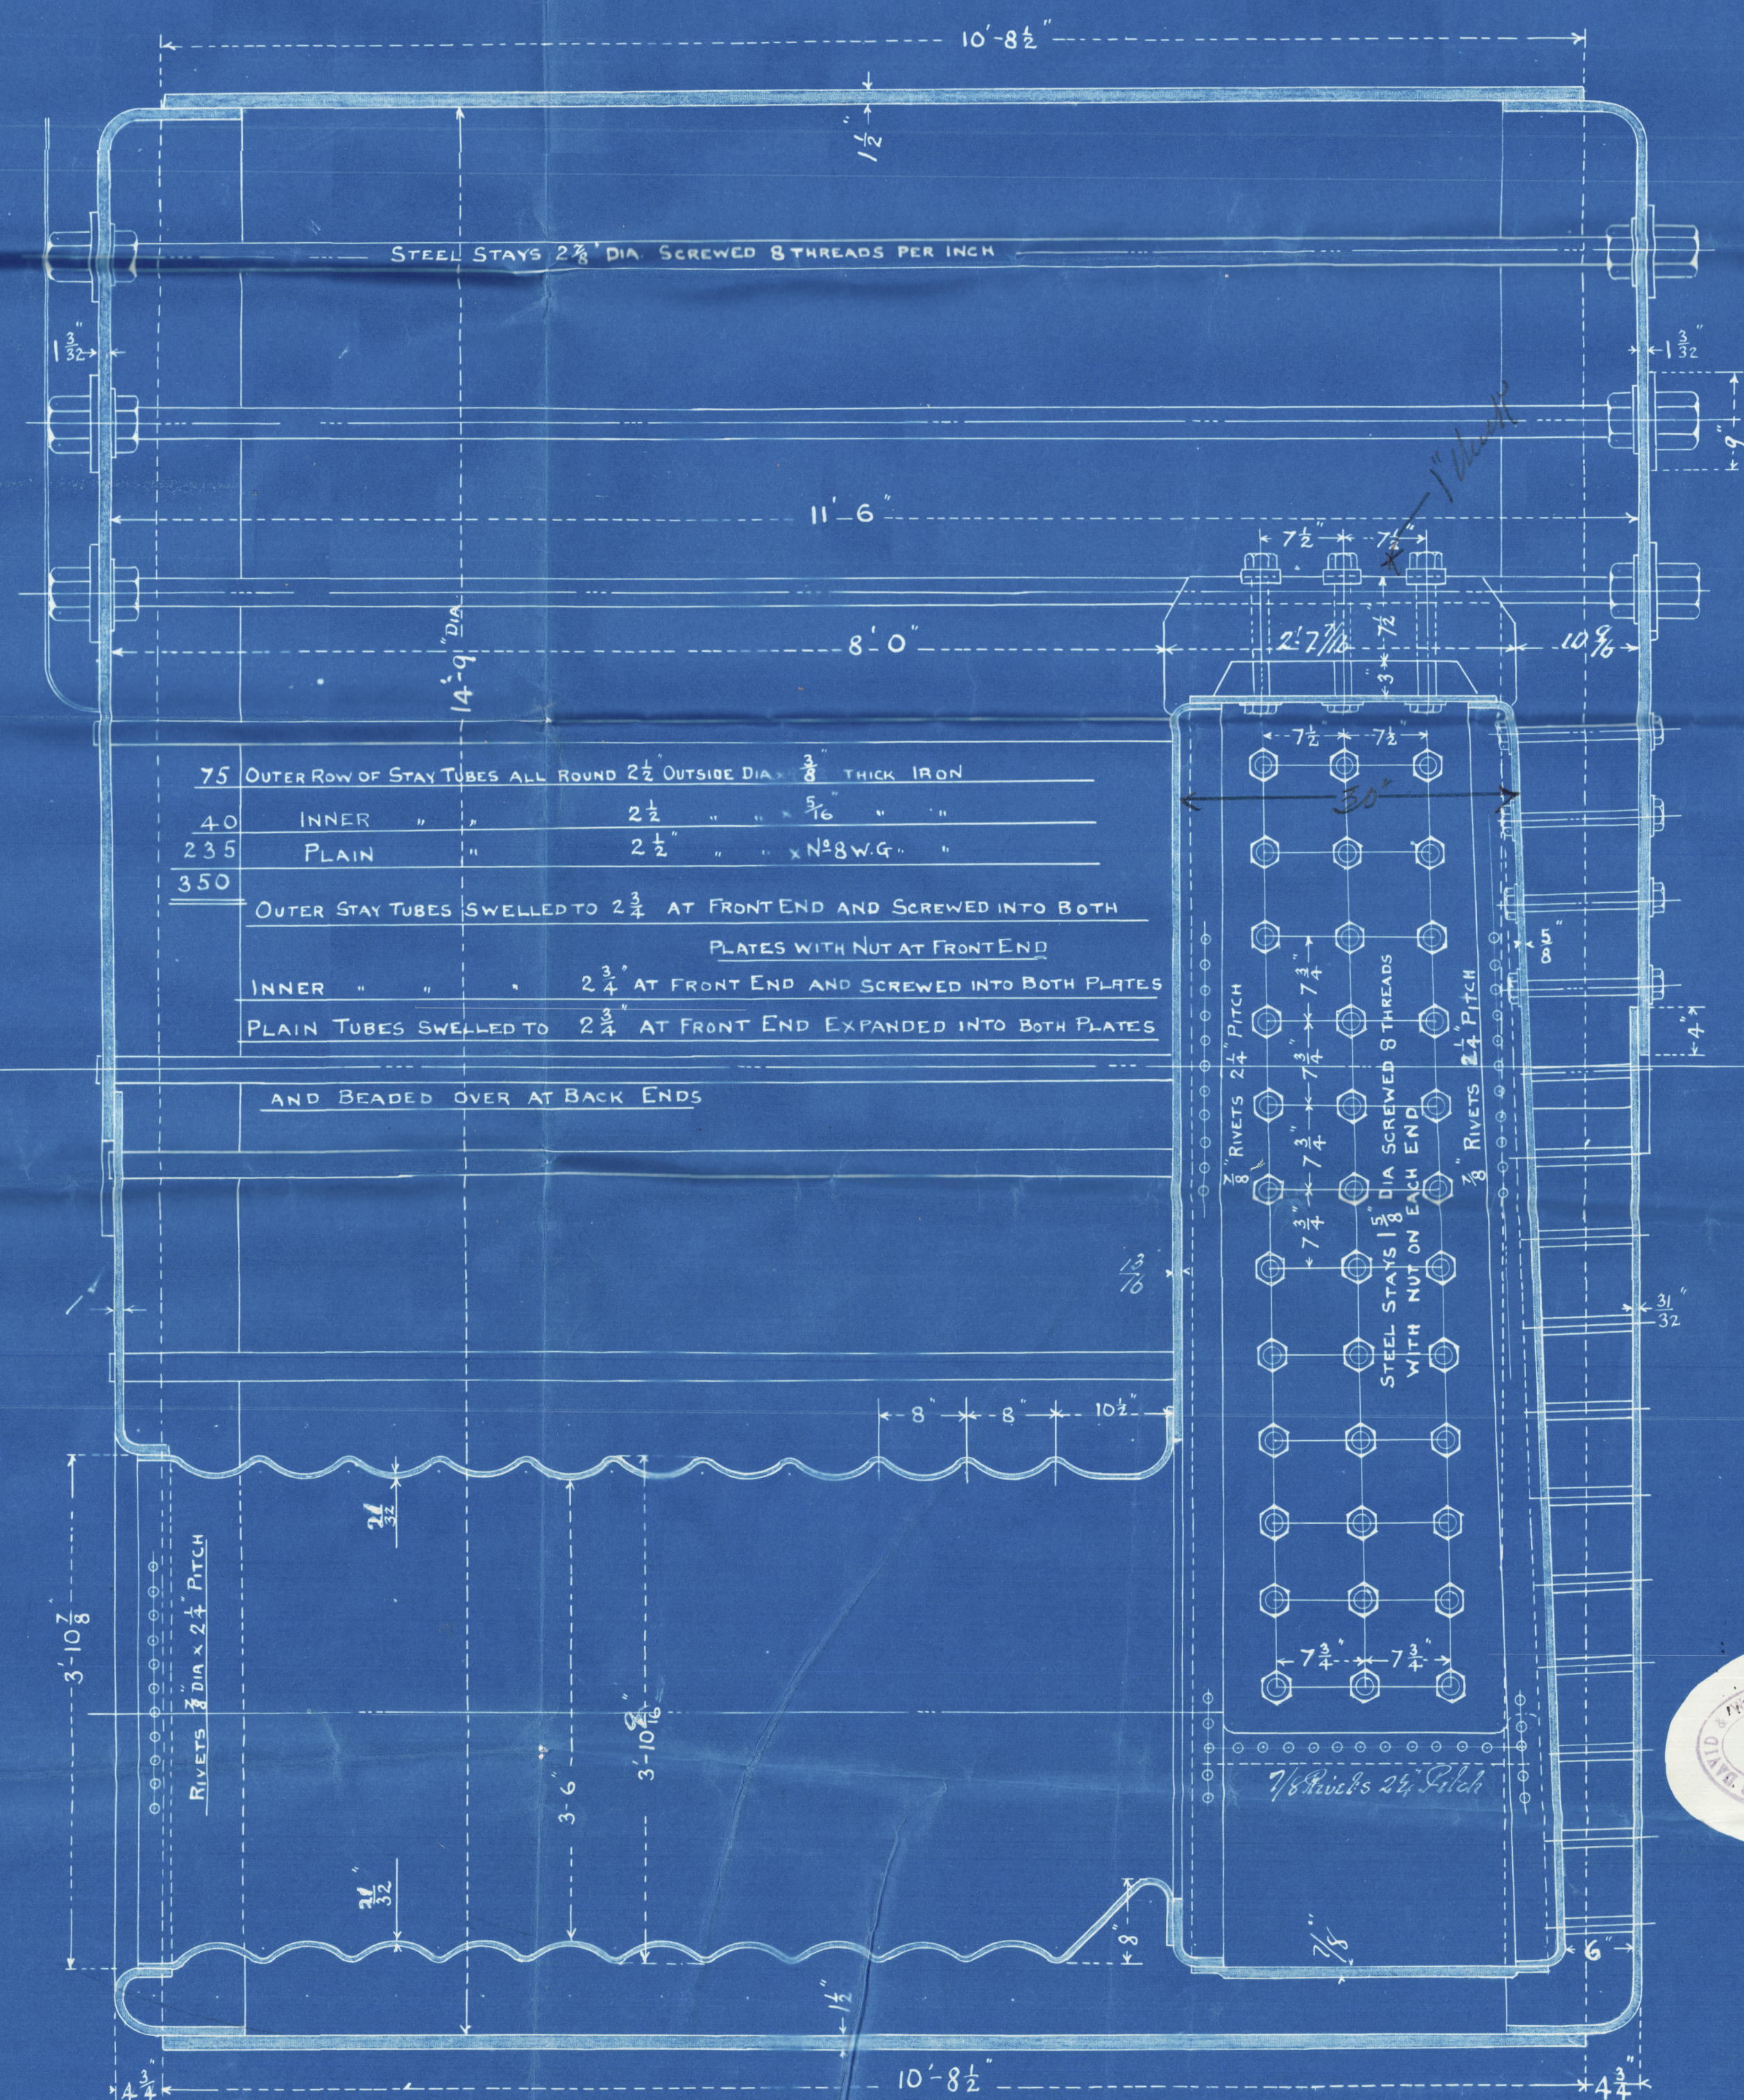


11:2:05

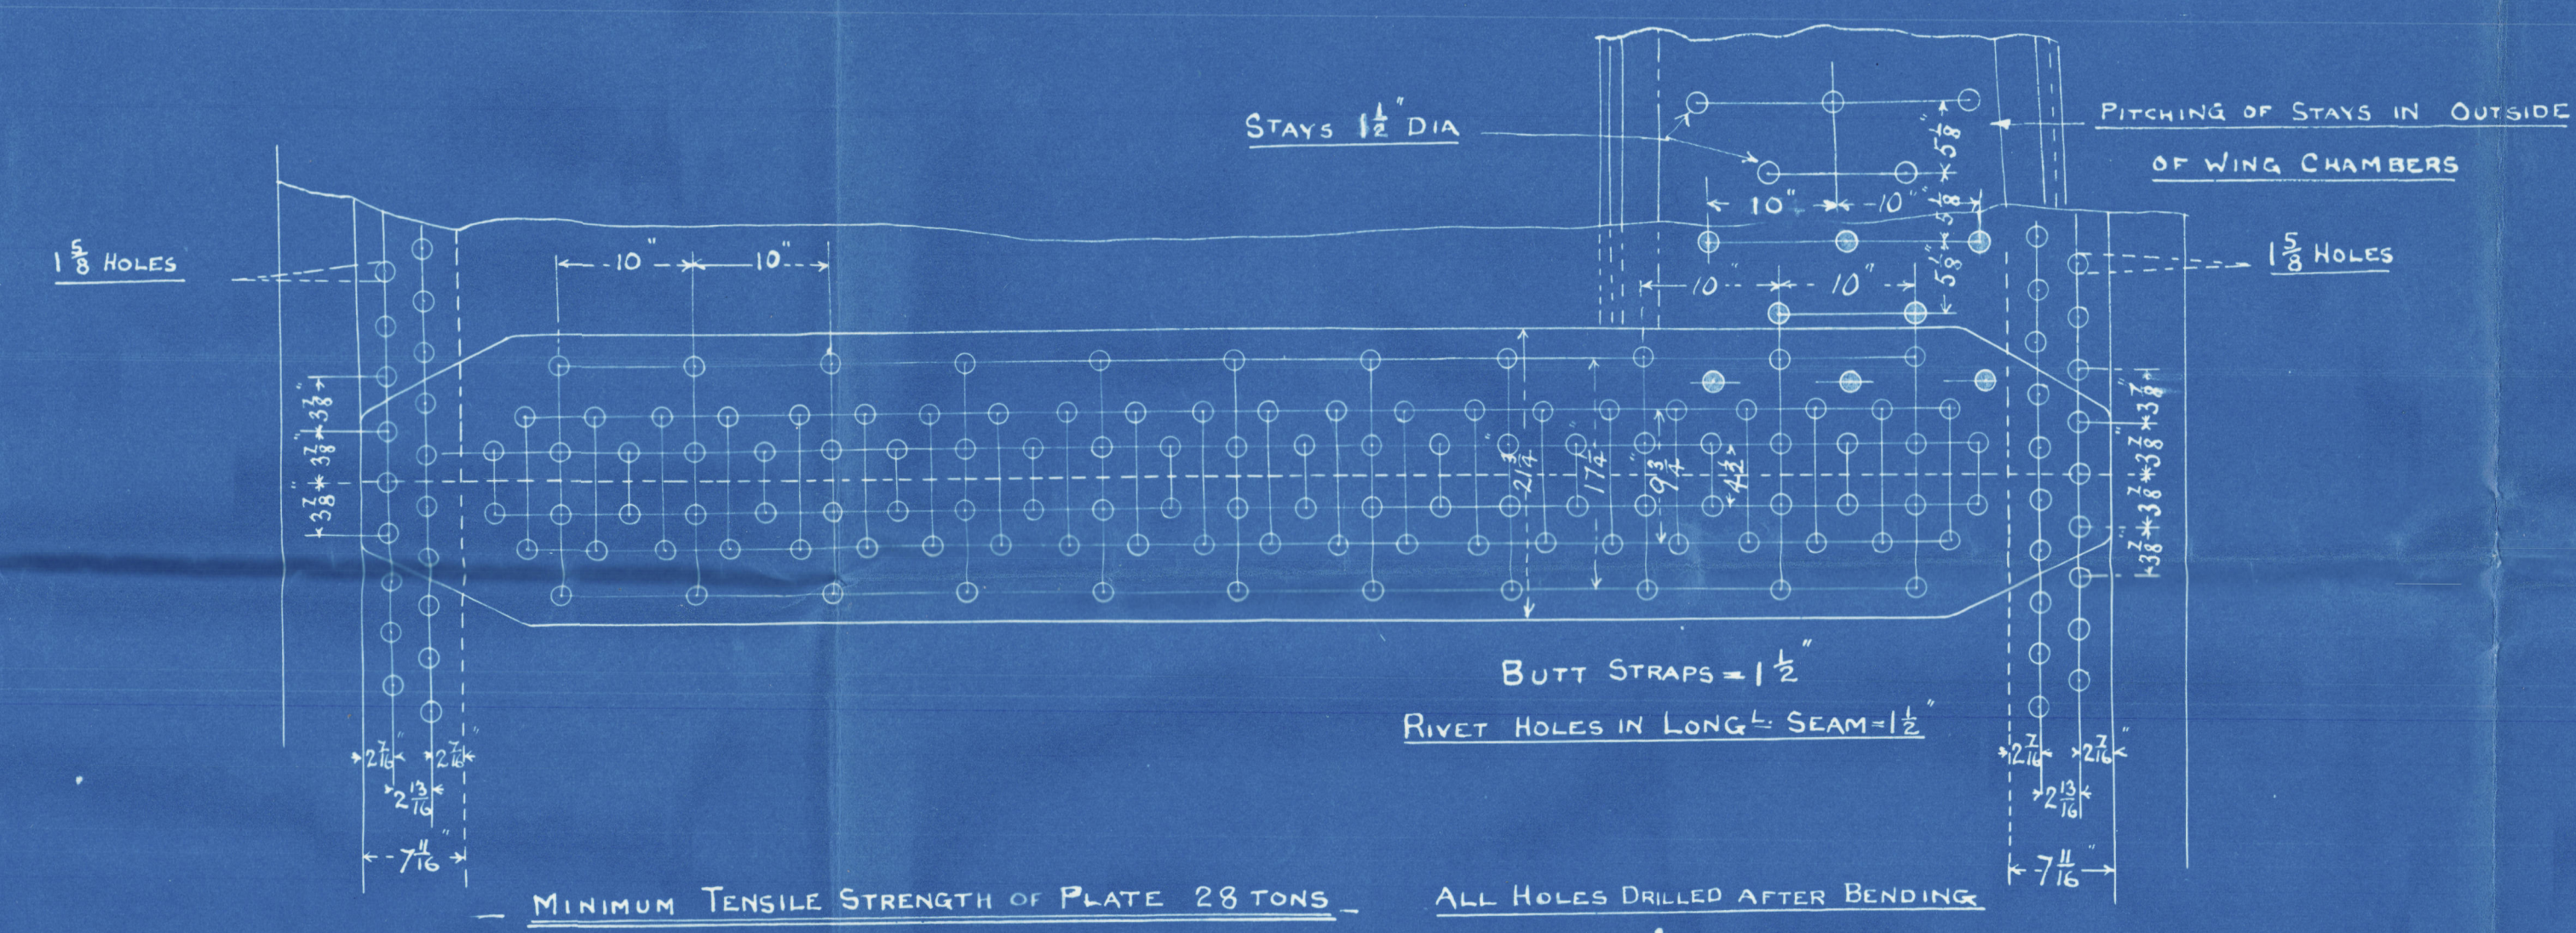

WORKING PRESSURE 200 LBS per D
TESTING " 400 " " " TO LLOYD'S AND HAMBURG POLICE LAWS

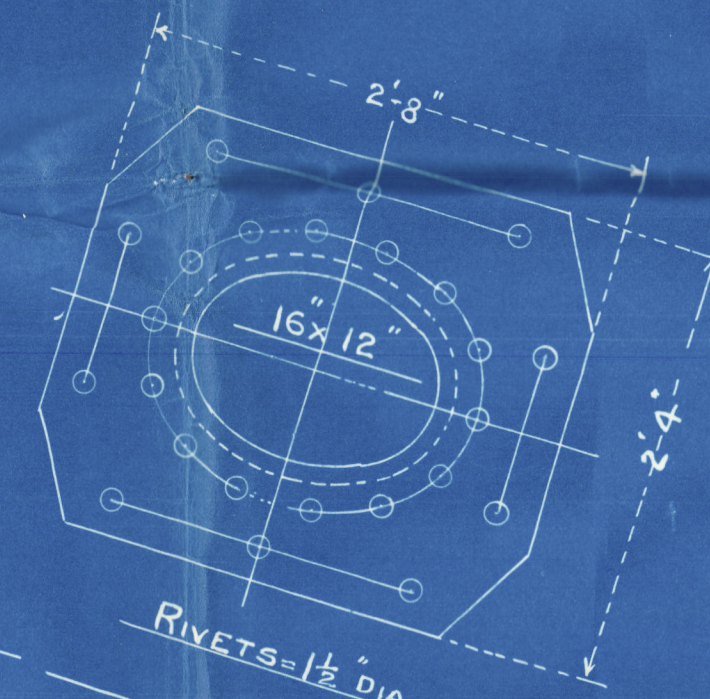

MAIN BOILER No 445
SCALE 1" = 1 FOOT
- 30FF - 88/11
10.2.05
10.2.05

Also
R.S.P.
R.D.
7.2.05



D. W. Henderson & Co.

No 445-

"Ashburton"

fls. npt. no. 22989

W970-0138



RETAIR



© 2020

Lloyd's Register
Foundation