



MR NEIL'S COMPENSATING RING
AND DOOR

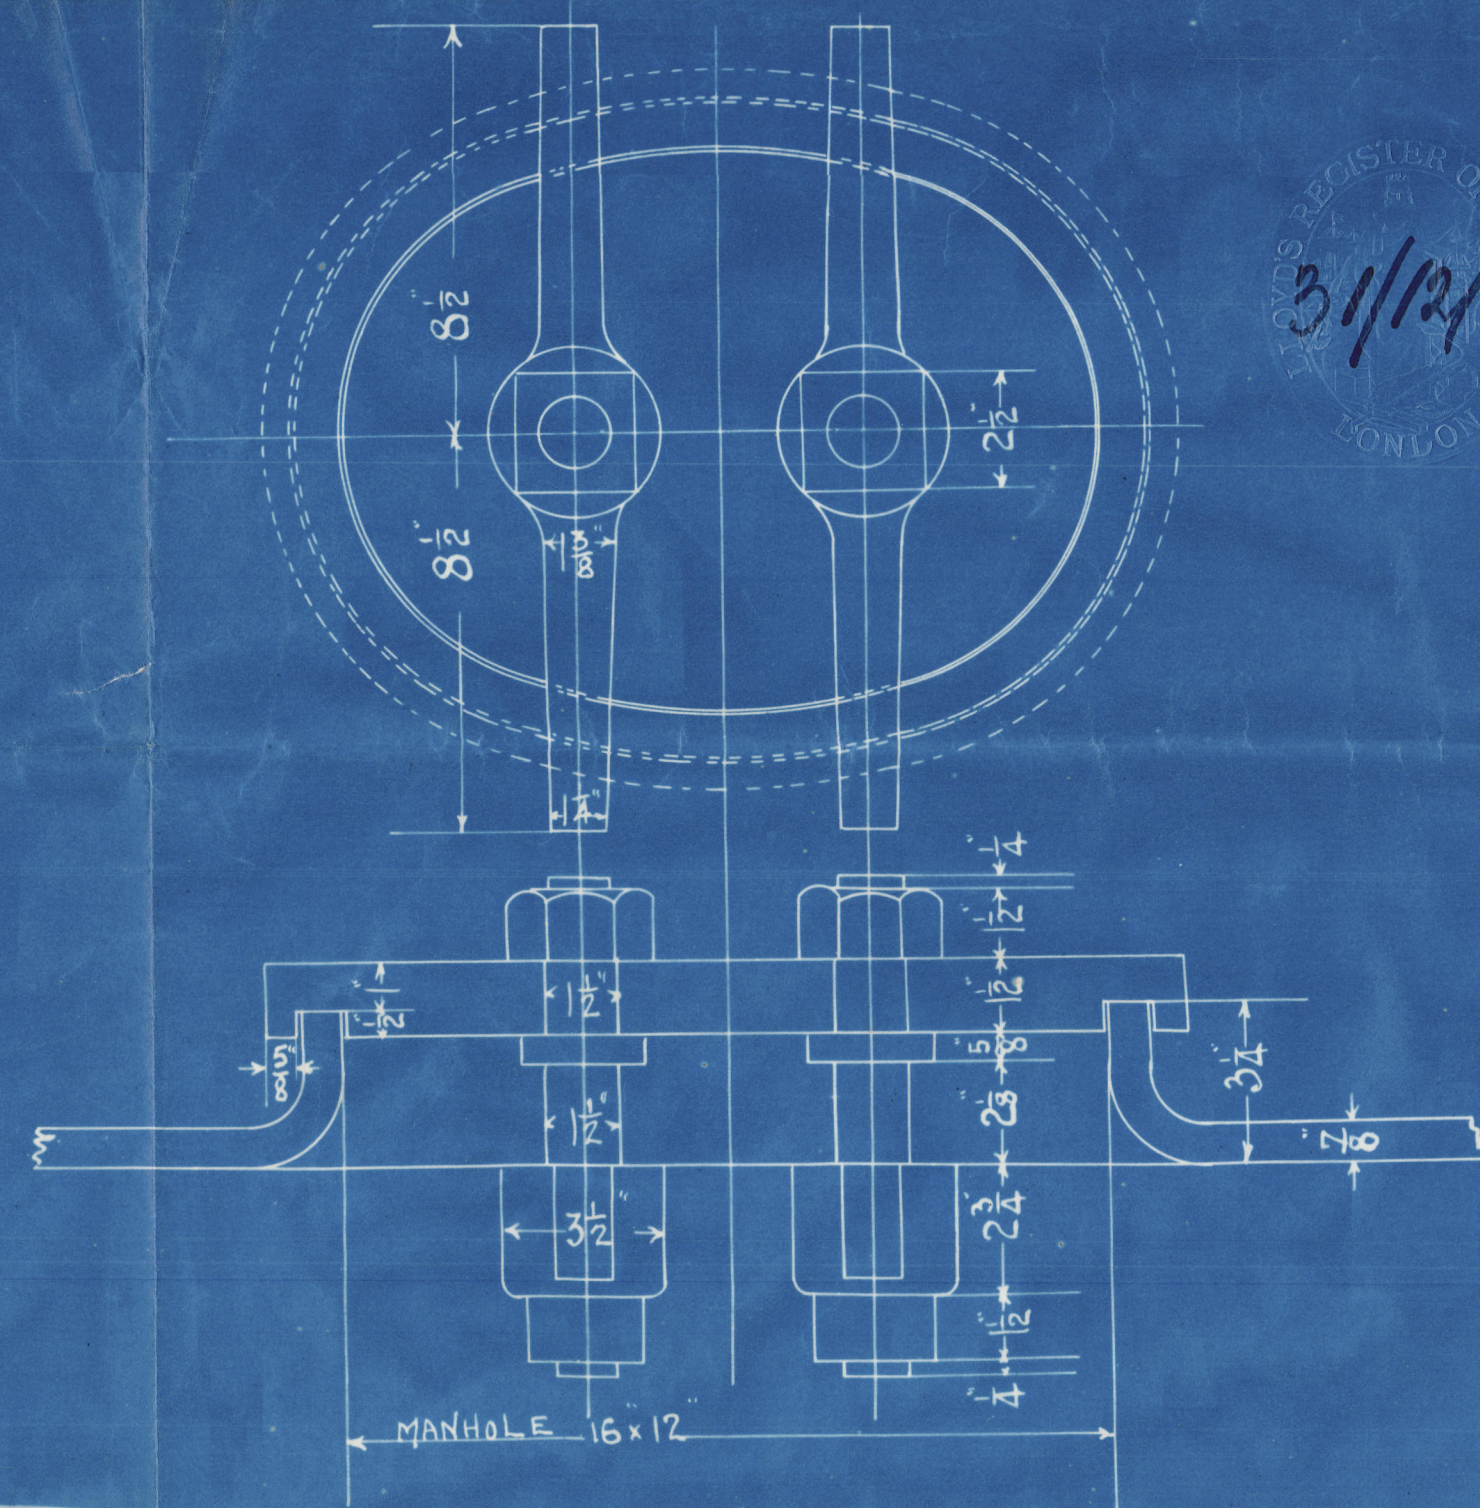




31/12/09

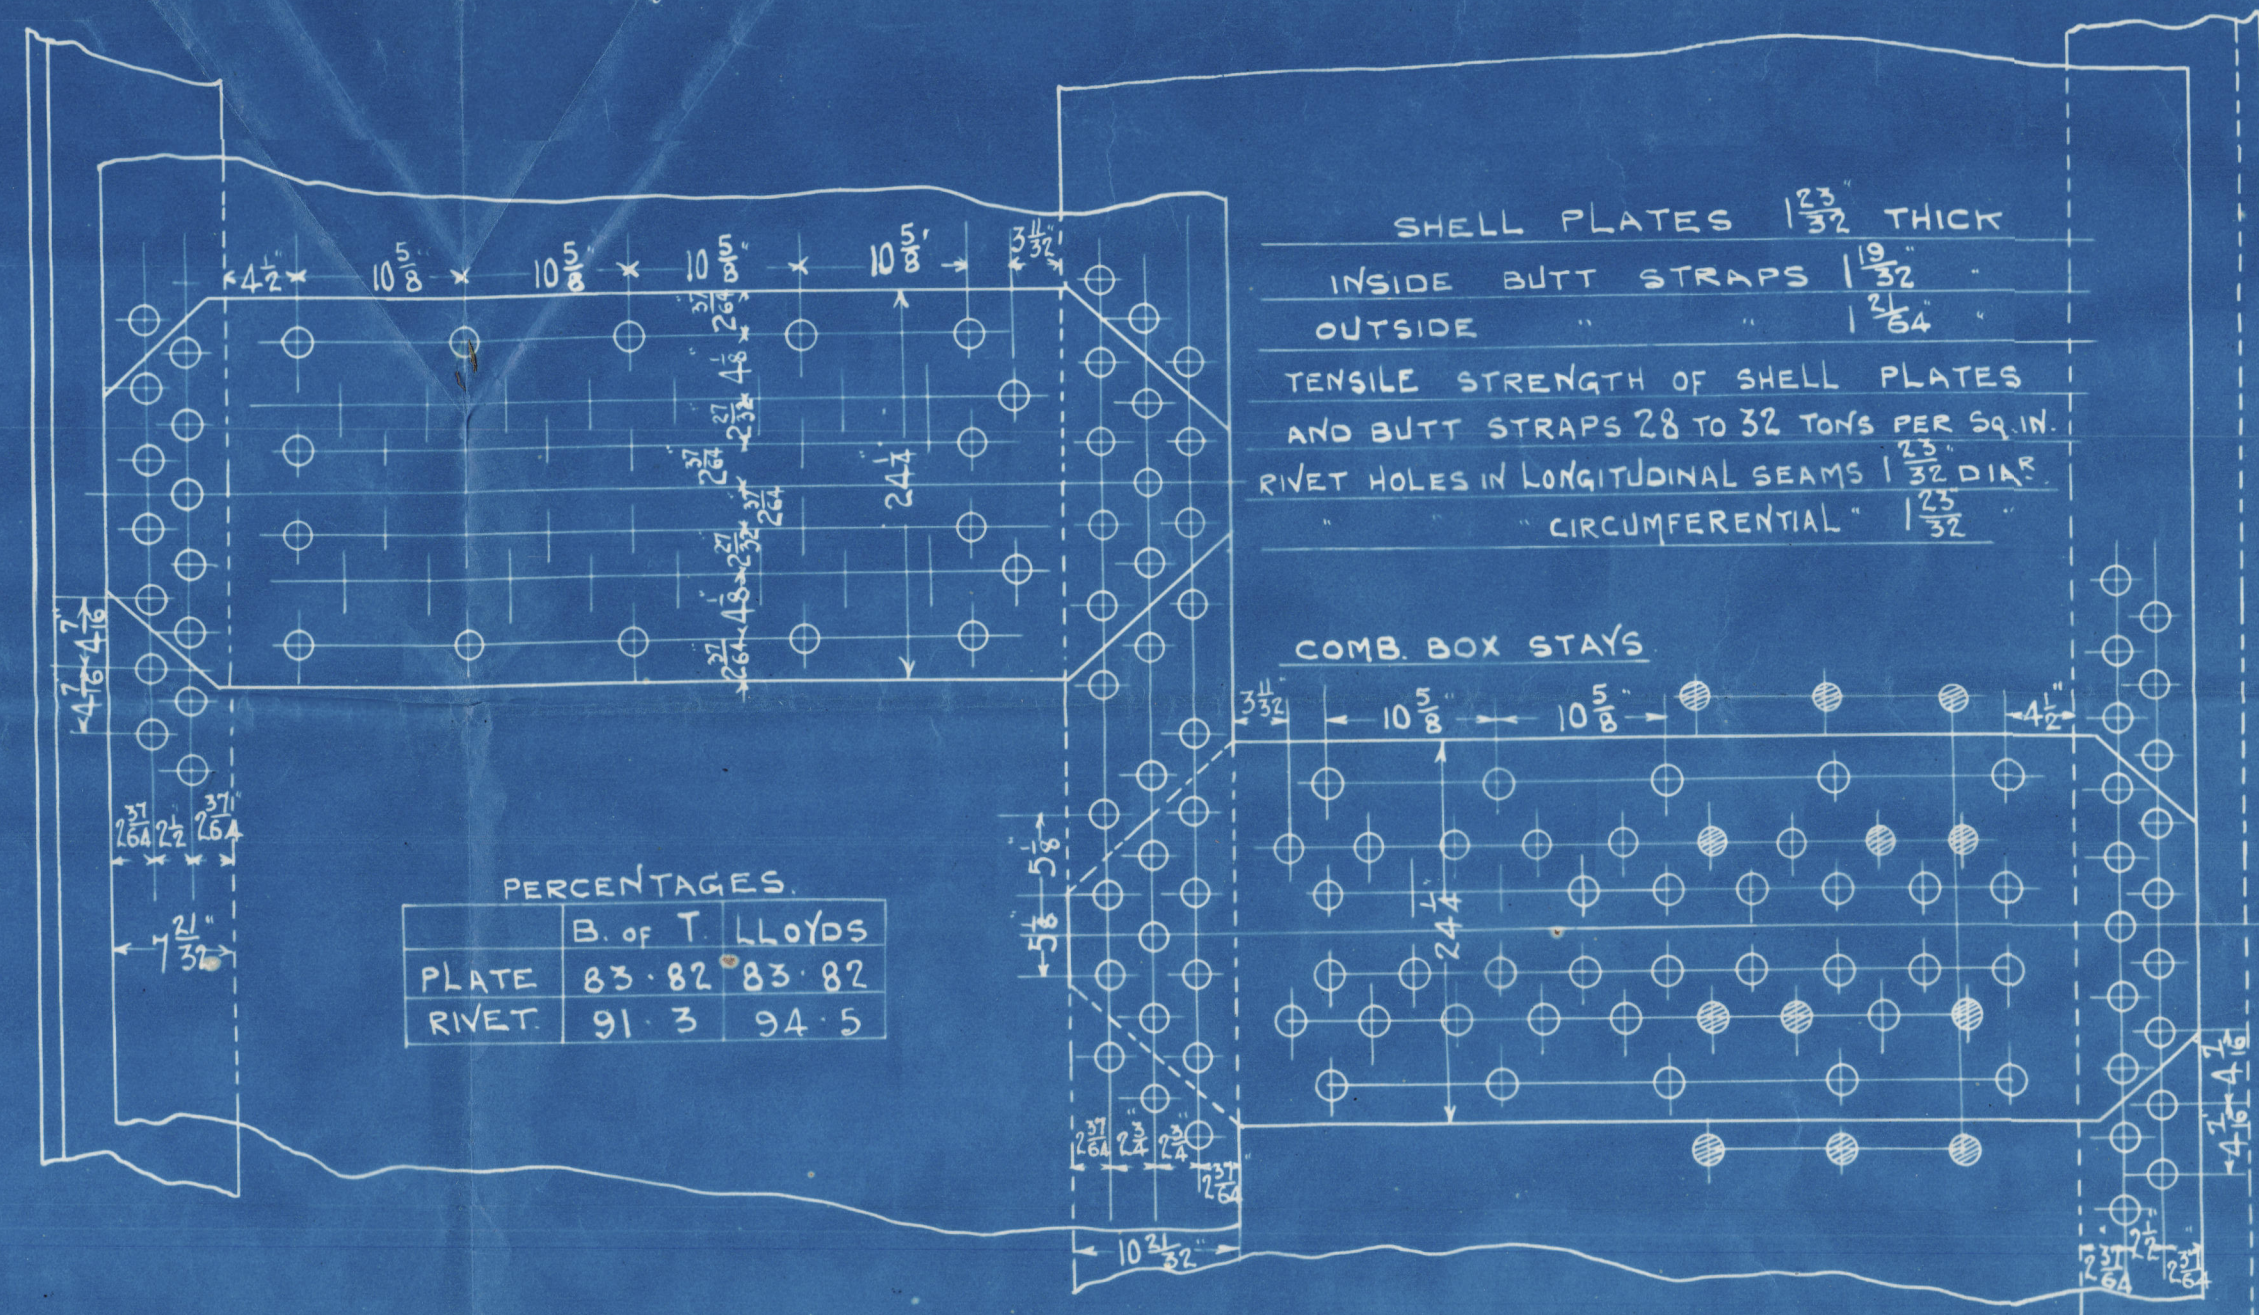

PERCENTAGES

PLATE	83.82	83.82
RIVET	91.3	94.5

HEATING SURFACE	
412 TUBES 2 1/2" DIA	2107
COMB. CHAM. SIDES	212
" " BACK	91
BACK TUBE PLATES	180
FURNACES	180
TOTAL	2682
GRATE SURFACE	67.82
LENGTH OF FIRE BAR	5.6
HEATING SURF IN 4 BOILERS	10728
GRATE	271.28
RATIO OF GRATE TO HEATING SURF	39.846
WEIGHT OF 1 BOILER	✓
" " WATER IN 1 BOILER	✓

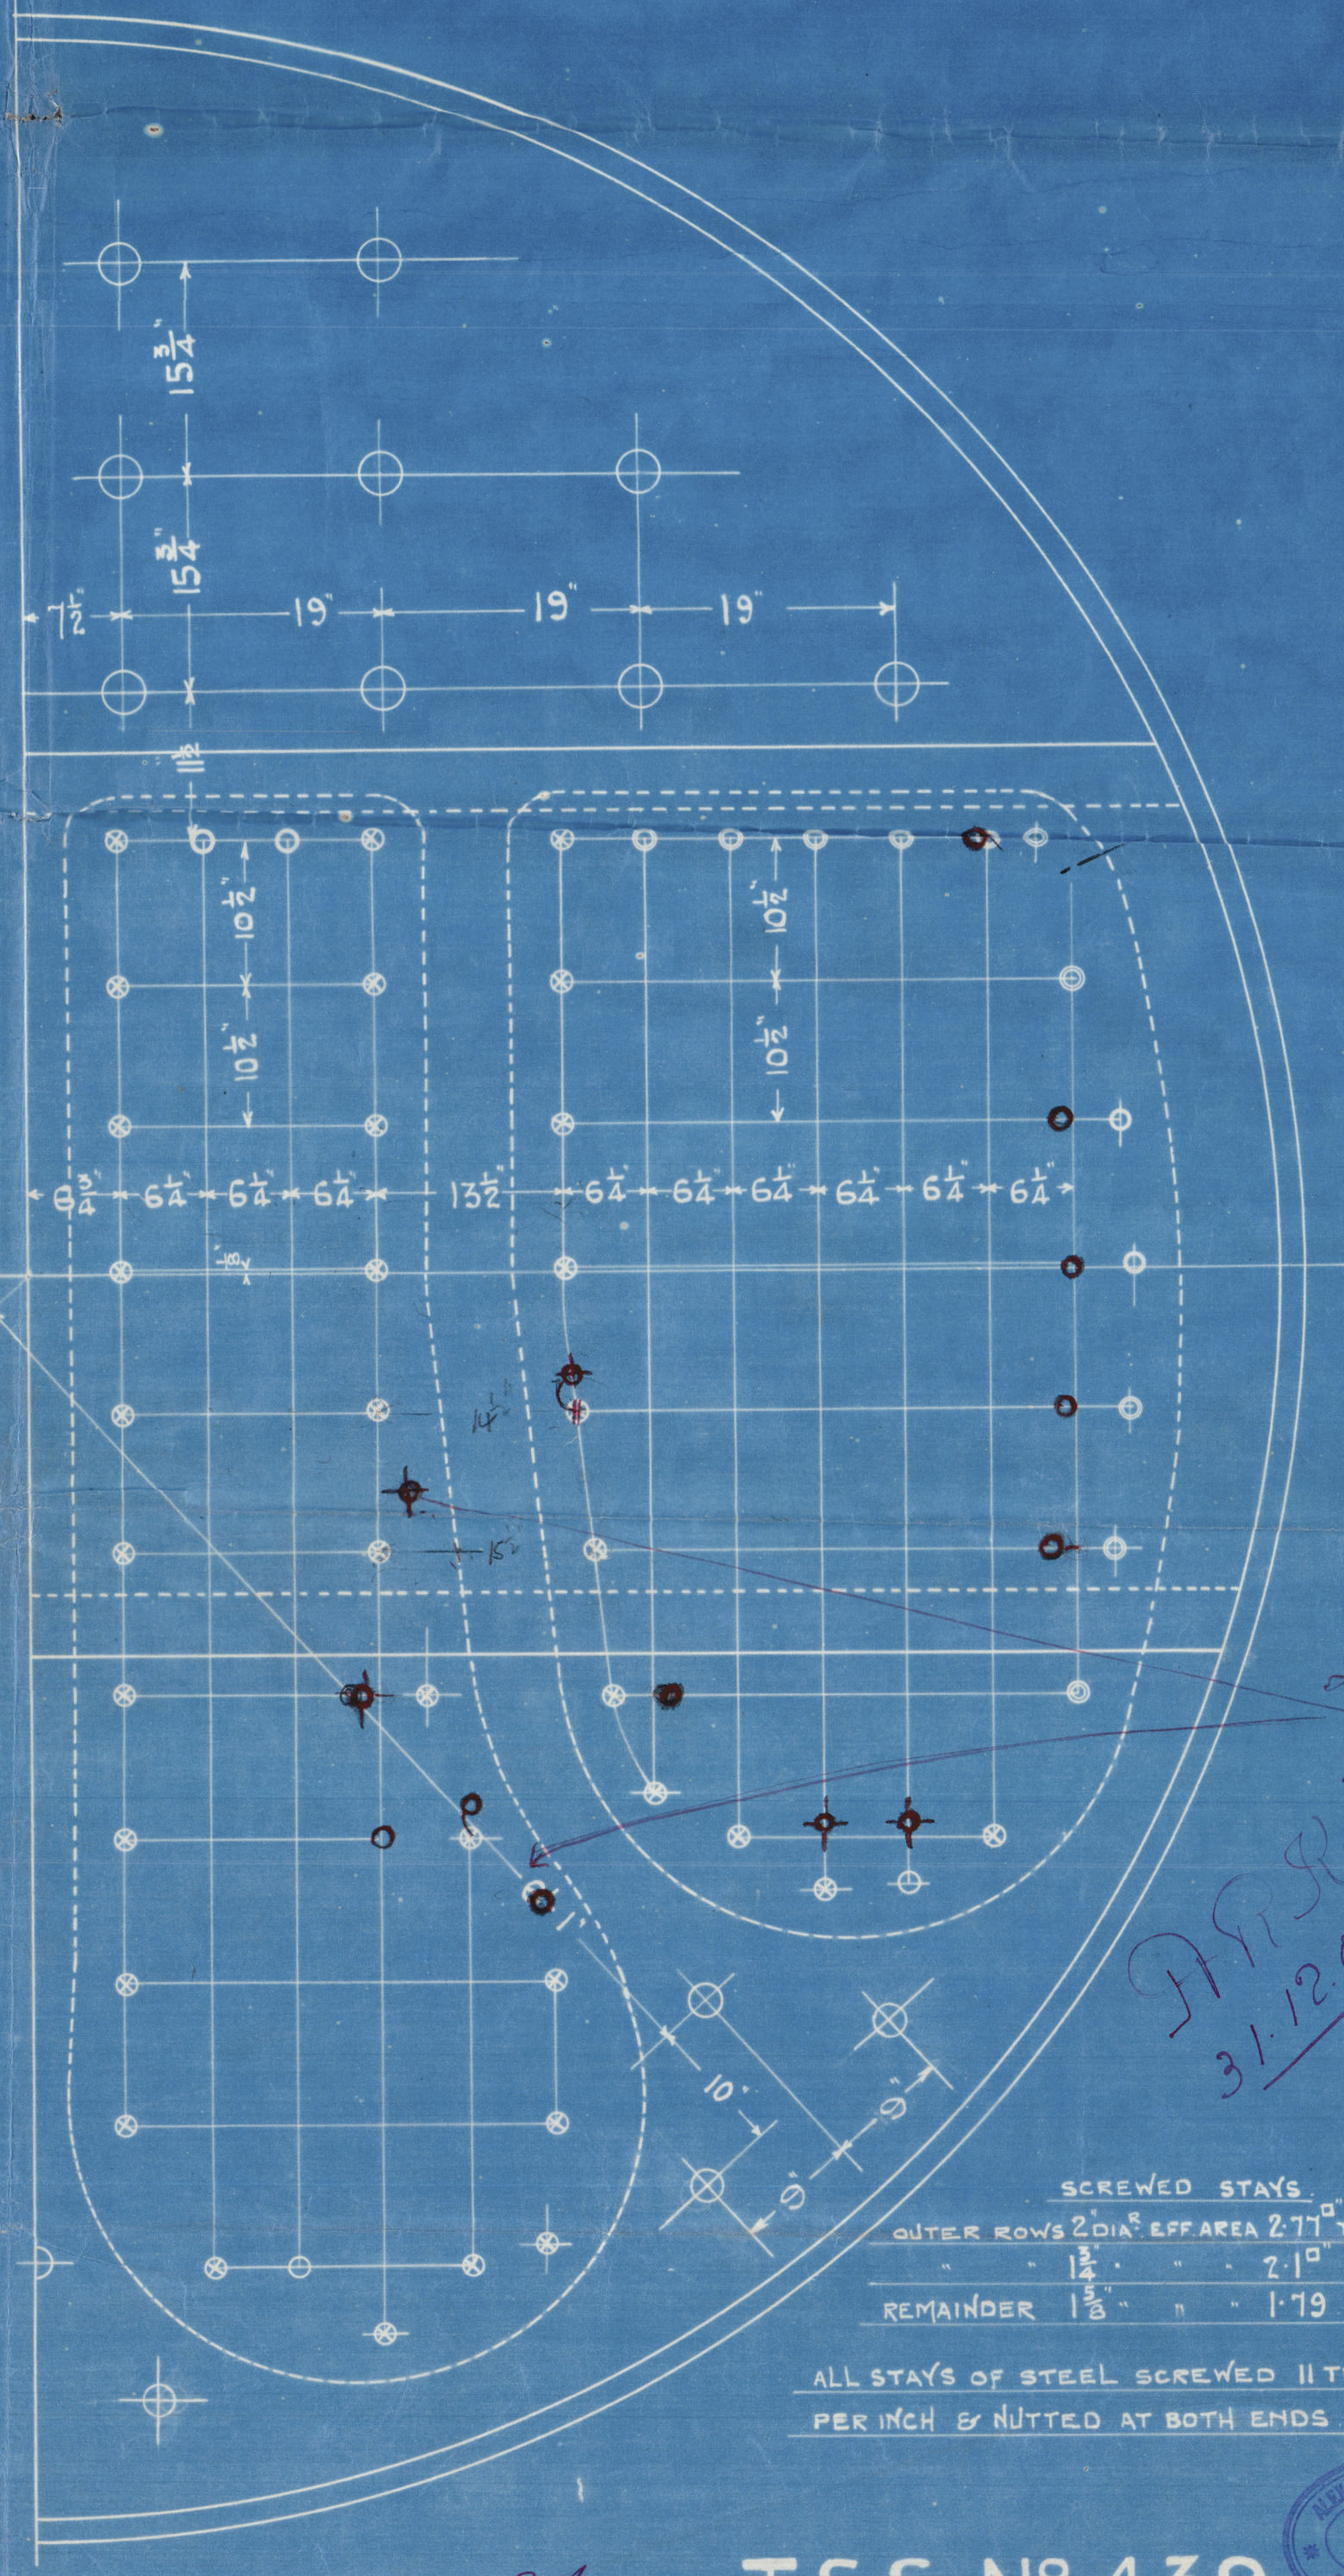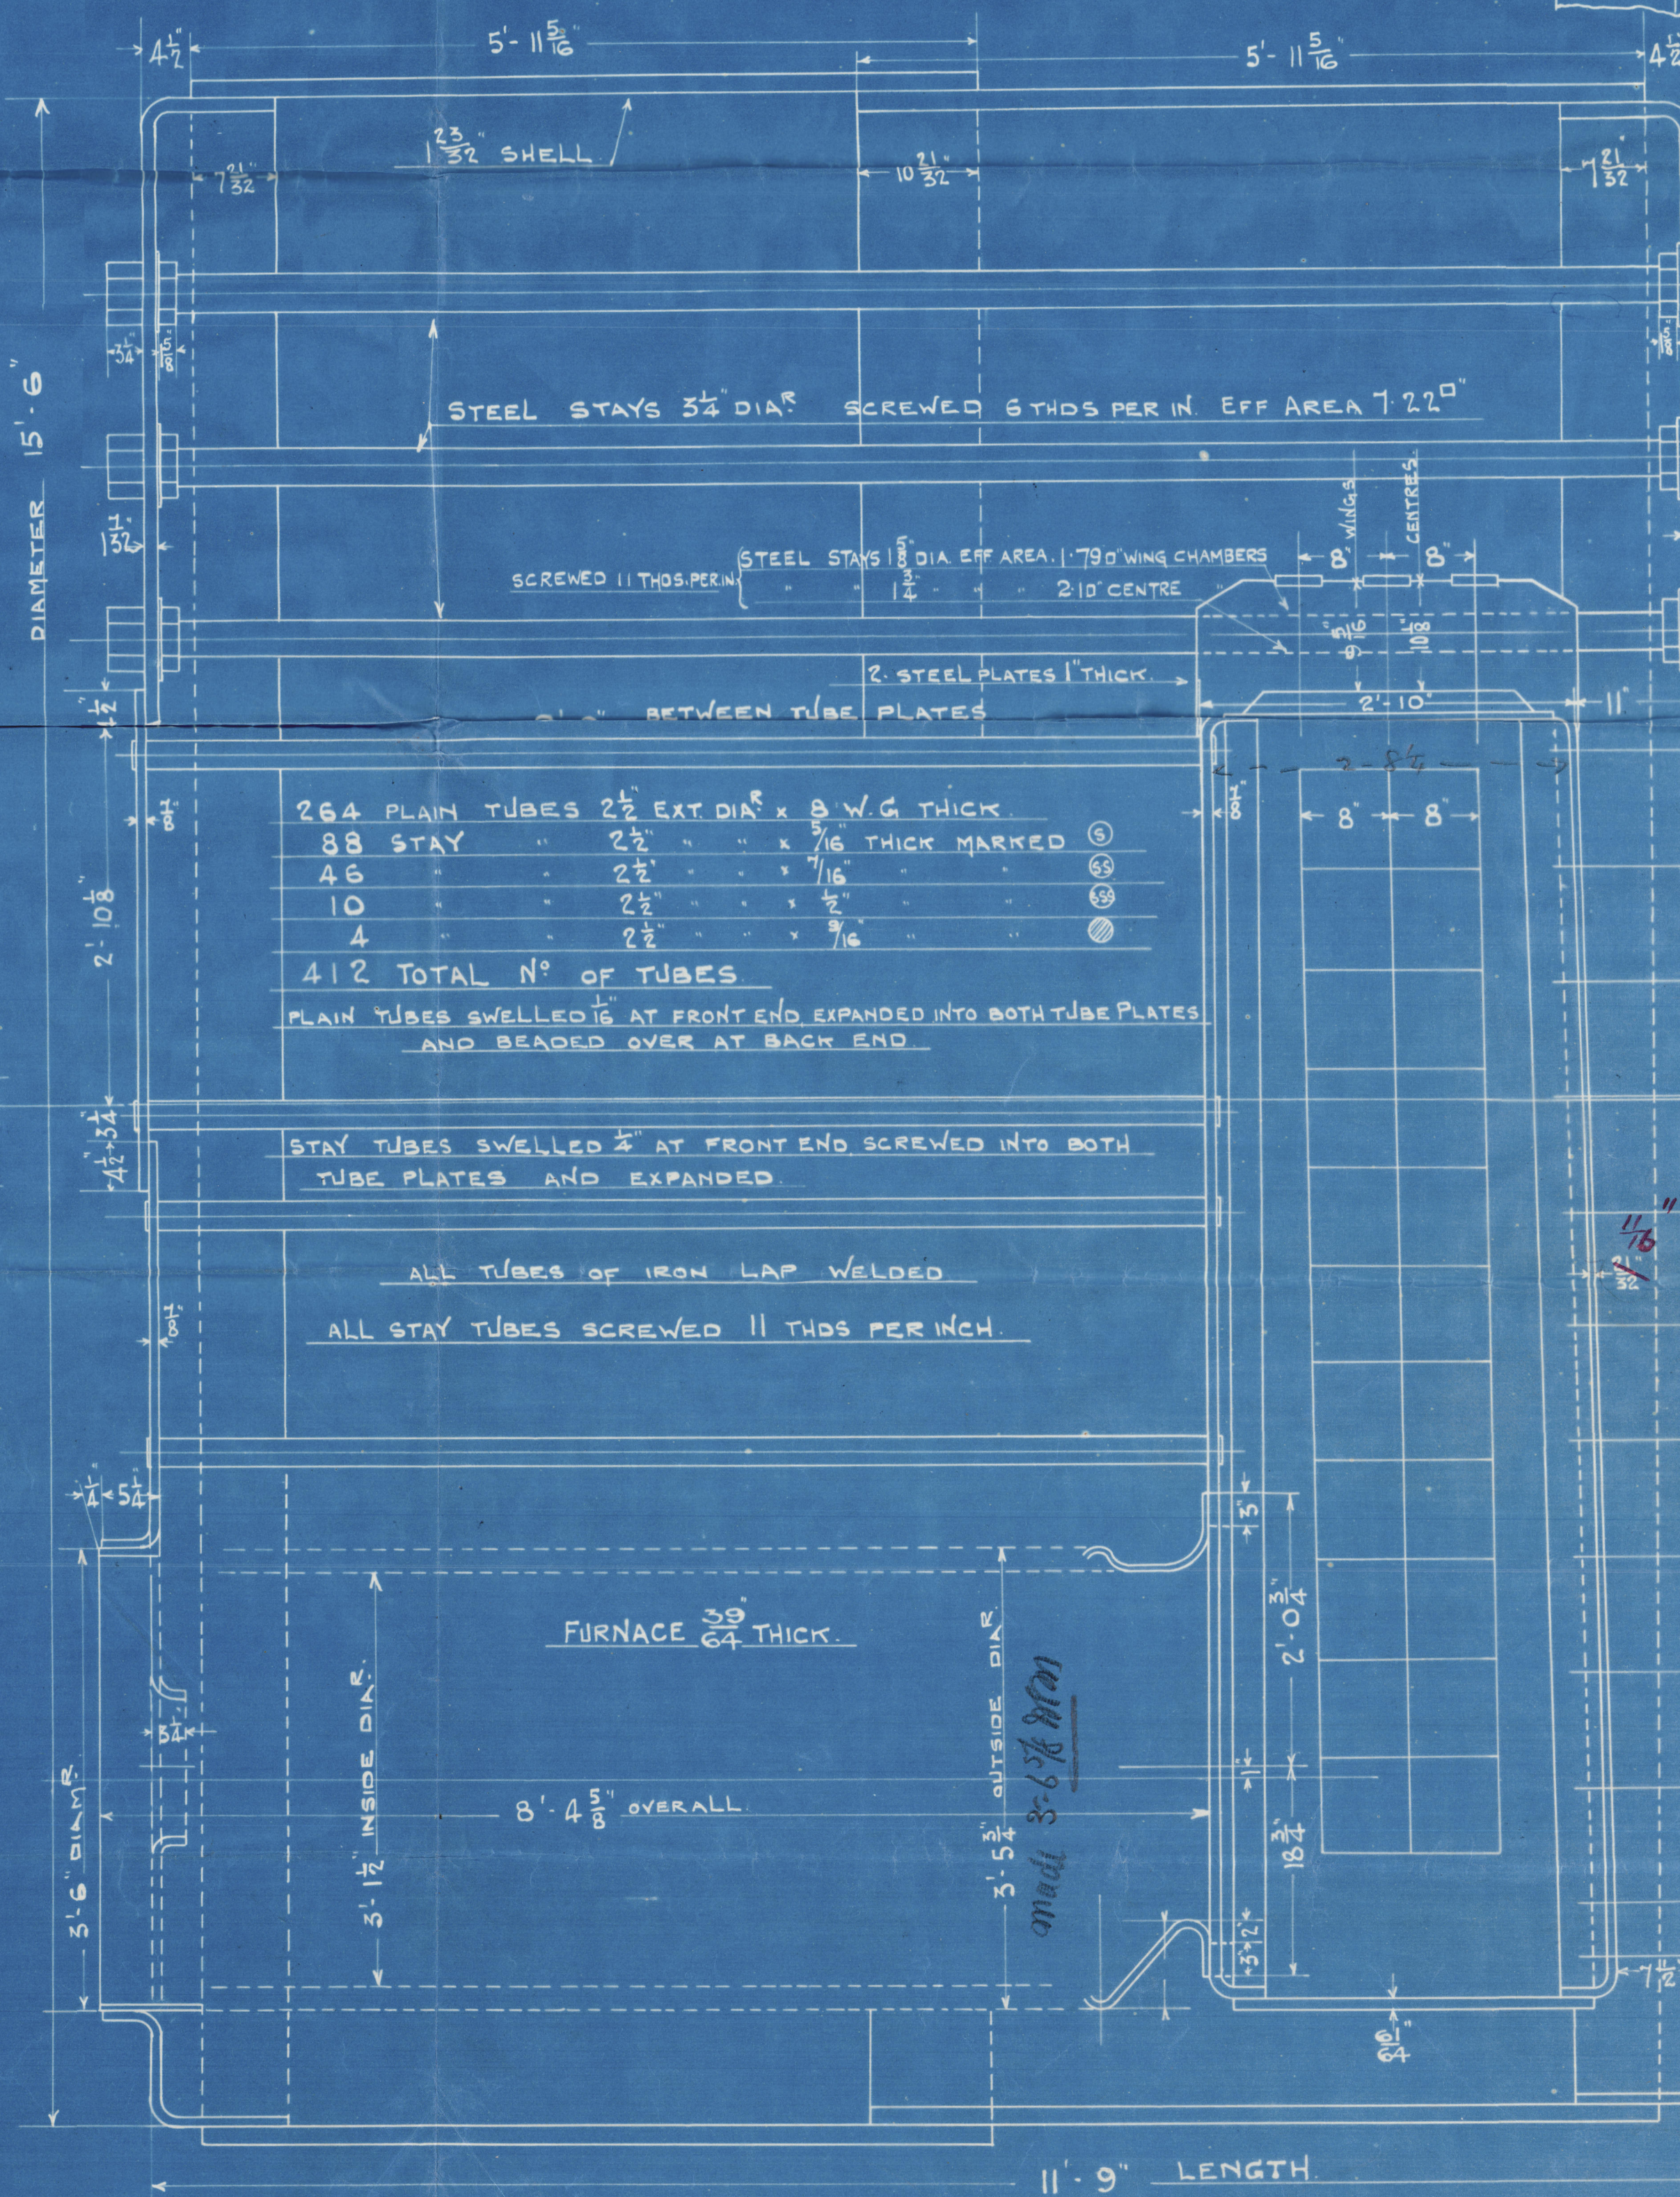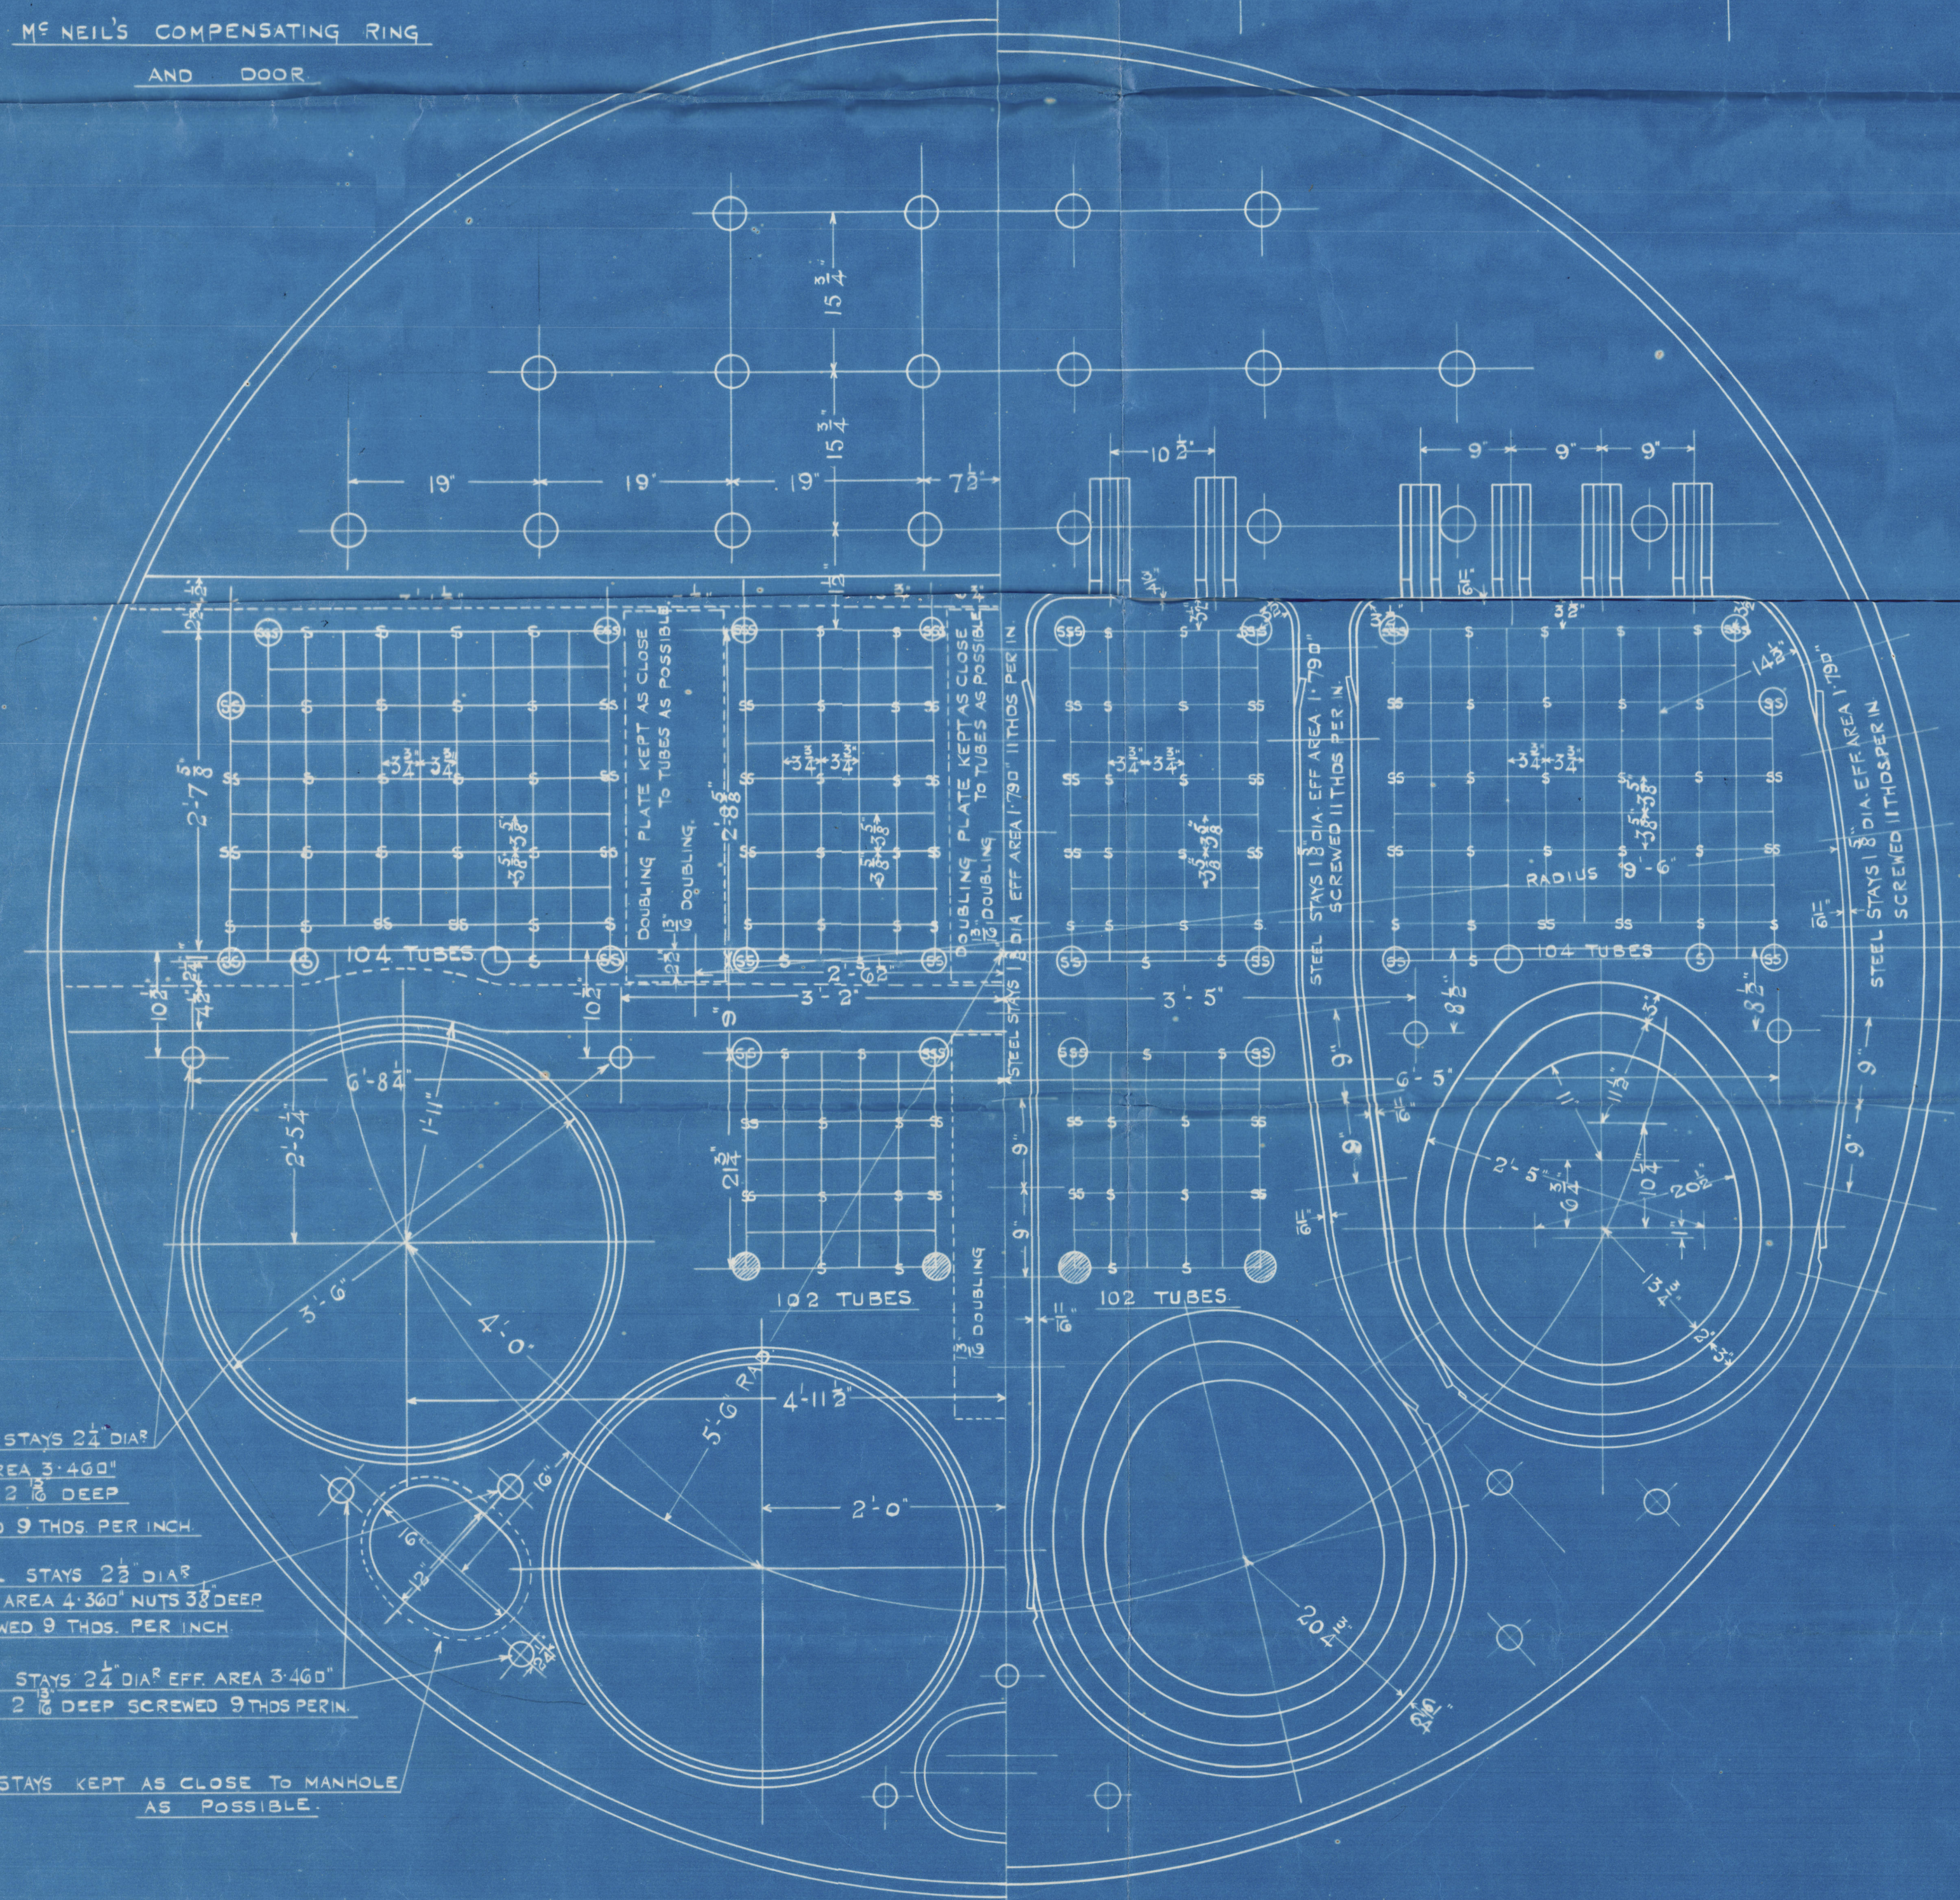

And add screw
stays to front of
this inside.

31/12/09

WORKING PRESSURE 215 LBS PER SQ. INCH.
TO BE TESTED TO 430 LBS PER SQ. INCH. TO
BOARD OF TRADE & LLOYDS REQUIREMENTS.

4 OFF.

T.S.S. N° 439
MAIN BOILER.
SCALE 1" = 1 FOOT.

Lloyd's Register
Foundation
1971-0025




A. STEPHEN & SONS LTD

MAIN BOILER (2 off)



T.S.S. No 439

WORKING PRESSURE

215 LBS.

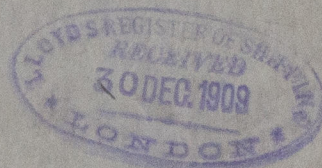

GLASGOW REPORT No. 29453

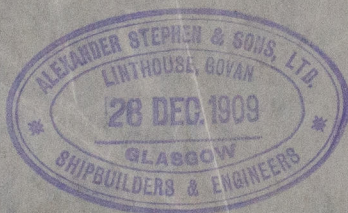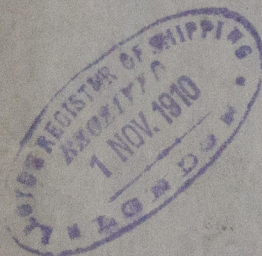

RETAIN

© 2021

Lloyd's Register
Foundation