

22.3.05


# No 497 PROFILE AND DECK PLAN

DIMS. 146'-8" x 23'-1 1/2" M<sup>LD</sup> x 12'-0 1/2" M<sup>LD</sup>.

TO CLASS 100 A.I. STEEL.

FOR FISHING PURPOSES.

SCALE 1/4" = 1 FOOT.

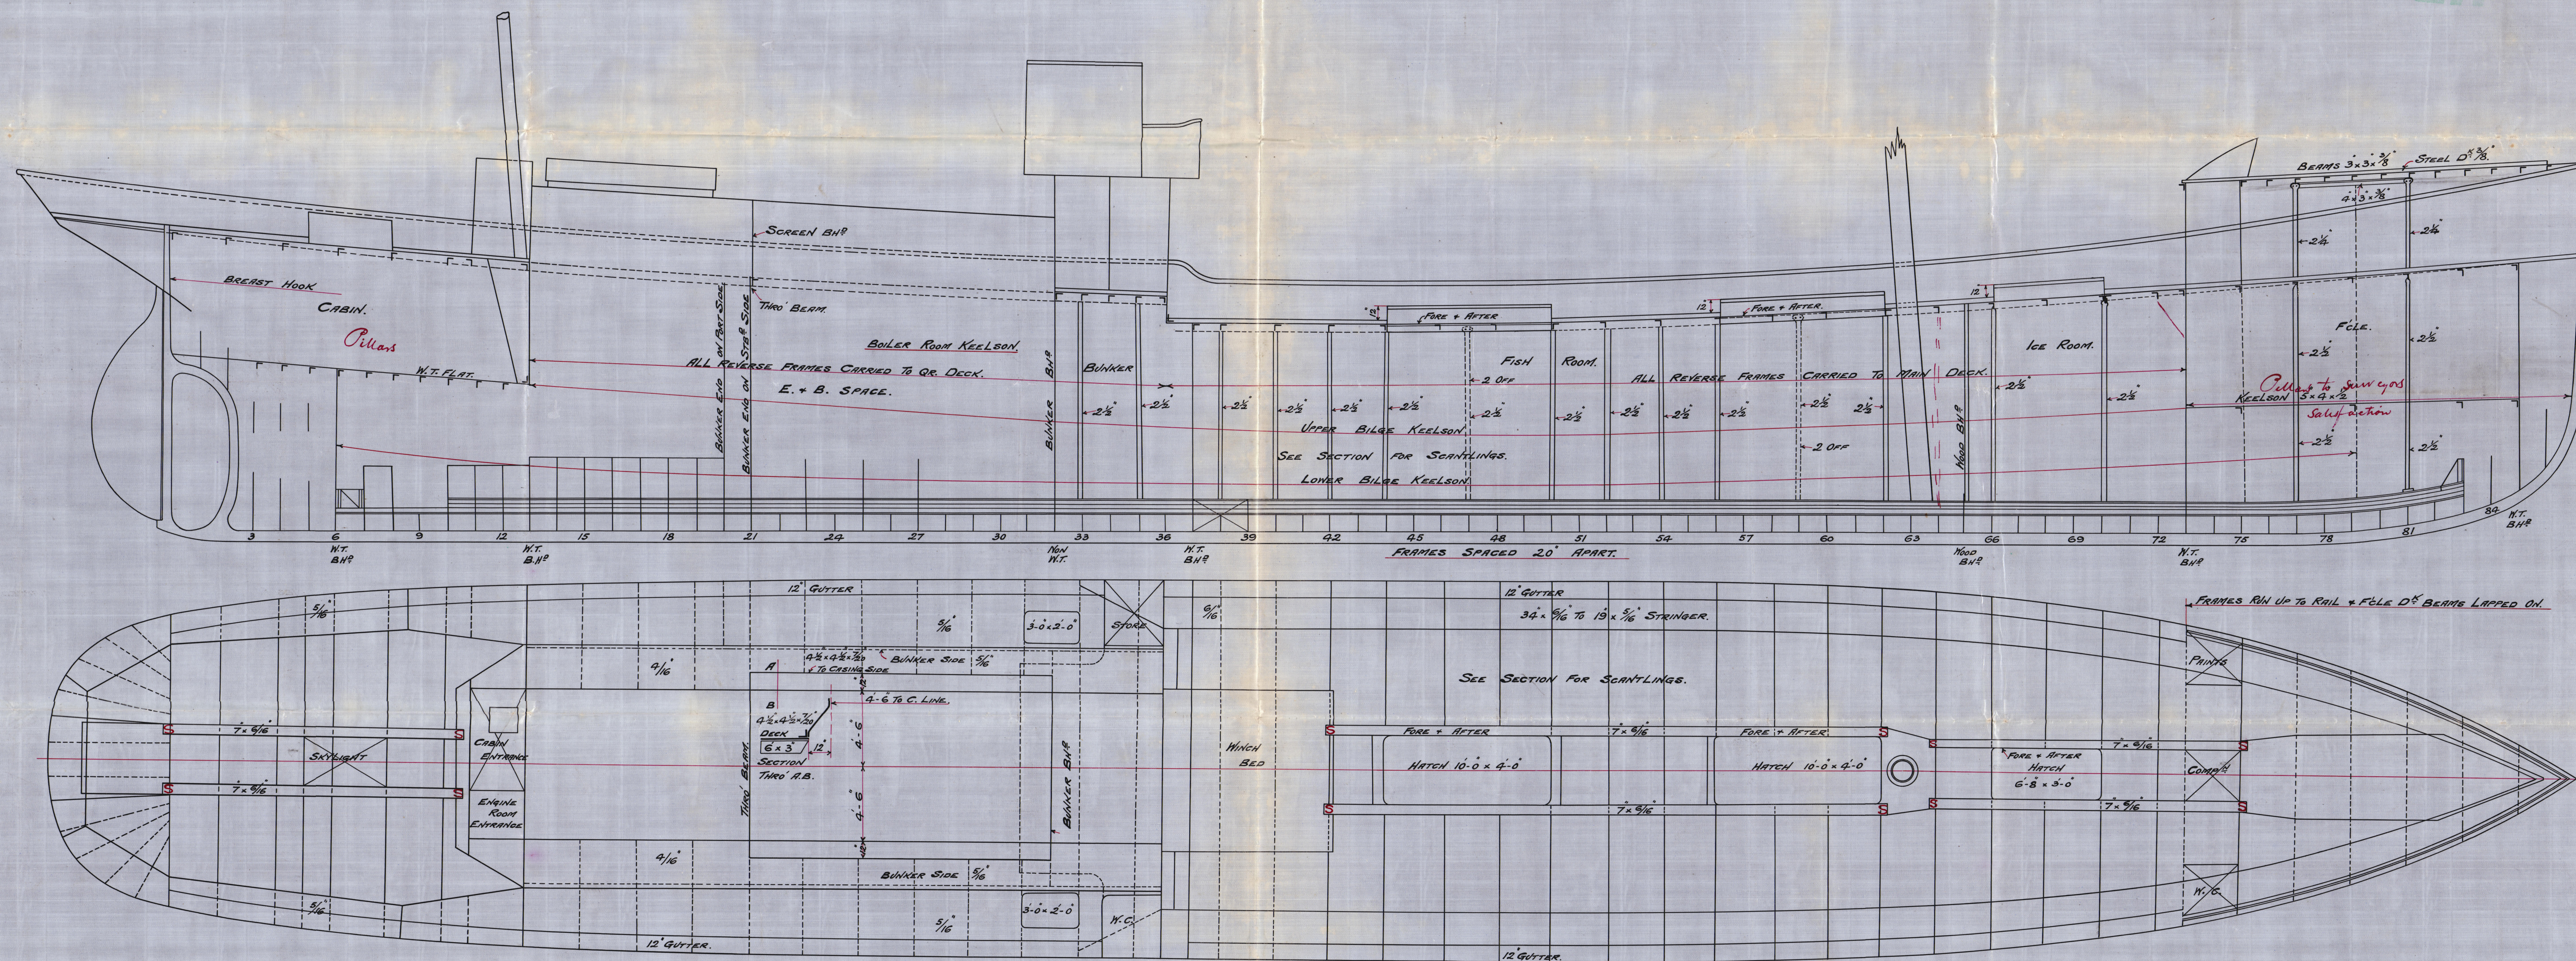



Earle's S. & E. Co., Ltd.

Nº 497.


Profile + Deck.

RETAIN

S/S Asia

Hull Report No. 17243

RETAIN

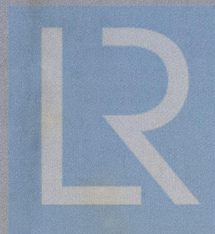

© 2021

Lloyd's Register  
Foundation

L971-0166