


14.12.05
1.1.06
(27.4.06)

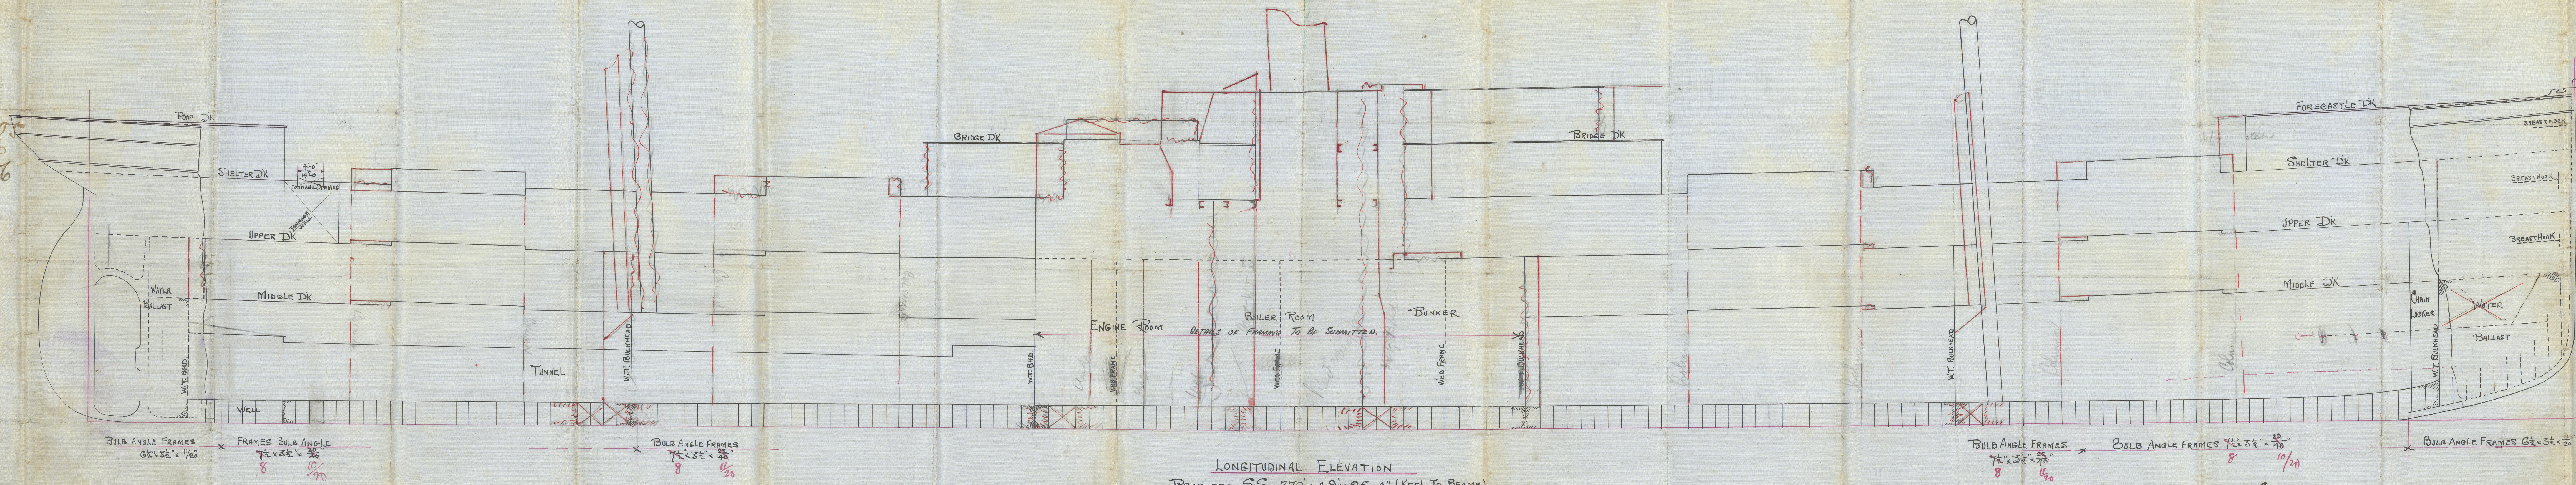

LONGITUDINAL ELEVATION
PROPOSED S.S. 370' x 49' x 25'-4" (KEEL TO BEAMS).


SCALE 1/8" = 1 FOOT.
Nos 383 & 4.

C.B.
27.4.06.

STAM

15.1.80
15.1.80
15.1.80

W472-0108

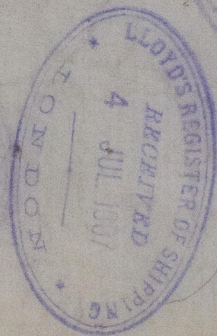

Harland & Wolff

SS 383 - 384
~~386 & 387~~

© 2020 Amended profile

3 Lloyd's Register
384 Lima Leone

0240
6250