
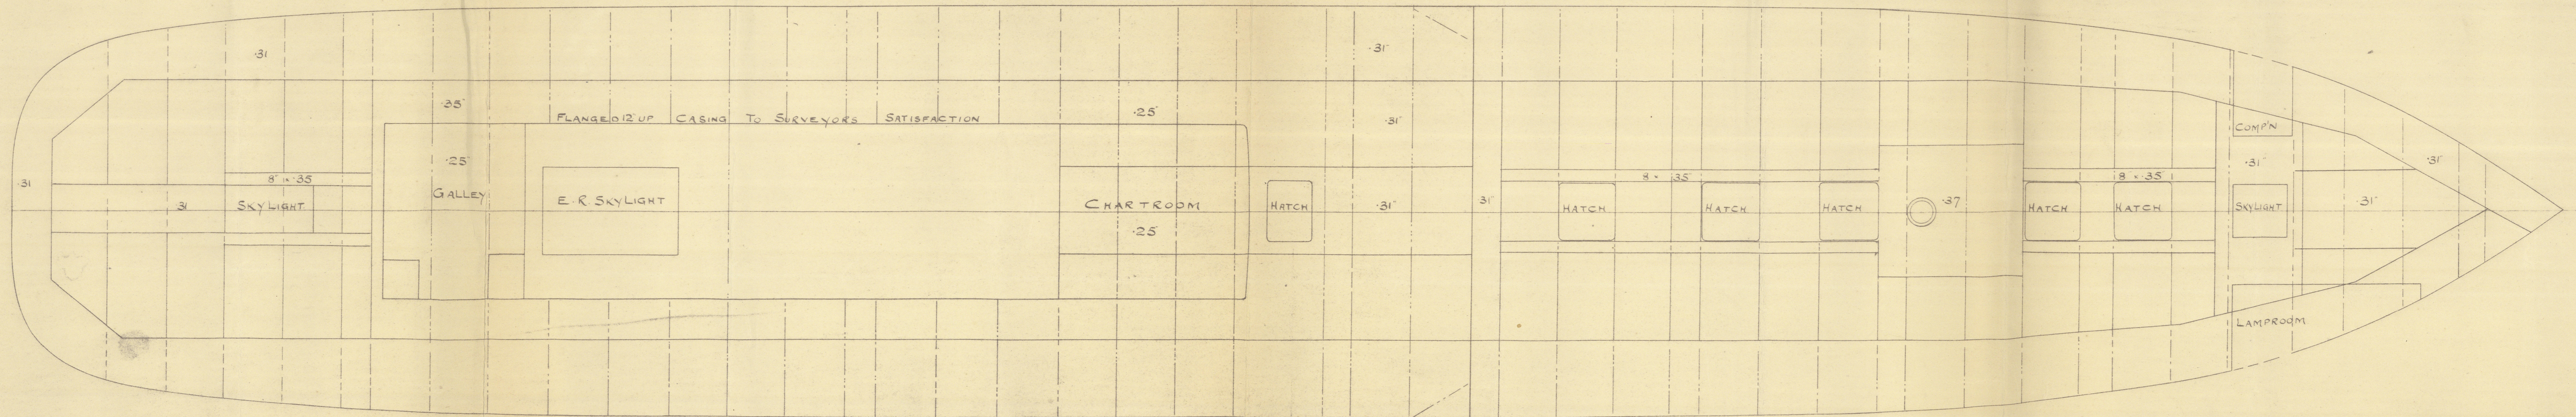


16.6.14

PROFILE & DECK PLAN  
STEEL SCREW TRAWLER

N<sup>os</sup> 621-2  
TO CLASS 100 A1 STEAM TRAWLER  
DIMS: 140'-0" BP x 24'-0" EXT x 13'-3" MLD.

PLAN No. 4418  
FOR ENCLOSURE TO  
MESSRS. LLOYD'S SURVEYORS  
FROM  
COCHRANE & SONS, LTD.  
SHIPBUILDERS, SELBY  
DATE 8/6/14

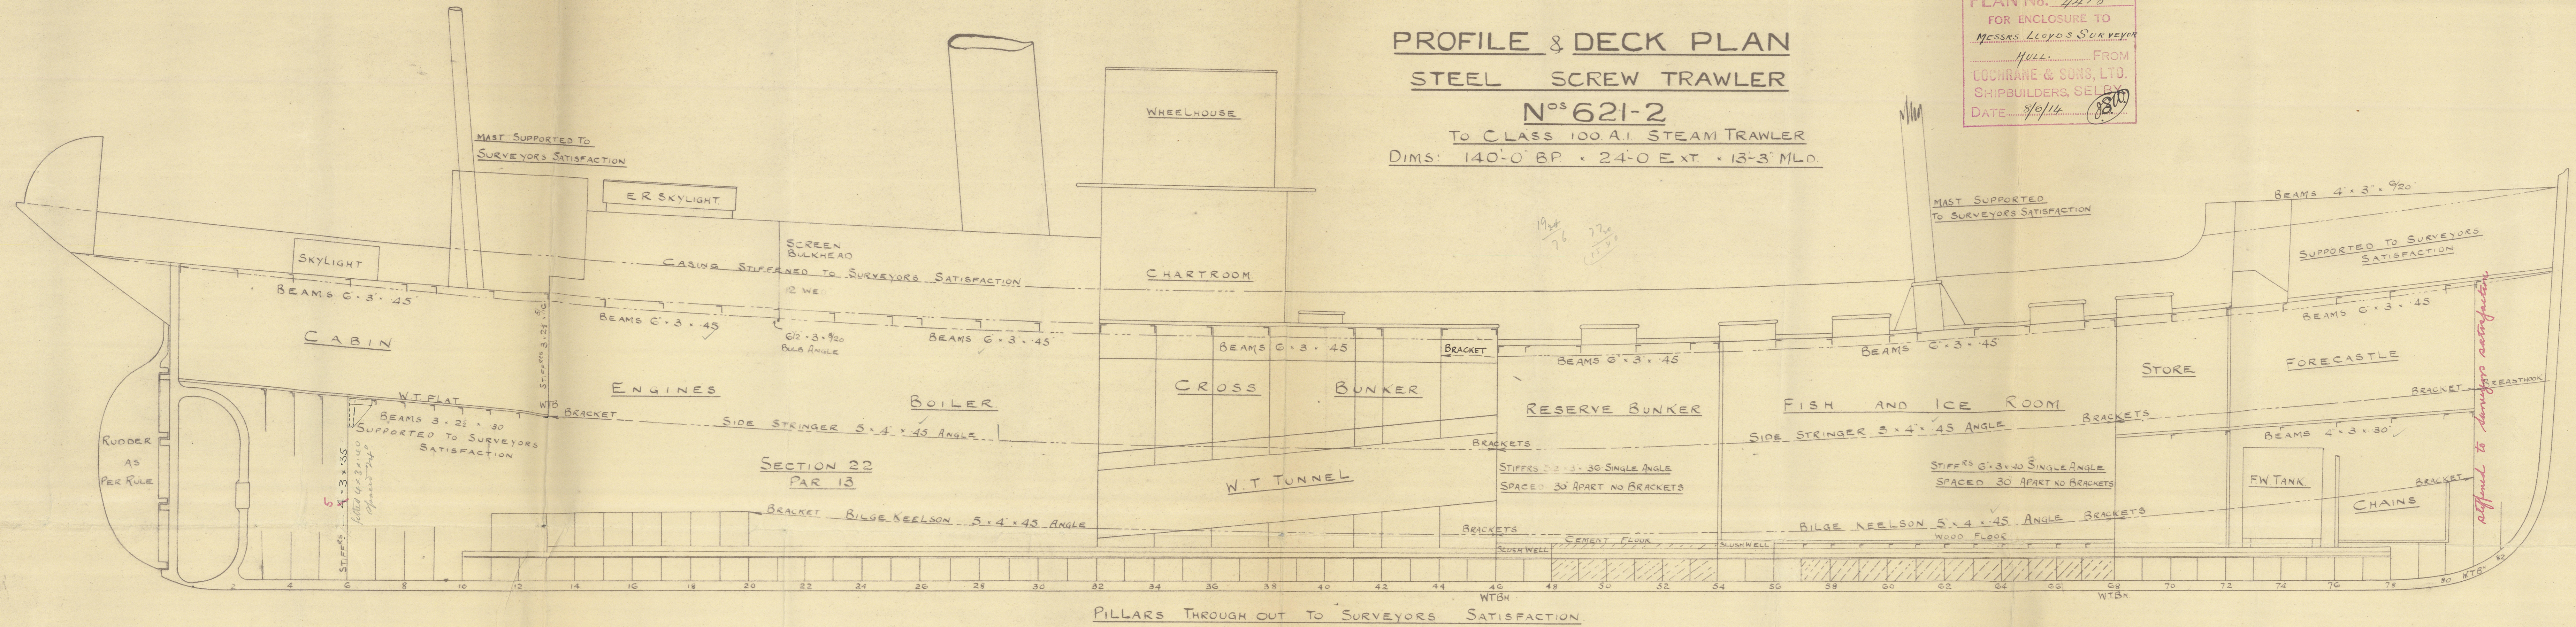

Ct.  
15.6.14


W972-0129

Cochrane's Nos 621-2.

Profile + Deck.



s/s "Acantha" Hull Rpts. no.  
28195.

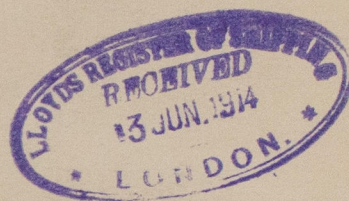

RETAIN



© 2020

Lloyd's Register  
Foundation