

16.6.14

PLAN No. 4420  
FOR ENCLOSURE TO  
MESSRS LLOYDS SURVEYOR  
HULL FROM  
COCHRANE & SONS, LTD.  
SHIPBUILDERS, SELBY  
DATE 8/6/14

# MIDSHIP SECTION STEEL SCREW TRAWLER

N<sup>OS</sup> 621-'2


DIM'S 140'-0 B.P. x 24'-0 Ex x 13'-3 MLD

SCALE 1/2 INCH.

TO CLASS 100A1 - LLOYDS STEAM TRAWLER

DECK PLATED OVER IN WAY OF MACHINERY

ESB CASING AS PREVIOUSLY APPROVED

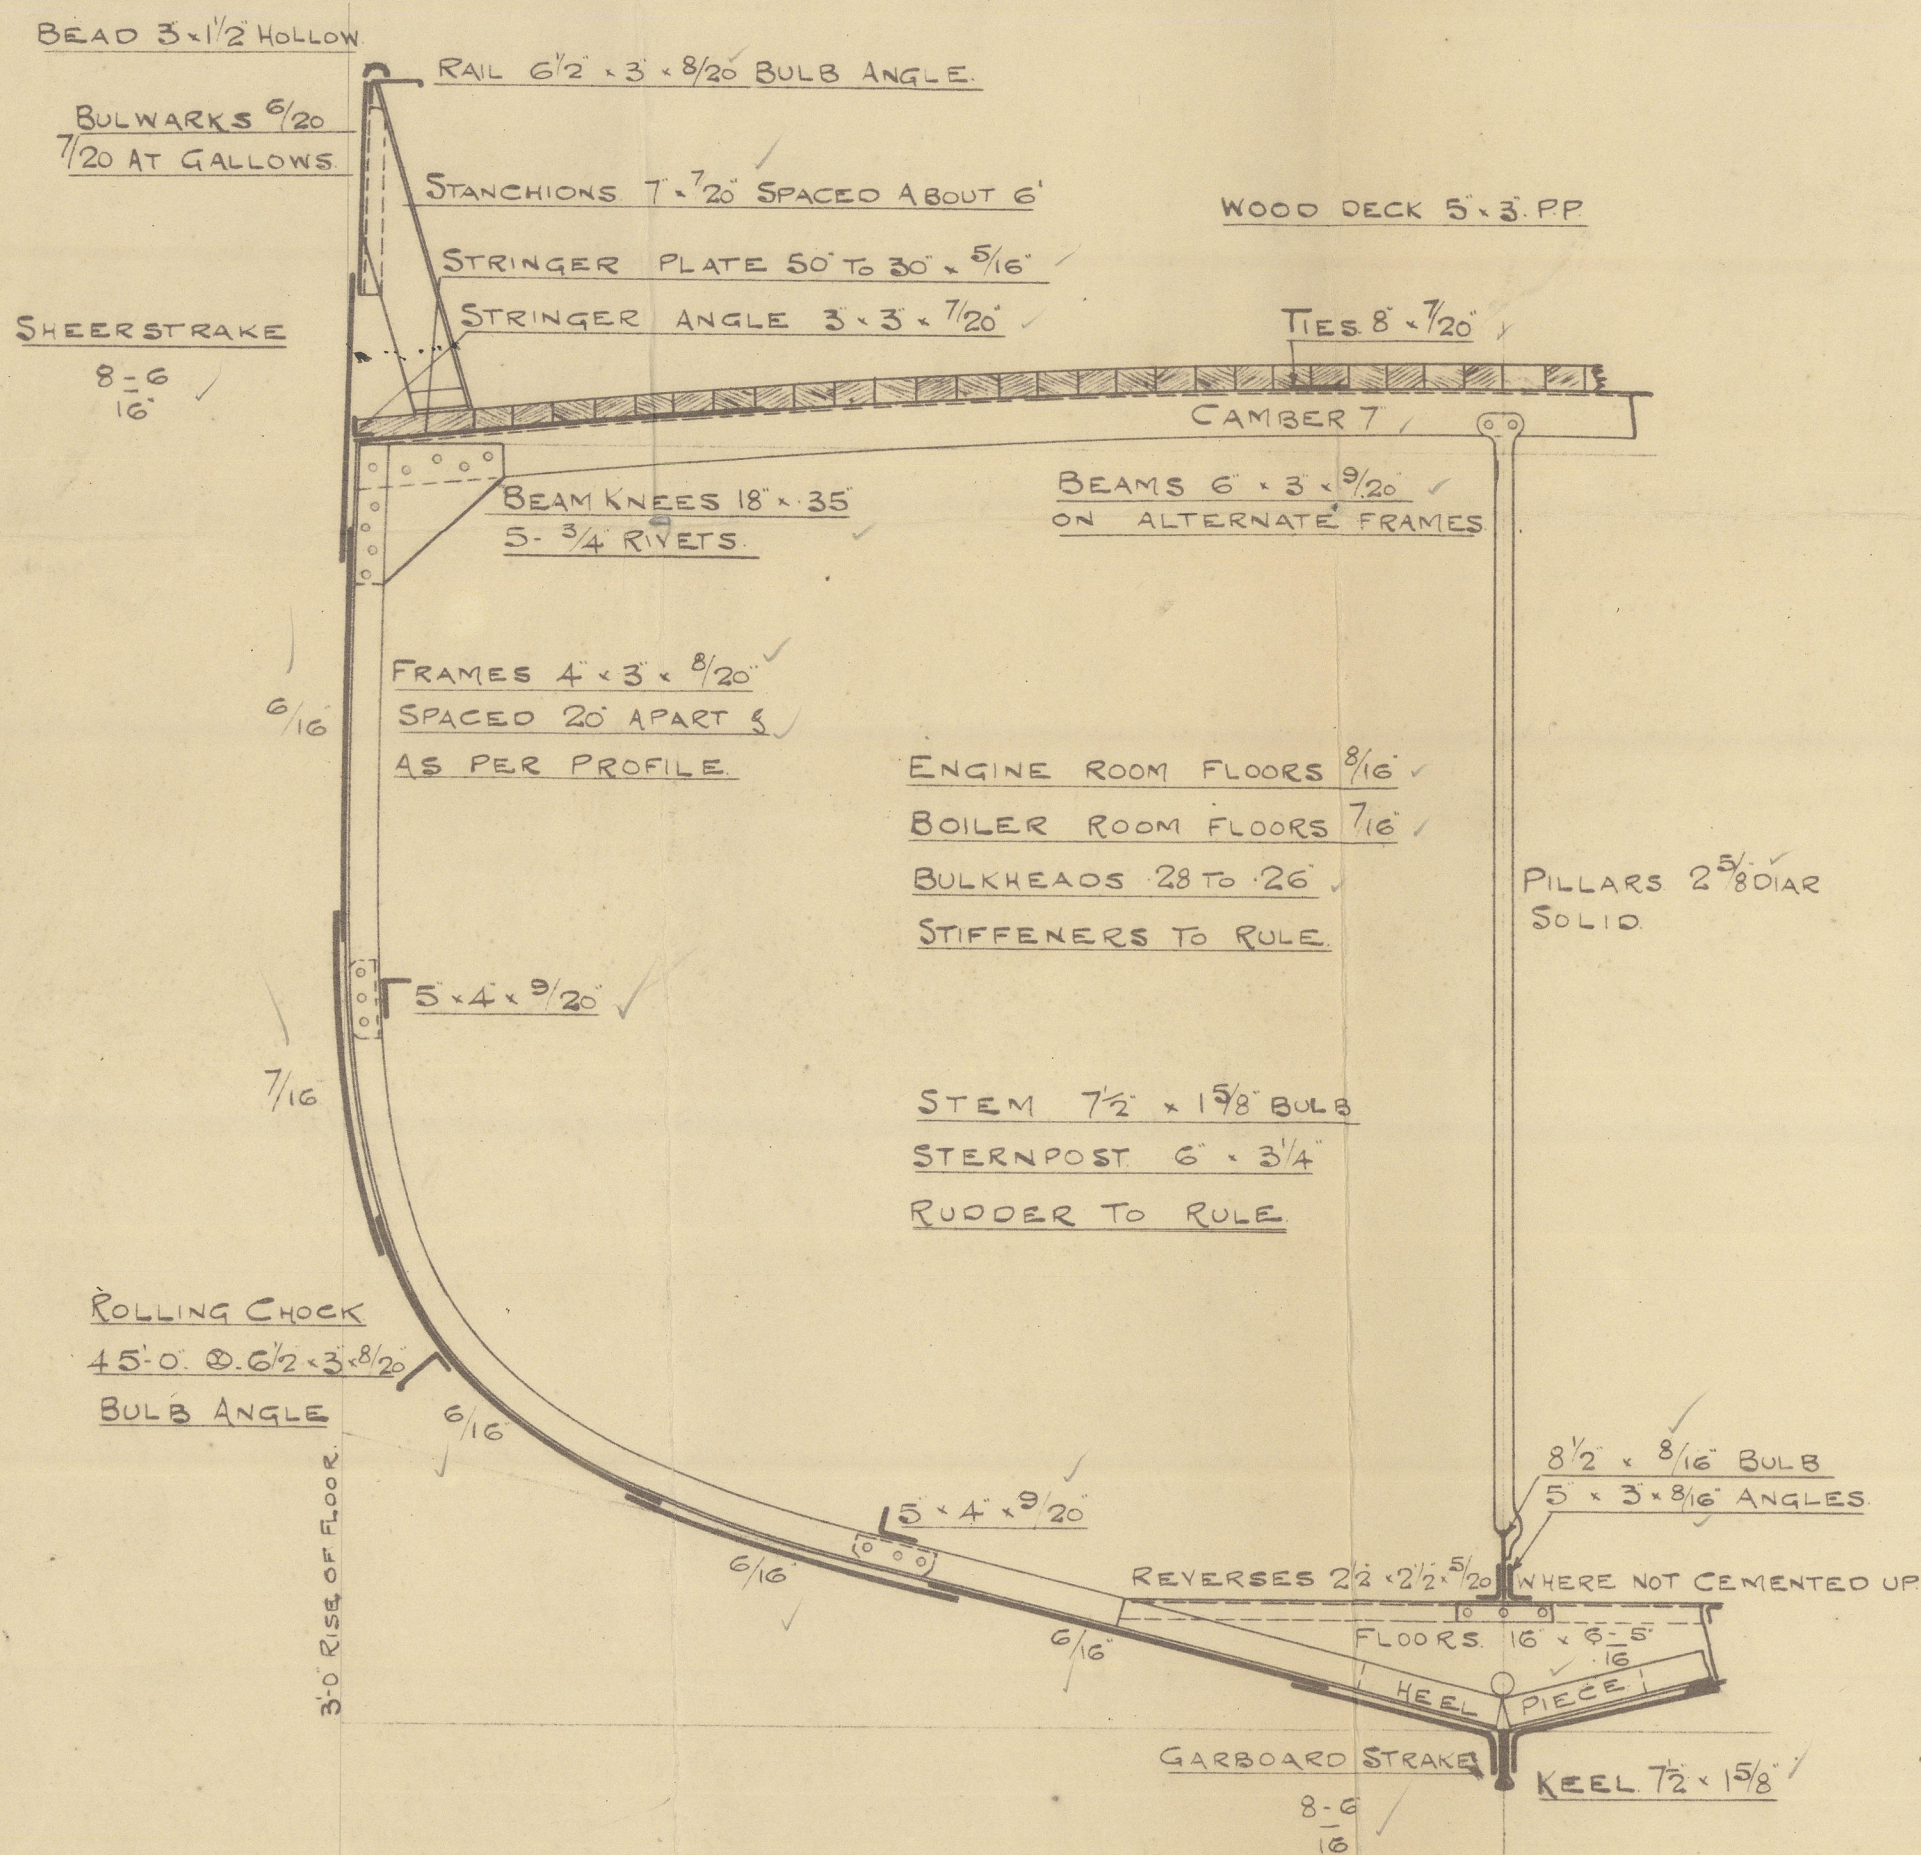

## NUMERALS

B+D ----- 37 125 ✓  
L x (B+D) ----- 5137 50 ✓

## PROPORTIONS

L/D ----- 10.56 ✓  
L/B ----- 5.86 ✓

## EQUIPMENT

1ST BOWER 8 CWTs STOCKLESS ✓  
2ND 74 ✓  
KEGGE 3/4 E x STOCK ✓  
120 FATHOMS 1 1/2 STUDLINK CABLE ✓  
60 6 HAWSER ✓  
60 5 WARP ✓

## RIVETING

BUTTS OF SHELL PLATING TO BE LAPPELLED  
DOUBLE RIVETED EXCEPT GARBOARD  
& SHEER STRAKE WHICH ARE TO BE  
STRAPPED  
SHELL SEAMS DOUBLE RIVETED  
BULWARK SEAM SINGLE RIVETED  
RIVETS IN KEEL, STEM & STERNFRAME 1" DIAR  
SHELL RIVETS 3/4 DIAR

Cf.  
15.6.14



W972-0127


Cochrane's nos 621-2

Maddy Section:



*s/s Acantha Hull Rpt No 28195*

*Bona Dea - - -*

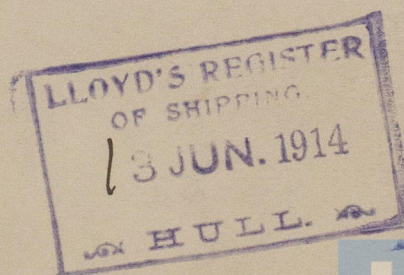

RETAIN



© 2020

Lloyd's Register  
Foundation



PLAN No. 4420  
 FOR ENCLOSURE TO  
 MESSRS LLOYDS SURVEYOR  
 HULL. FROM  
 COCHRANE & SONS, LTD.  
 SHIPBUILDERS, SELBY  
 DATE 8/6/14

# MIDSHIP SECTION STEEL SCREW TRAWLER

NOS 621-2


DIMS 140'-0" B.P. x 24'-0" EX x 13'-3" MLD

SCALE 1/2" INCH.

TO CLASS 100A1 - LLOYDS STEAM TRAWLER

DECK PLATED OVER IN WAY OF MACHINERY

E & B CASING AS PREVIOUSLY APPROVED

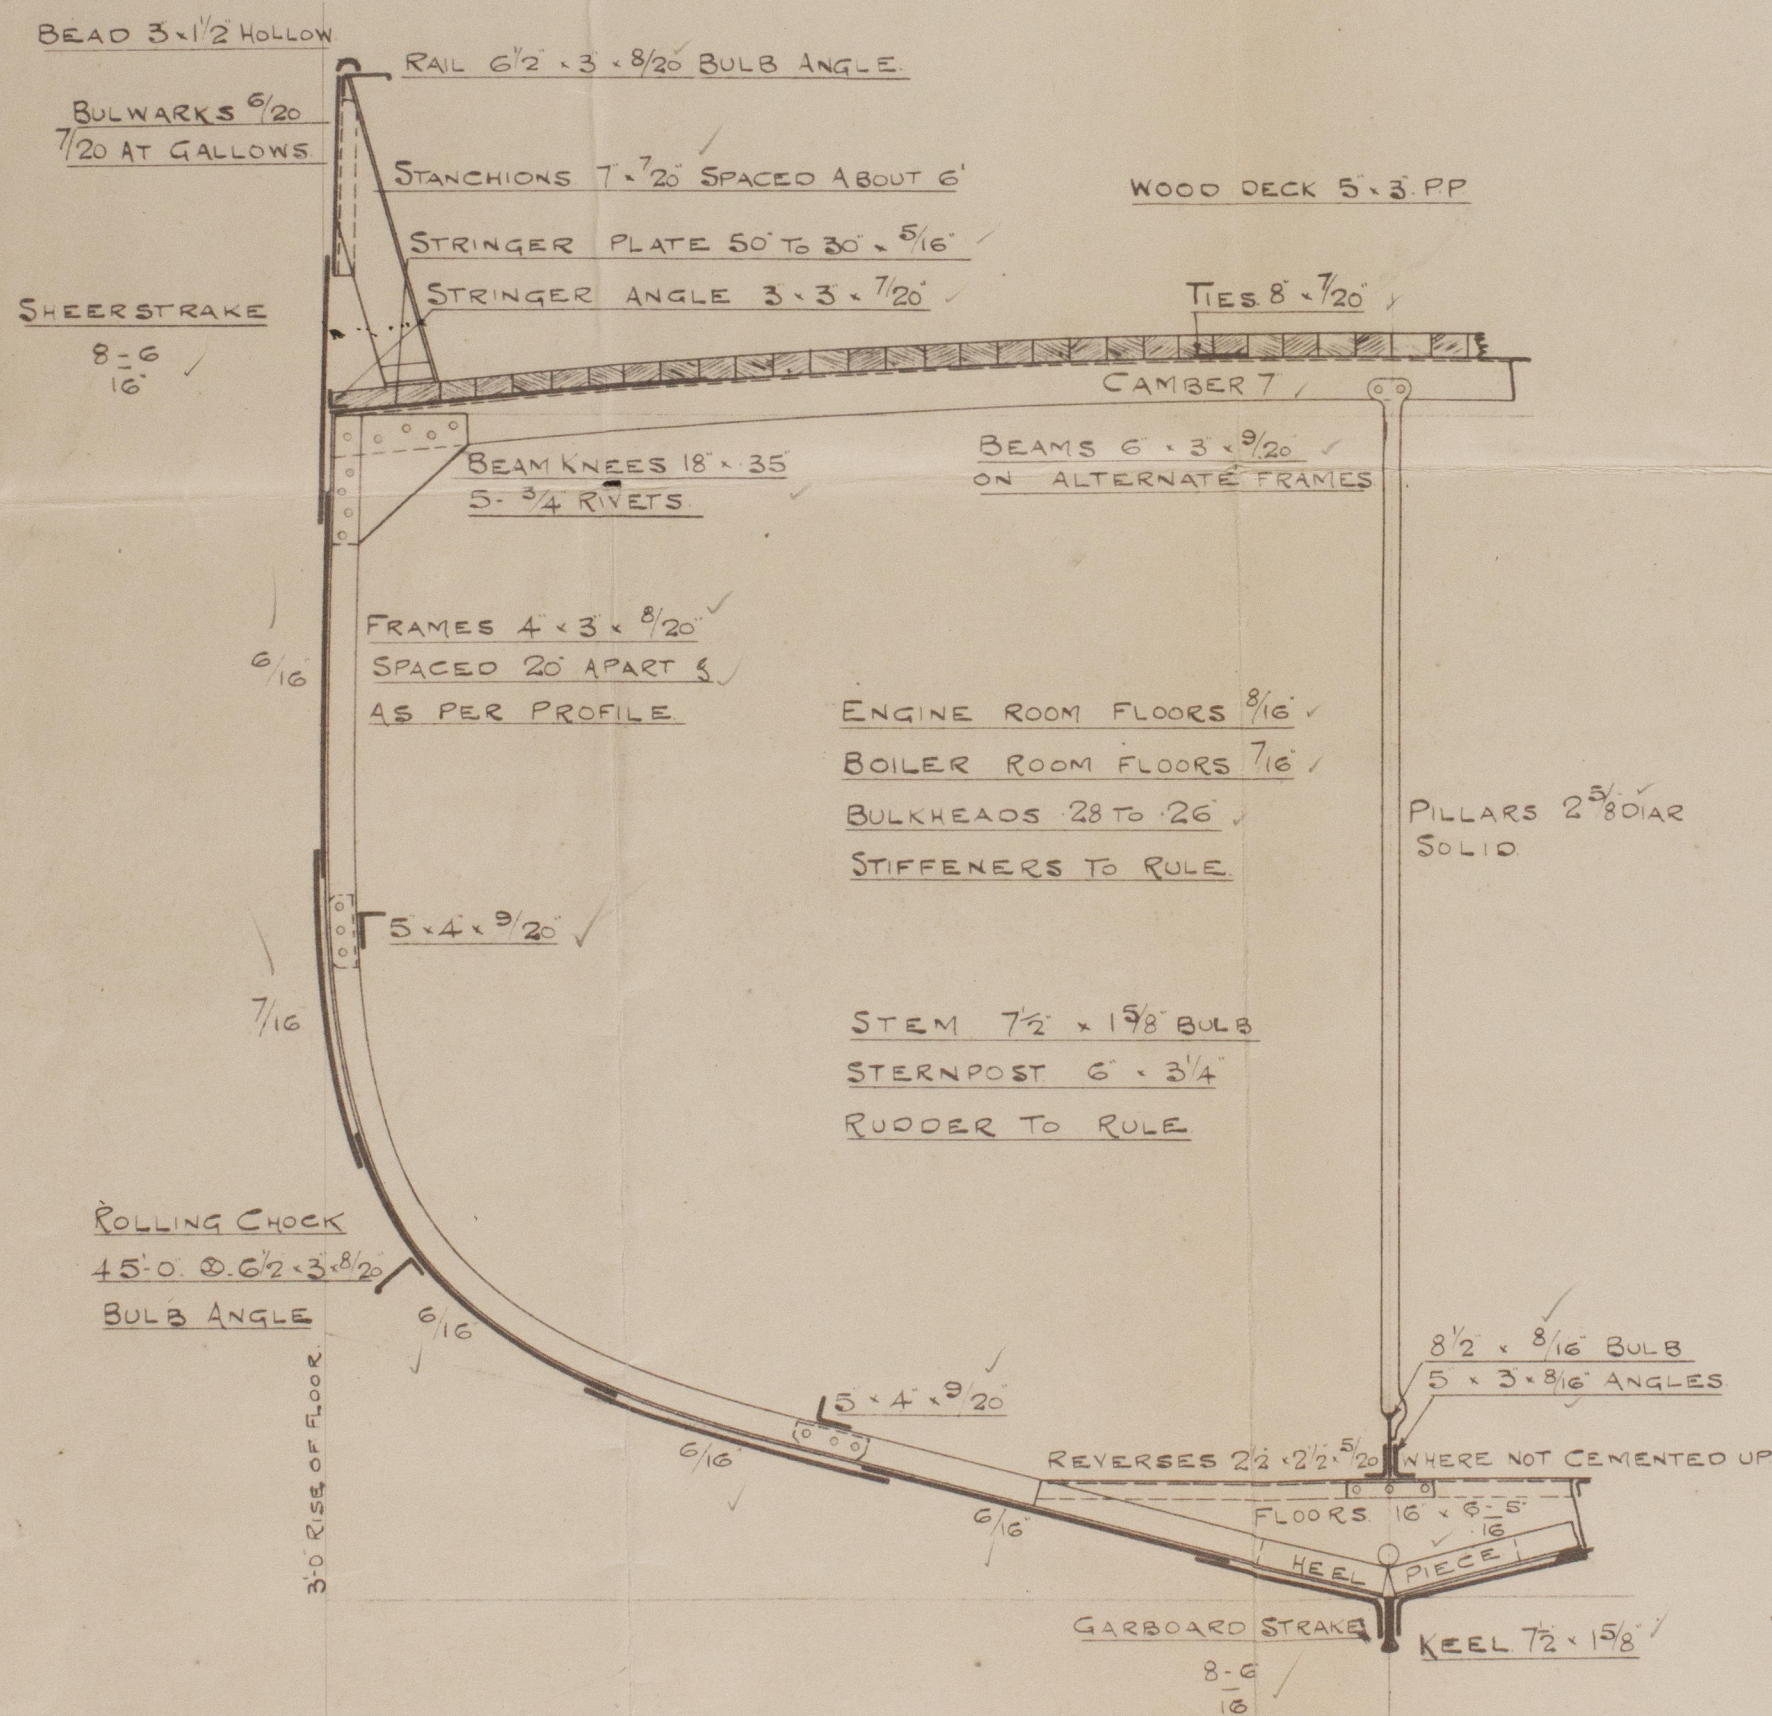

## NUMERALS

B + D ----- 37 125 ✓  
 L x (B + D) ----- 5187 50 ✓

## PROPORTIONS

L/D ----- 10.56 ✓  
 L/B ----- 5.86 ✓

## EQUIPMENT

1ST BOWER 8 CWTs STOCKLESS ✓  
 2ND 74 ✓  
 KEDGE 3/4 EX STOCK ✓  
 120 FATHOMS 12 1/16 STUOLINK CABLE ✓  
 60 6 HAWSER ✓  
 60 5 WARP ✓

## RIVETING

BUTTS OF SHELL PLATING TO BE LAPPEO  
 & DOUBLE RIVETED EXCEPT GARBAGE  
 & SHEER STRAKE WHICH ARE TO BE  
 STRAPPED  
 SHELL SEAMS DOUBLE RIVETED  
 BULWARK SEAM SINGLE RIVETED  
 RIVETS IN KEEL STEM & STERNFRAME 1" DIA  
 SHELL RIVETS 3/4" DIA

Cf.  
 15.6.14



© 2020  
 W972-0127

Lloyd's Register  
 Foundation



ALDEN & CO. LTD.  
Photo Processes



© 2020

Lloyd's Register  
Foundation