

— STEEL SCREW TRAWLER —


N^{os} 380-1-2-3 & 4.

DIM'S LENGTH 117'-0" BREADTH 22'-0" DEPTH OF HOLD 11'-9" MOULDED 12'-6"

— SCALE $\frac{1}{2}$ INCH = ONE FOOT. —

TO BE CLASSED 100.A.I. FOR FISHING PURPOSES.

DECK PLATED OVER AT SIDES OF E & B. CASING

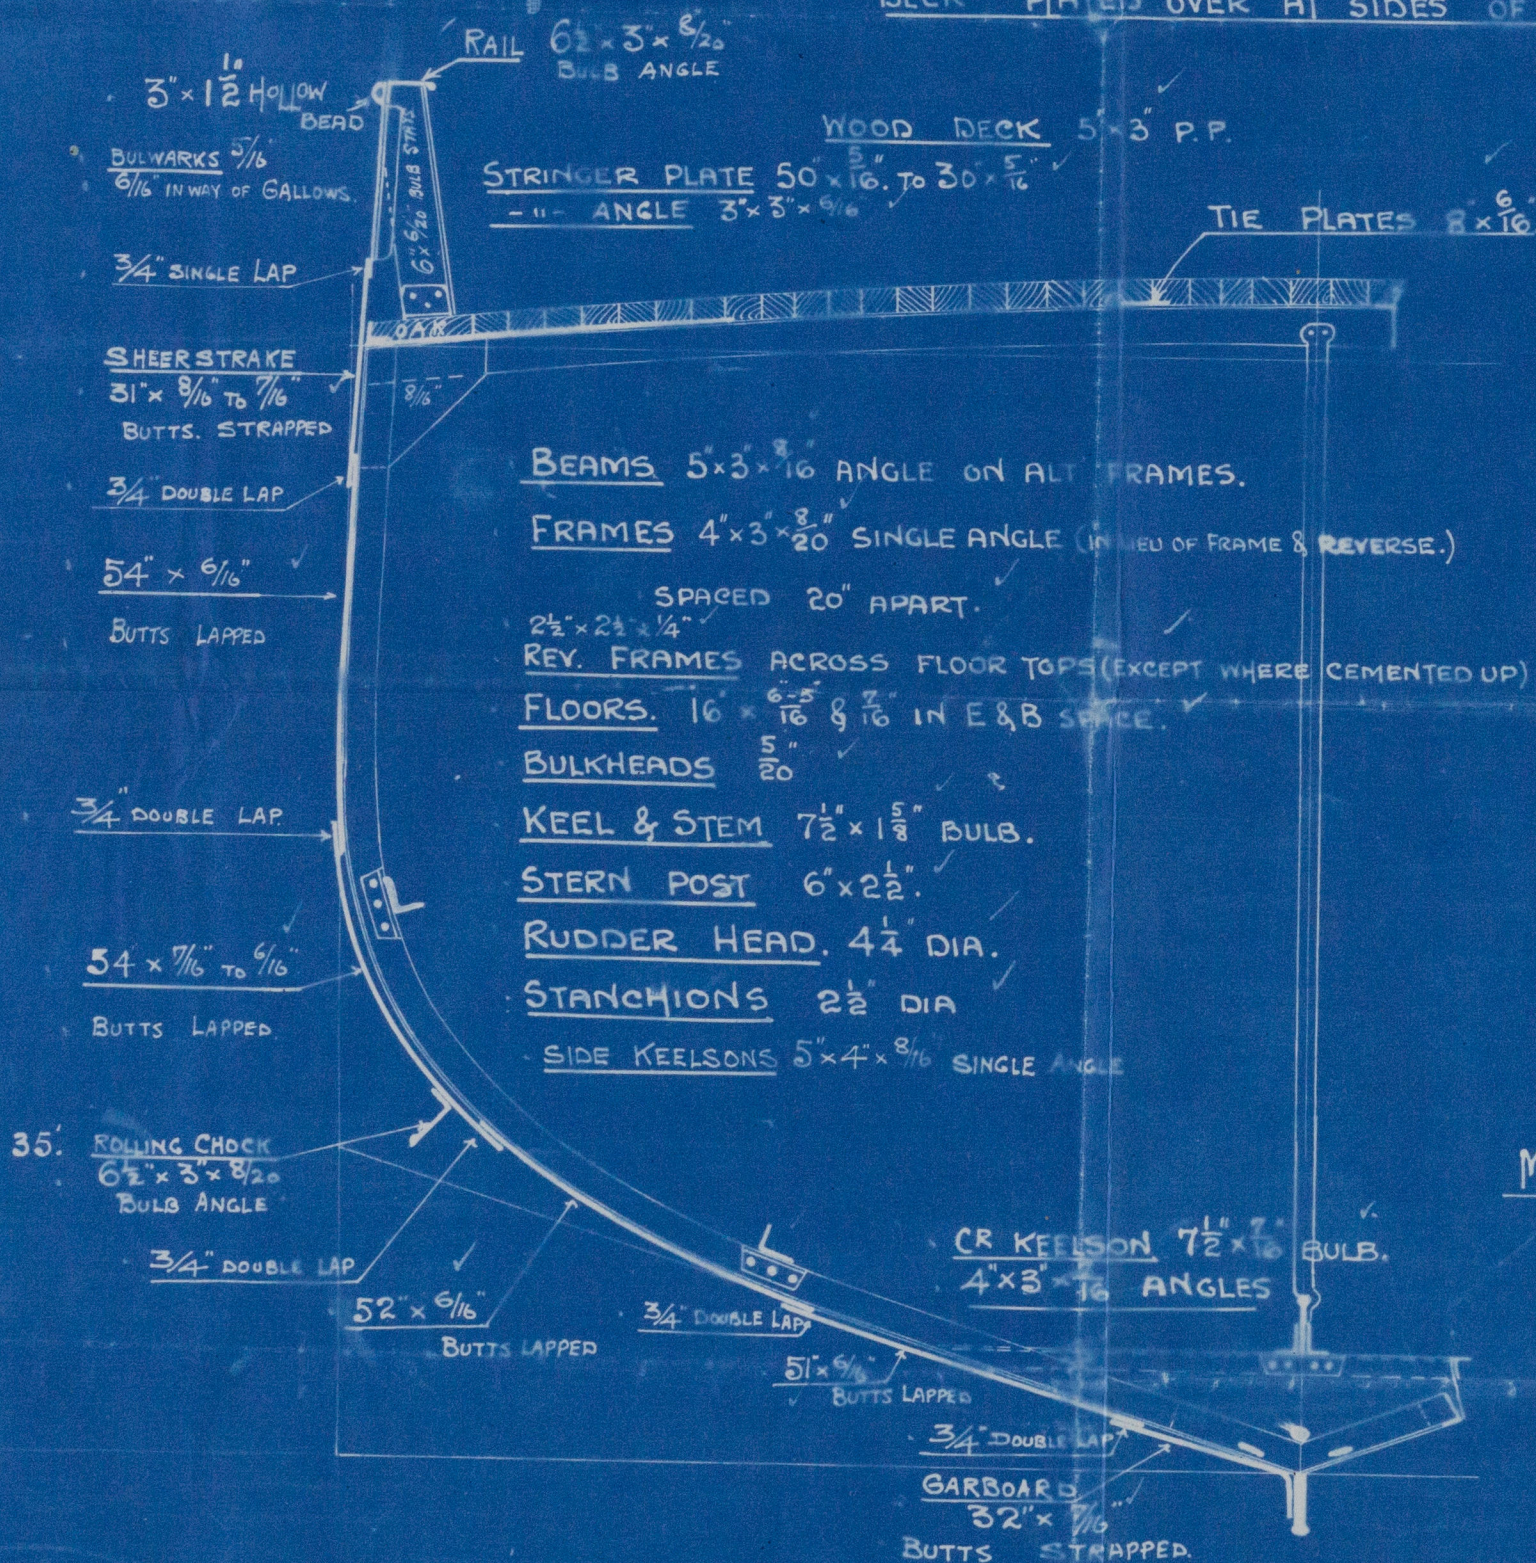

LLOYD'S NUMERALS

2-1 GIRTH 19.33
 2-1 BREADTH 10.35 ✓
 2-1 DEPTH 12.36 ✓
 43.24 1ST NO
 115.87
 ✓ 5010 - 2188. 2ND NO

D To L + - - - - - 8.9

B to L.-----5.2

EQUIPMENT

1 ST	BOWER ANCHOR	5 $\frac{1}{4}$	✓	CWTS Ex STOCK
2 ND	" "	4 $\frac{3}{4}$	✓	" " "
3 RD	" "	2 $\frac{1}{2}$	✓	" " "
90 FATHOMS		1"	✓	SHORT LINK CABLE
60 "		6"	✓	HAWSER
60 "		4 $\frac{1}{2}$	✓	WARP.

MESSRS GOCHRANE & SONS

SHIPBUILDERS

SELBY

[illegible]




W473-0147
Cochrane & Sons No. 383
s/s Agememnon
Hull Report No. 18646

RETAIN

RETAIN



© 2020

Lloyd's Register
Foundation