



Anderson S.B. Co
Seattle

Vessel No 4
S.S. "Albert Martin"

Profile + Deck plan
as built

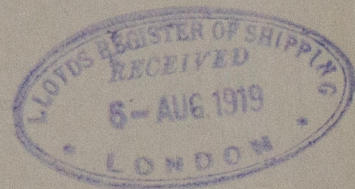

RETAIN



© 2020

W974-0061

Lloyd's Register
Foundation