


16.2.02  
27.3.02  
23.4.02  
16.4.02

Profile & Deck Plans of Screw Steamer No 238  
Class 100 H (Steel)  
Scale 1/4" = 1 foot

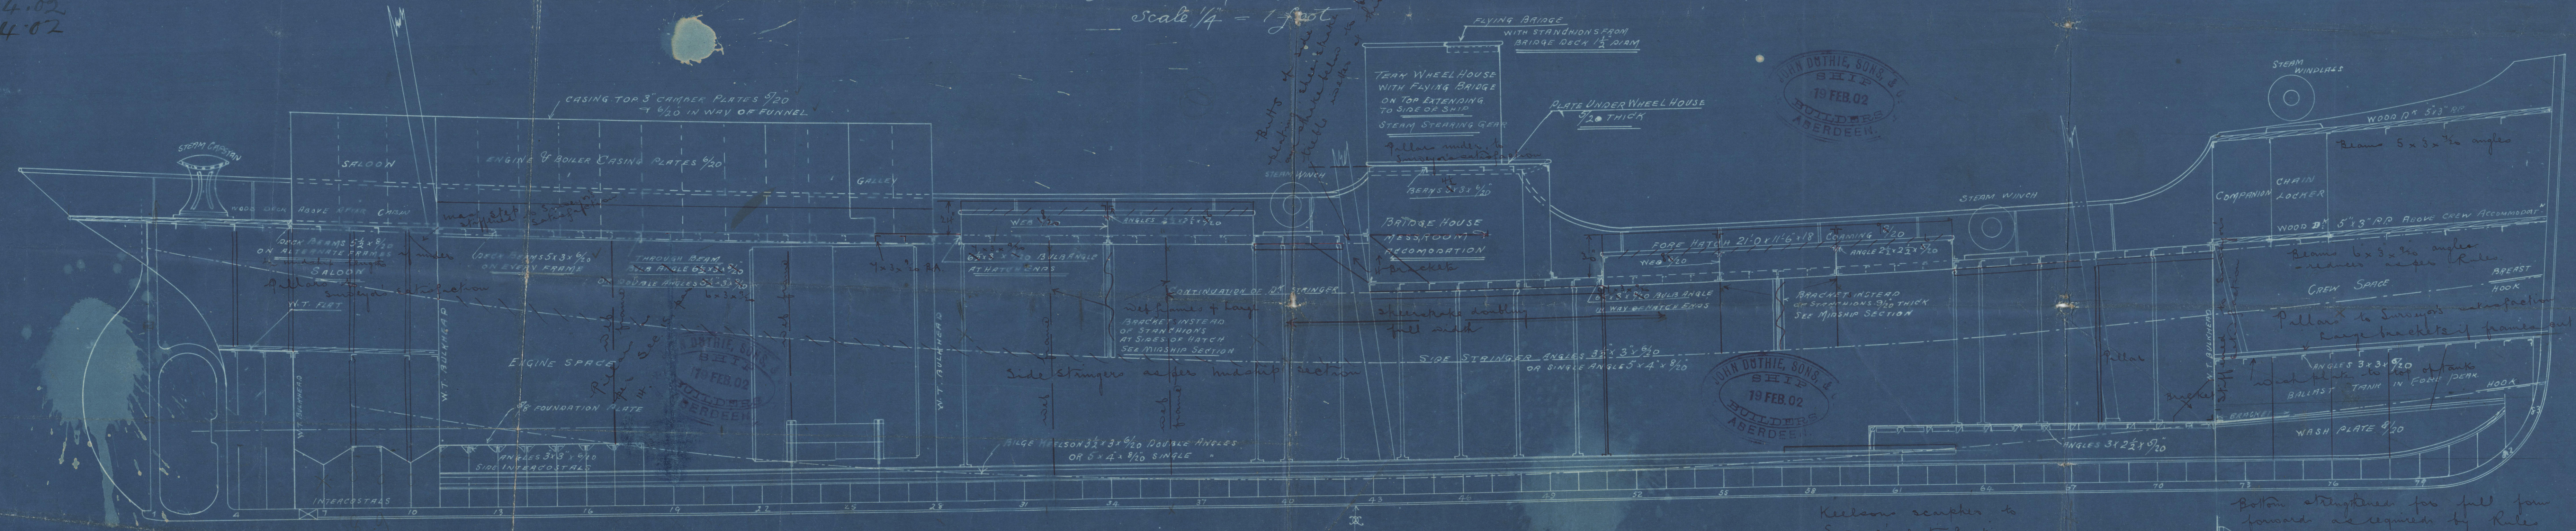

Keelson scuppers to  
Surveyor's satisfaction

Bottom strengthened for full form  
forward as required by Rules



Lloyd's Register  
Foundation






Messrs John Duthie  
Sons & Coys Ld.  
238

Longitudinal Section

~~S.S. Alastair~~  
~~Abn. Rpt. No. 7358 14/3/02~~



Alastair

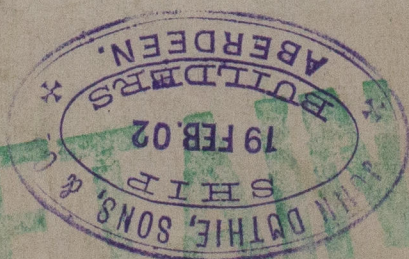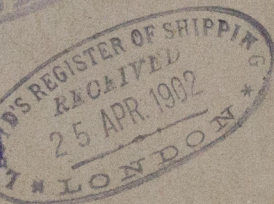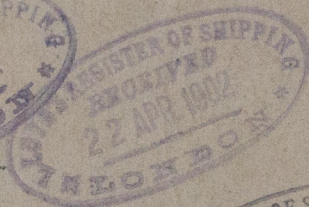

© 2020

Lloyd's Register  
Foundation

W974-0126