


SCALE $\frac{3}{4}" = \text{ONE FOOT}$

EQUIPMENT AS PER RULE
ACCORDING TO TONNAGE

Bottom strengthened for full corner
forward as required by Rules.

Lloyd's Register
Foundation




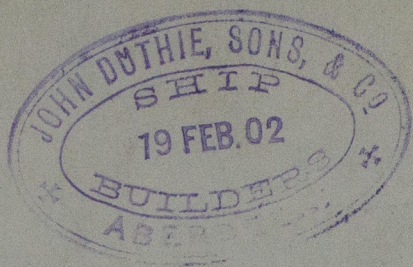


© 20

Lloyd's Register
Foundation

Messrs John Duthie
Sims & Coys No. 238
Midship Section

S. S. 'Alastair' ~~Cancelled~~
Abn. Rpt No. 7358 12/3/04

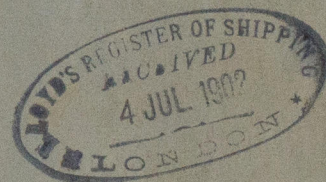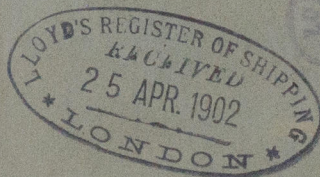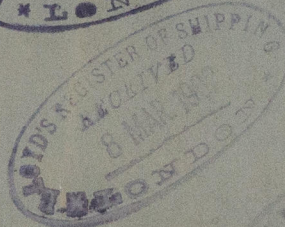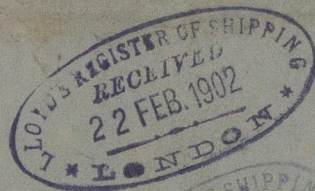

RETAIN



© 2020

Lloyd's Register
Foundation

W974-0127