


## BOILER

ENGLISH DIMENSIONS IN FEET AND INCHES				
GERMAN	"	"	"	MILLIMETRES

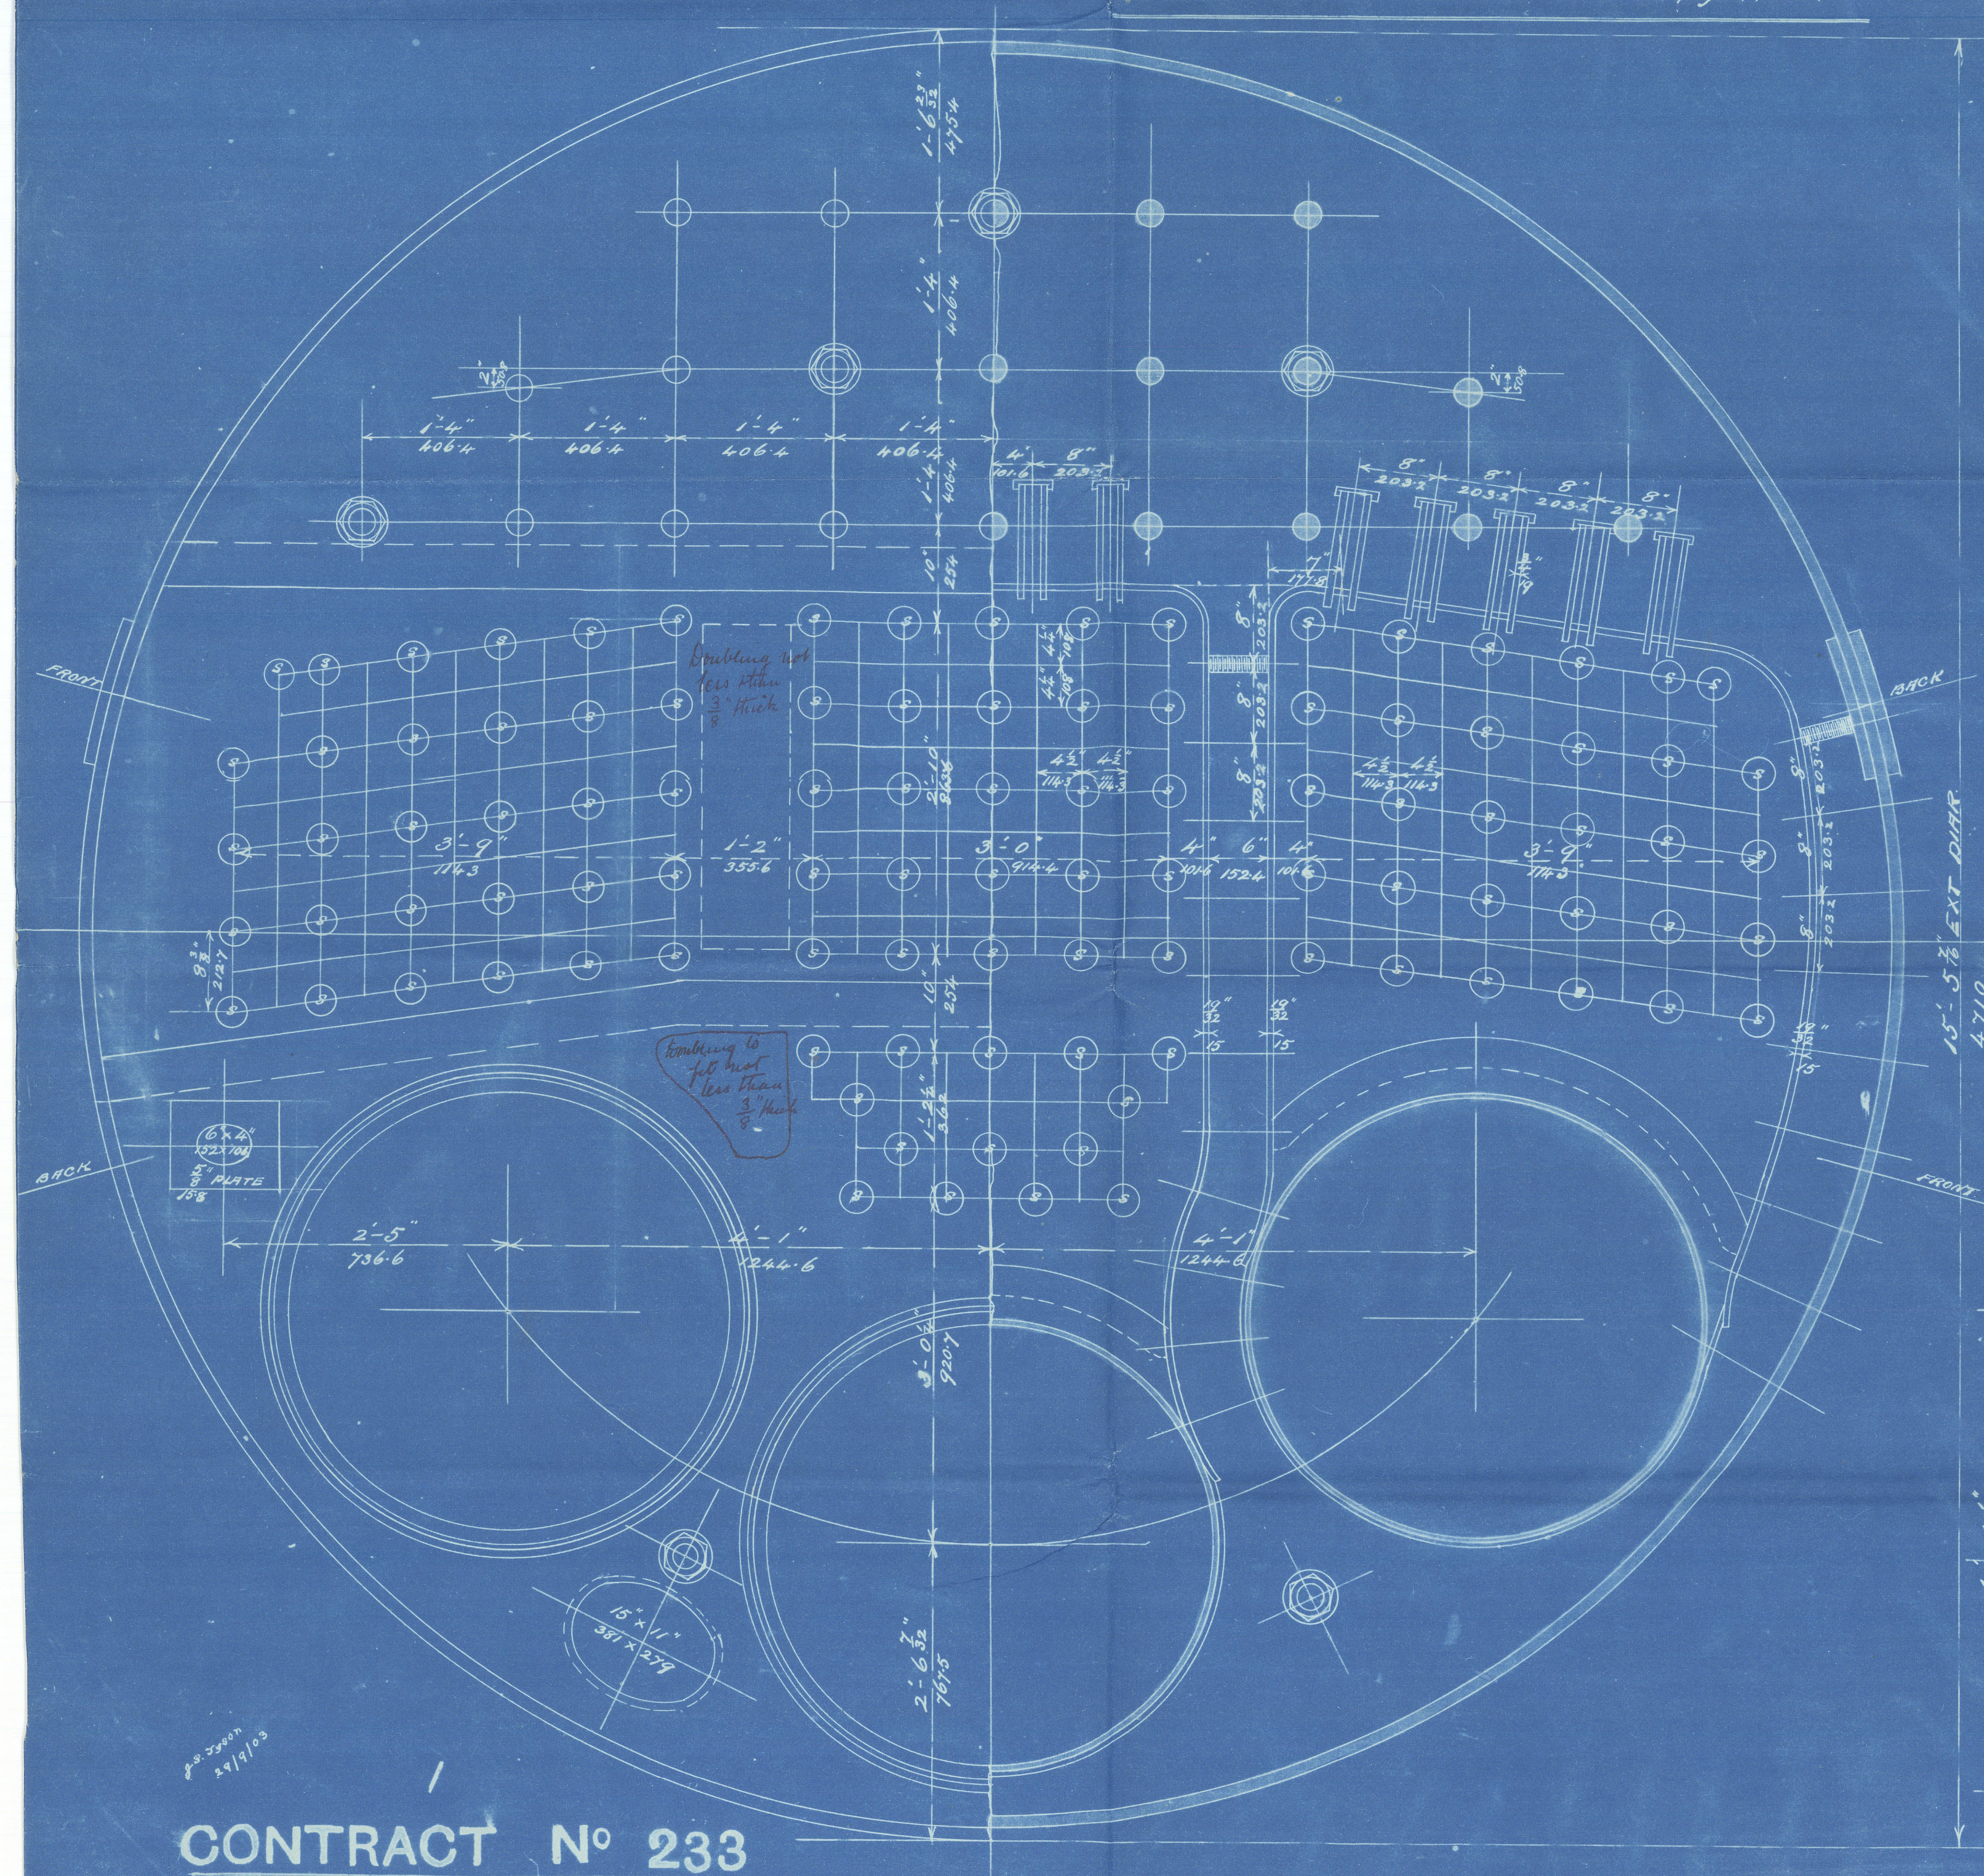

CONTRACT N° 233  
N° OFF 2




Richardsons, Westgarth & Co. Ltd

Contract No. 233

Boilers for  
Northumberland S. B. Co's 113<sup>5</sup>/<sub>8</sub>

W. T. = 160 lbs

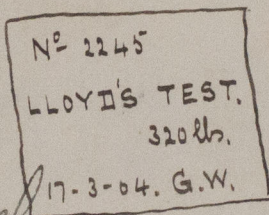

W 978-0013

sp "Fulton  
Granford"  
Std Rpt. 21756  
Nwc. F.E. No. 46.992.



© 2021

Lloyd's Register  
Foundation