


11.11.12 10.4.13
 11.11.12 30.4.13 (Copy) 8310. 1/12
 10.1.13 1.8.13
 2.1.13
 4.2.13
 14.2.13
 12.3.13

No 916-22
 PROFILE & DECK PLANS
 DIM^{ns} 350'0" BP x 47'0" HP x 27'0" DP
 TO CLASS LLOYDS 100 A1
 SCALE 1/8" = 1'00"

12.11.12
 12.11.12
 12.11.12

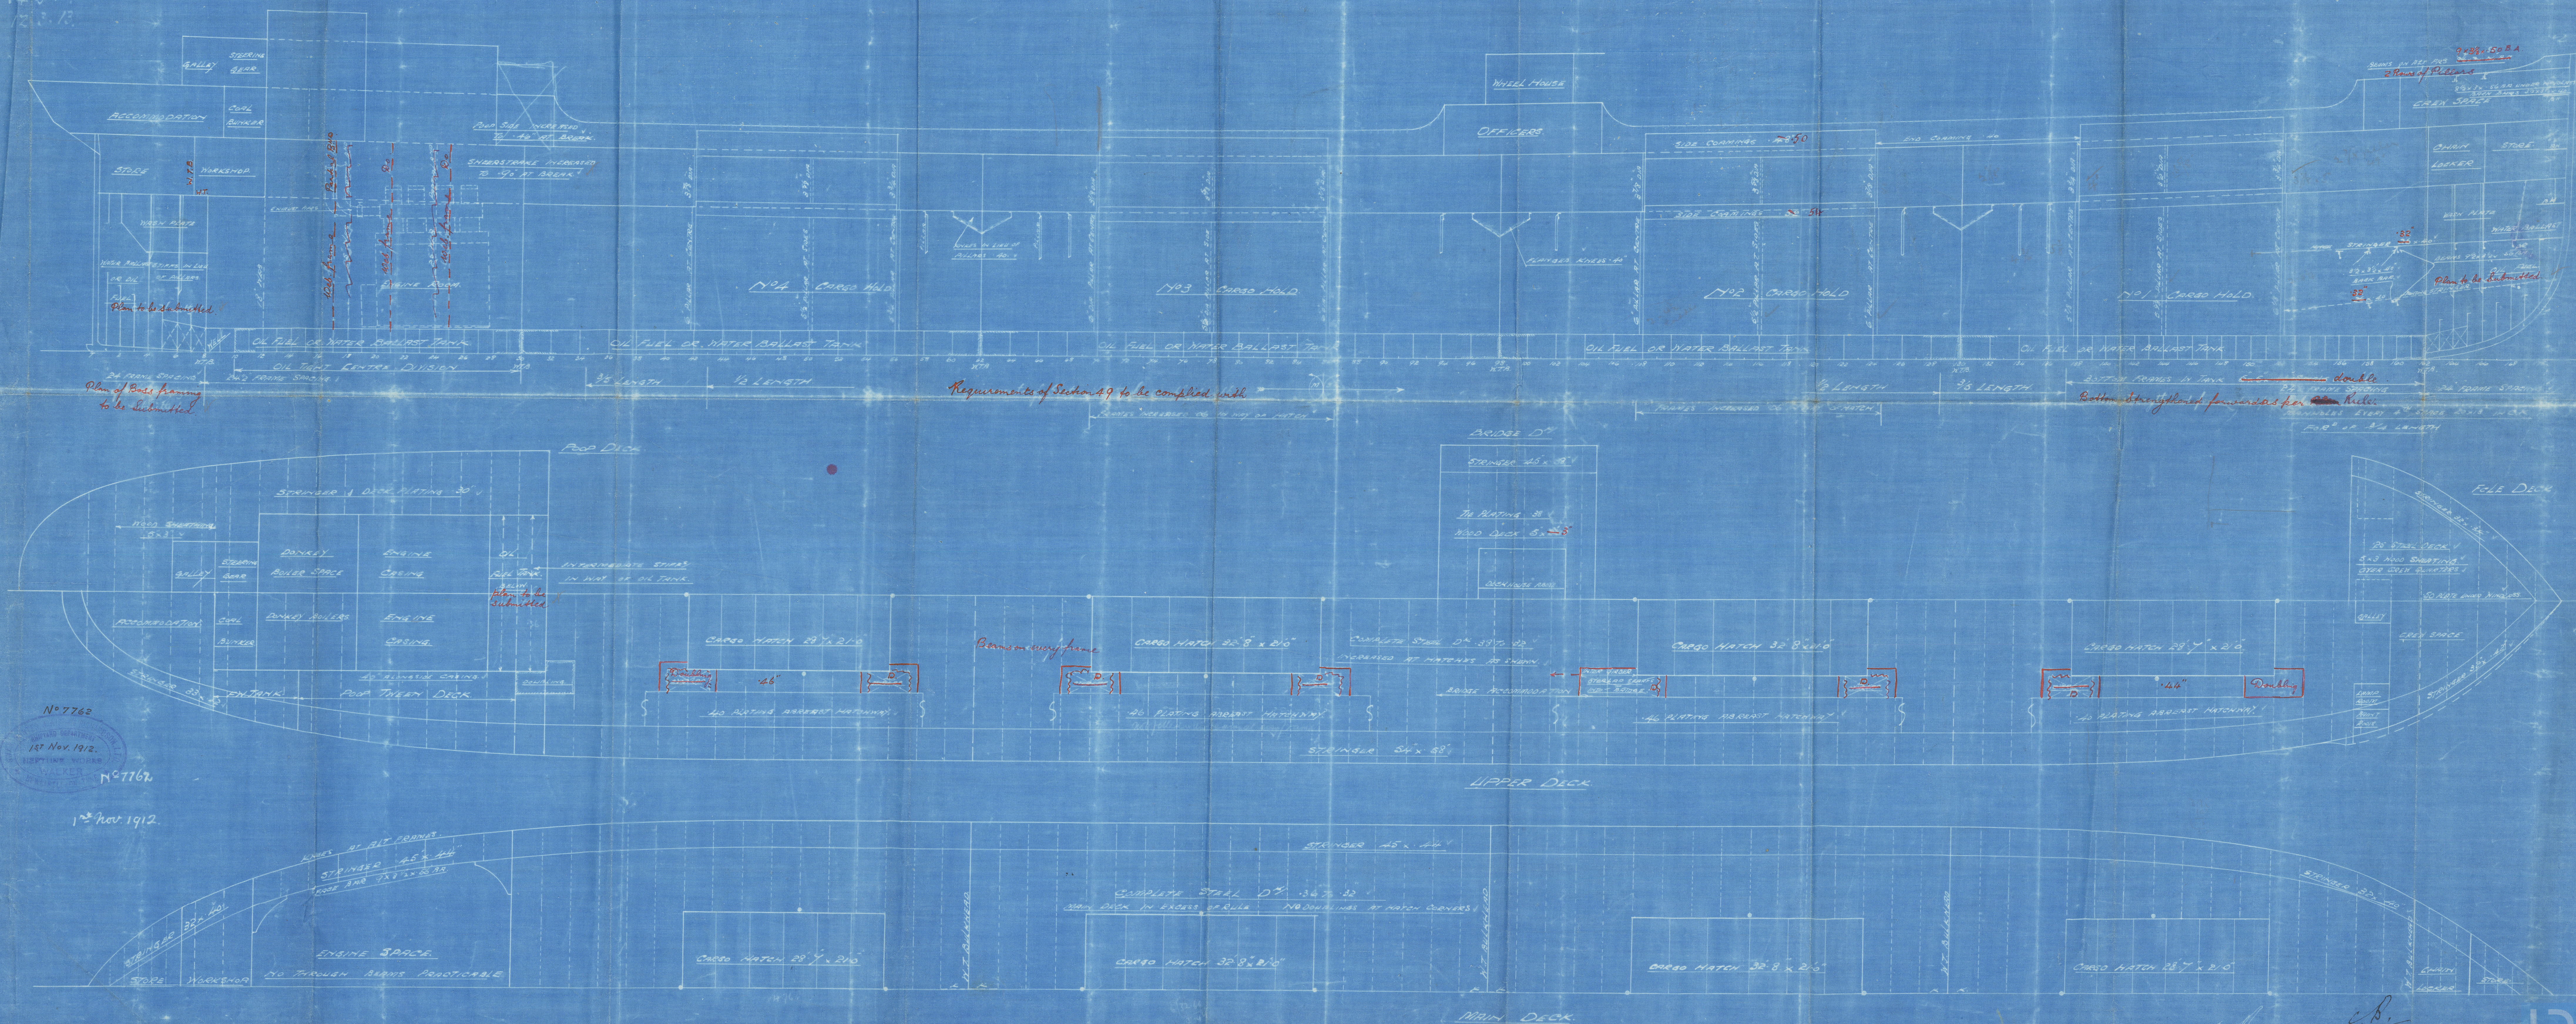


No 7762
 1st Nov. 1912
 No 7762
 1st Nov. 1912

13th Nov. 1912
 10.4.13

Nº 916-1922.

PROFILE & DECK PLANS.

0500-876M

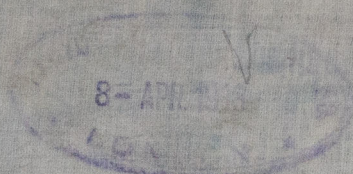



Messrs. Smith, Dock & Co. Ltd.

S.S. Nº 550



S.S. ARABIS

Ind. Report No. 8405

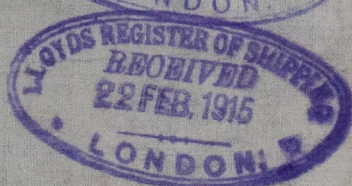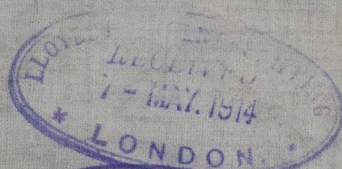

RETAIN



© 2021

Lloyd's Register
Foundation