

HORIZONTAL MULTITUBULAR STEEL BOILER 9'-0" DIA. BY 9'-0" LONG 80 LBS. W.P.

LLOYDS SURVEY.

MESSRS FURNESS WITHY & CO LTD S.S. No 281.


SCALE 1" = 1 FOOT.

3527.

SCALE 3" = 1 FOOT.

STEEL PLATES AND RIVETS.
ALL HOLES DRILLED IN POSITION AFTER BENDING.
PLATES NOT LESS THAN 27 TONS TENSILE.

SCALE, $\frac{1}{2}'' = 1 \text{ FOOT.}$

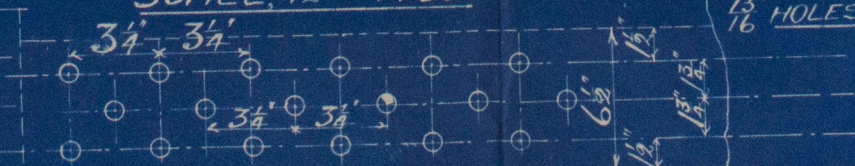

HEATING SURFACE 655 SQ. FEET

GRATE AREA 22.5 SQ FEET

James Lloyd's Surveyors

Riley Bros Ltd
No 3527

For Messrs James Withy & Co Ltd
S. J. No 281

W. P. 80 lbs

C/S "archbank"
Hpl. Rpt. No. 12646.

Approved Receipt
duplicate of 3499

W978-0108

No. 3425
LLOYD'S TEST
160 lbs.
GXM
17-4-05