

— MIDSHIP SECTION — — STEEL SCREW TRAWLER —


— N^o 380-1-2-3&4. —

DIM^s: LENGTH 117'-0" BREADTH 22'-0" DEPTH OF HOLD 11'-9" MOULDED 12'-6"

— SCALE 1/2 INCH = ONE FOOT. —

TO BE CLASSED 100.A.1. FOR FISHING PURPOSES.

DECK PLATED OVER AT SIDES OF E & B. CASING

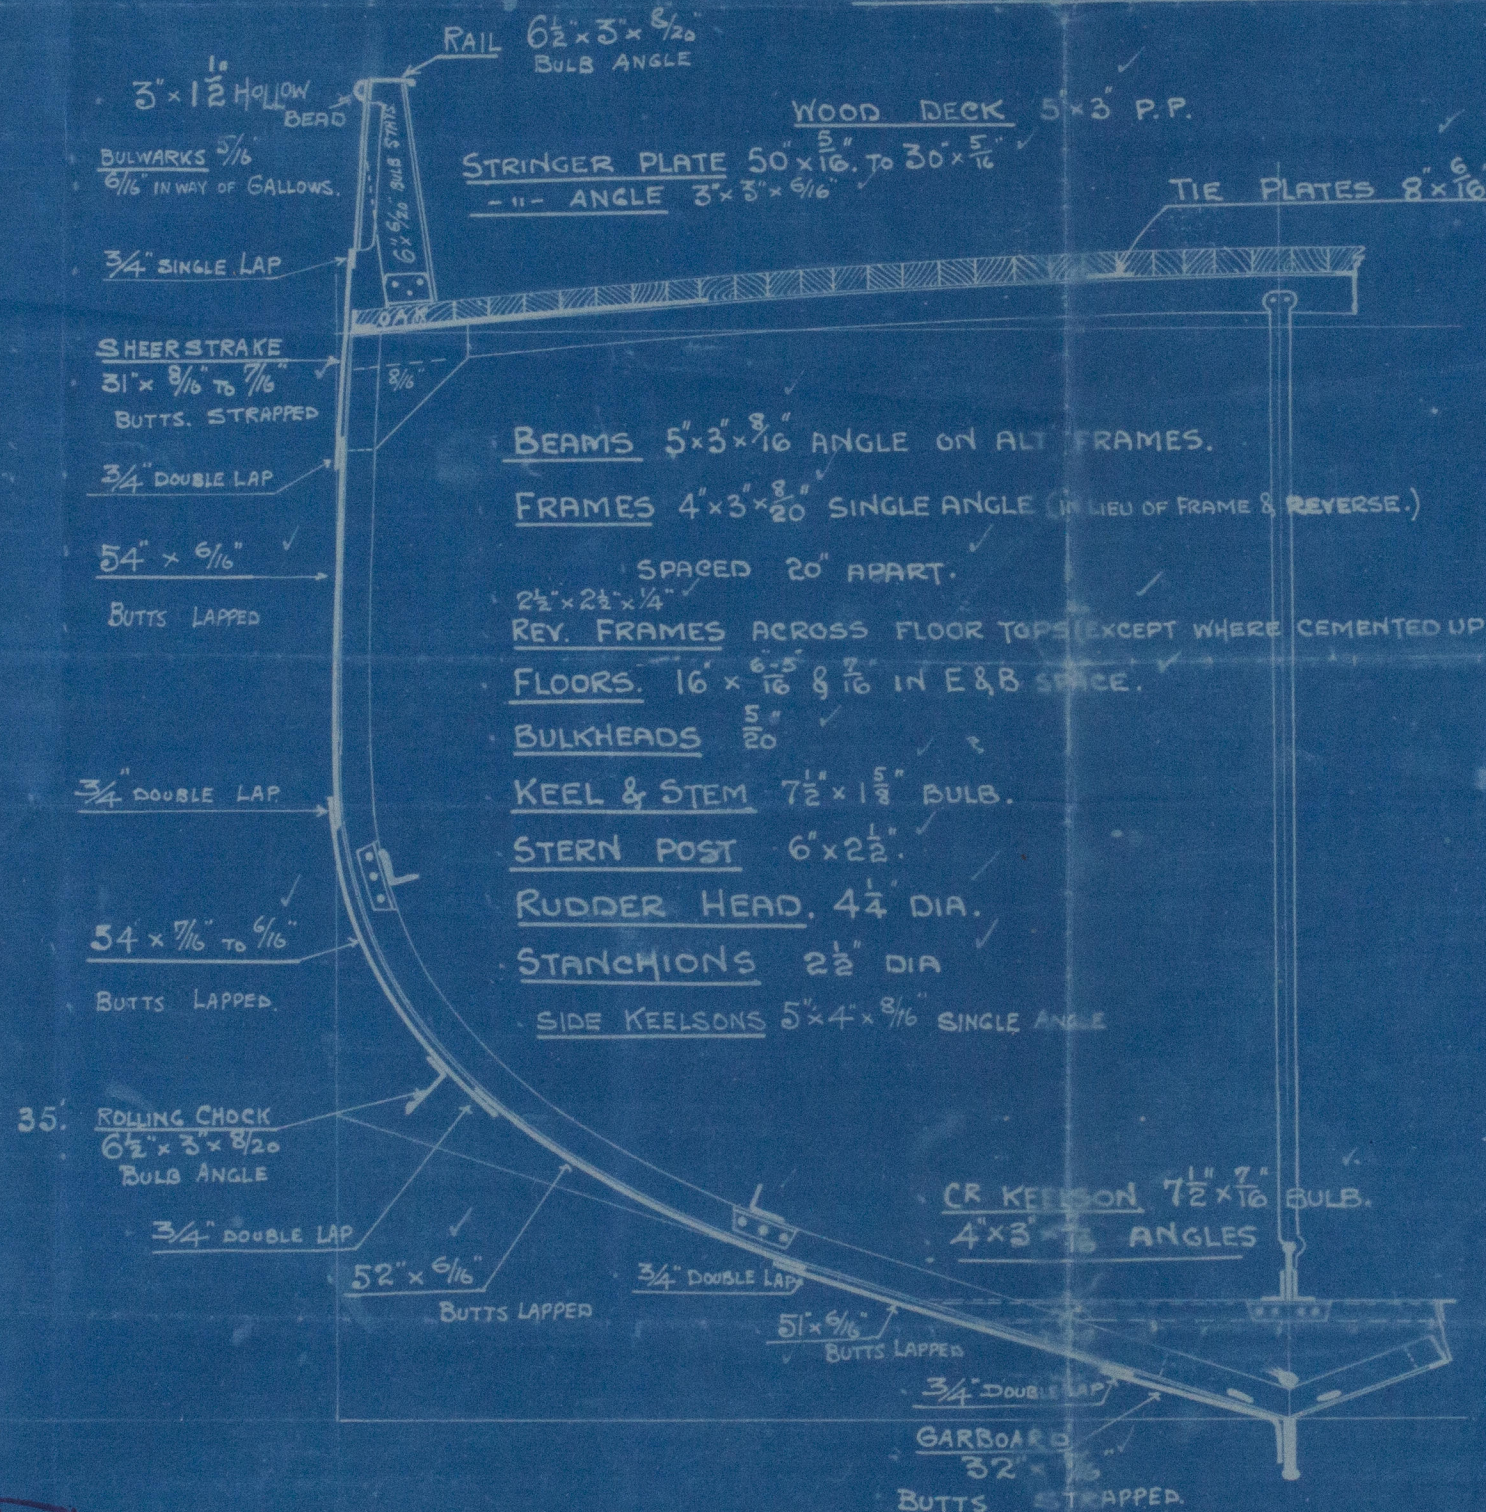

LLOYD'S NUMERALS

1/2 GIRTH	19.33
1/2 BREADTH	10.95
1/2 DEPTH	12.96
	43.24 1 ST N ^o
	115.87
	5010.2188, 2 ND N ^o

D to L	8.9
B to L	5.2


EQUIPMENT

1 ST BOWER ANCHOR	5 1/4	CWTS EX STOCK
2 ND " " "	4 3/4	" " "
3 RD " " "	2 1/2	" " "
90 FATHOMS	1"	SHORT LINK CABLE
60 " "	6"	HAWSER
60 " "	4 1/2"	WARP.

MESSRS COCHRANE & SONS

SHIPBUILDERS

SELBY

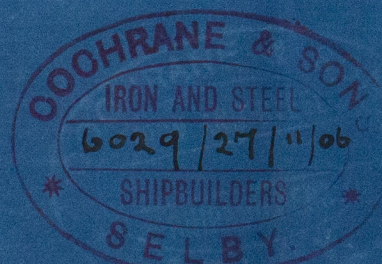

W978-0132

11.5.06 18.9.06

11.5.06 18.9.06

11.5.06 18.9.06

Midship Section
Cochrane & Sons
No 382

W978-0132

of Achilles
Hull Rpt No. 18538

Letter passed to
Sh. Aurora Hull 18458
Sh. Ariadne 18475.

W978-0132

RETAIN



© 2021

Lloyd's Register
Foundation