


"ZAMZAM" *Asst. Engr.*  
No. 2219.

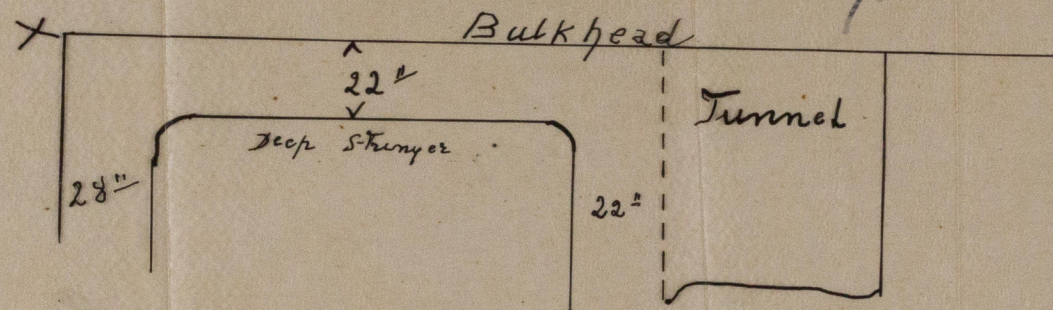

Bulkhead seen from Hold VI.

