


Office

(E)

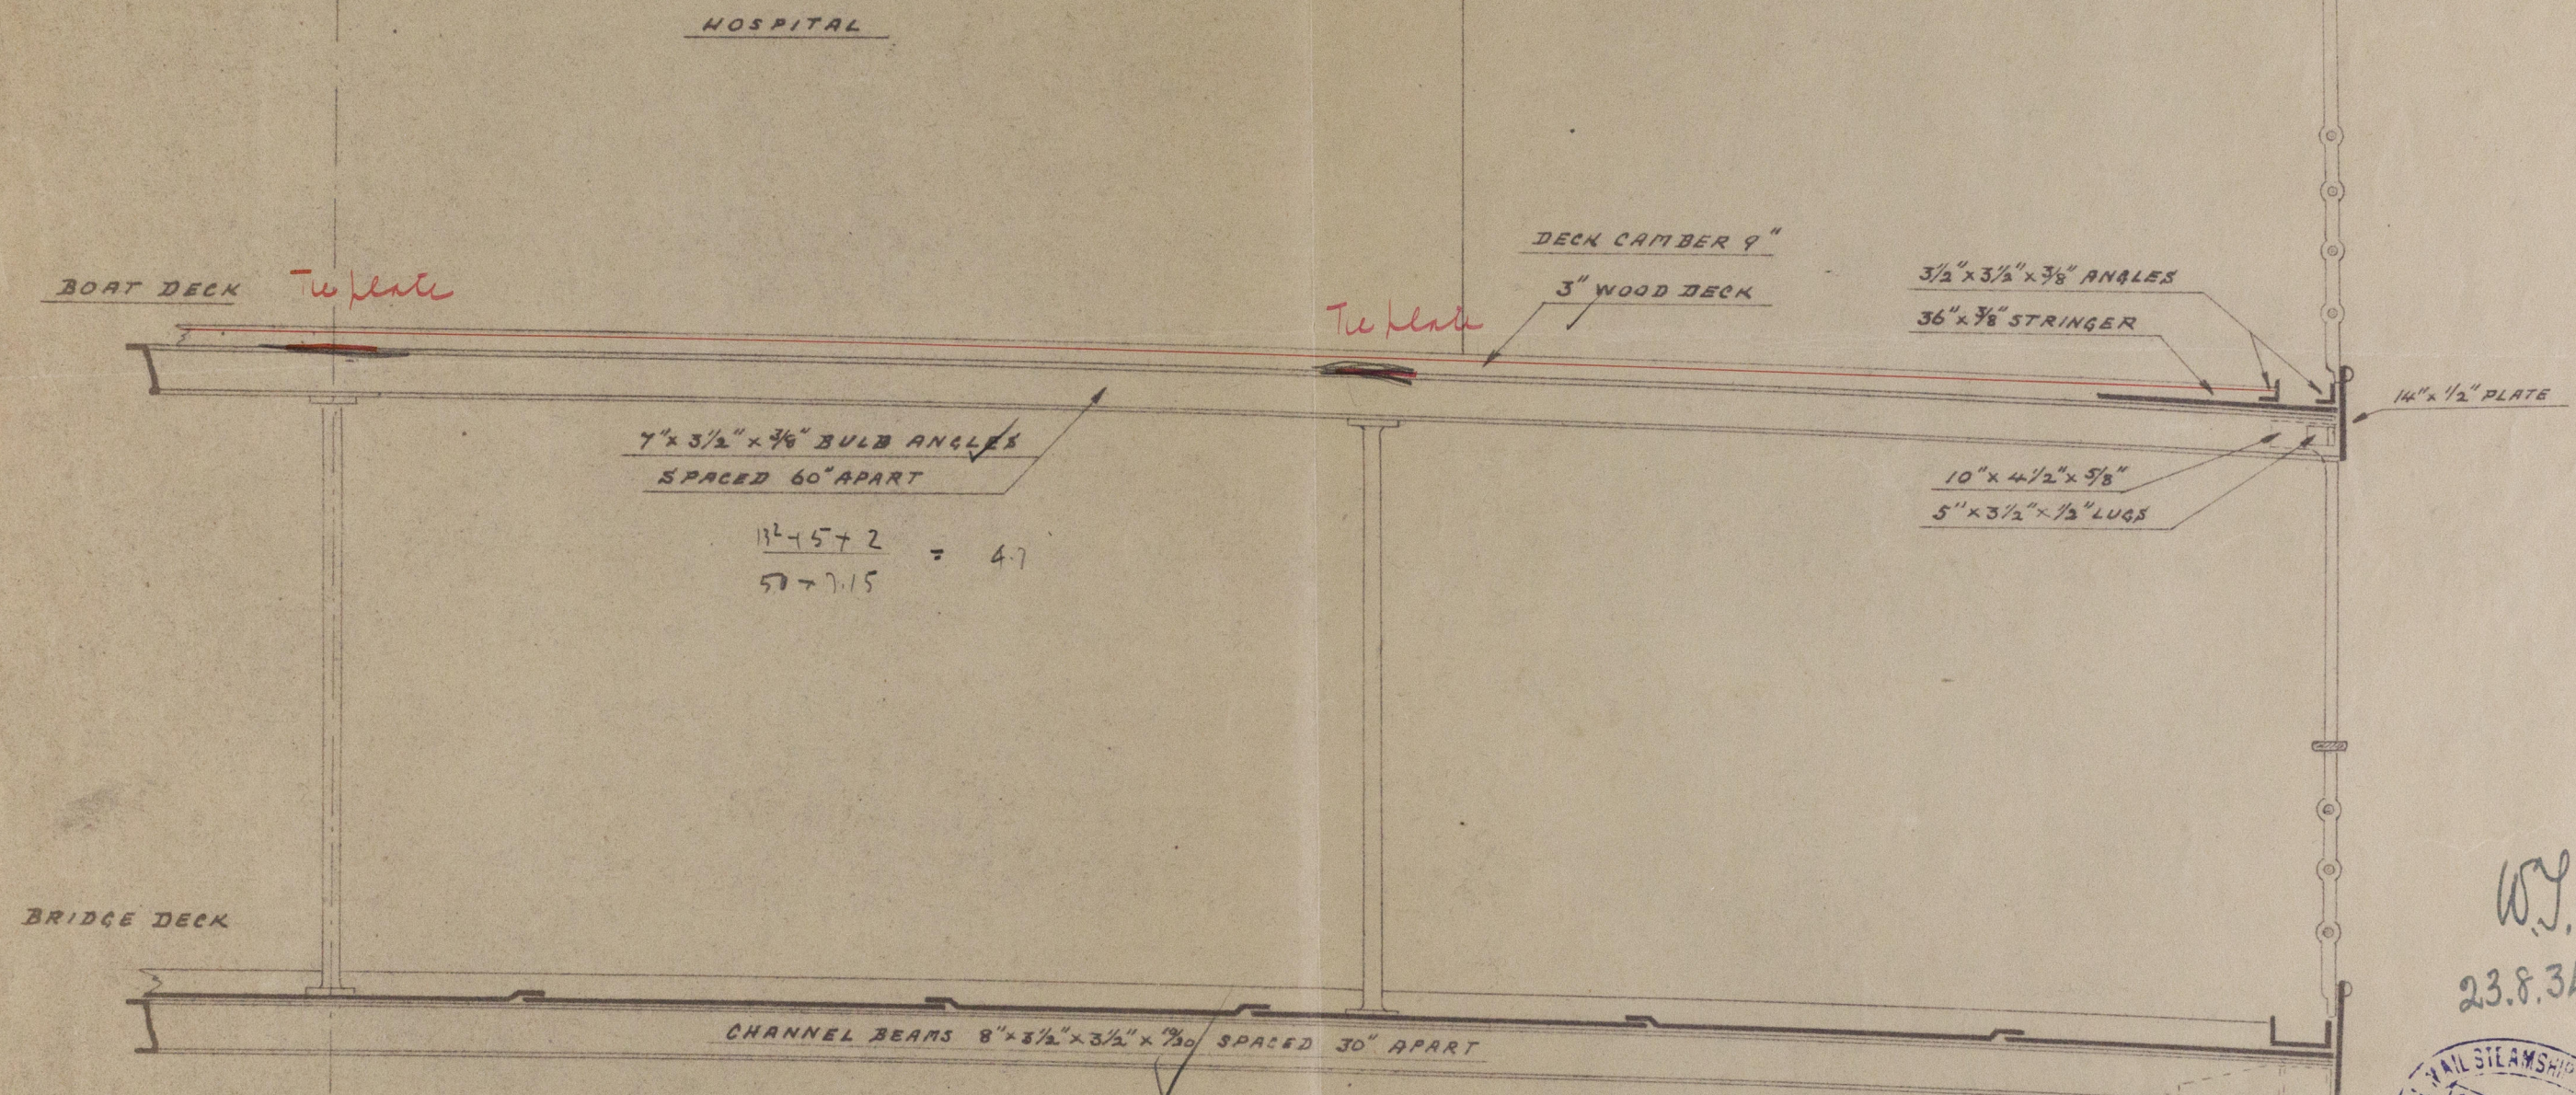


SECTION VIEW AT J. K. SHOWING STRUCTURE OF BOAT DECK AFT

FROM FRAME N° 69 TO 88.

T. S. S. ZAMZAM

SCALE, 1/2" = 1'

Supports under pillars to Surveyors satisfaction

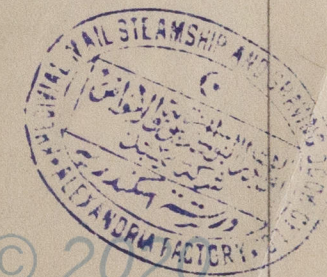

© 2020
DRG: N° 1578.



Lloyd's Register
Foundation

W98-0119

SS Zamzani,

Dr So rep. No 2019

W98-0119



© 2020

Lloyd's Register
Foundation