


T. S. S. ZAMZAM.

SCALE $\frac{1}{2}'' = 1'$

(A)

Offici

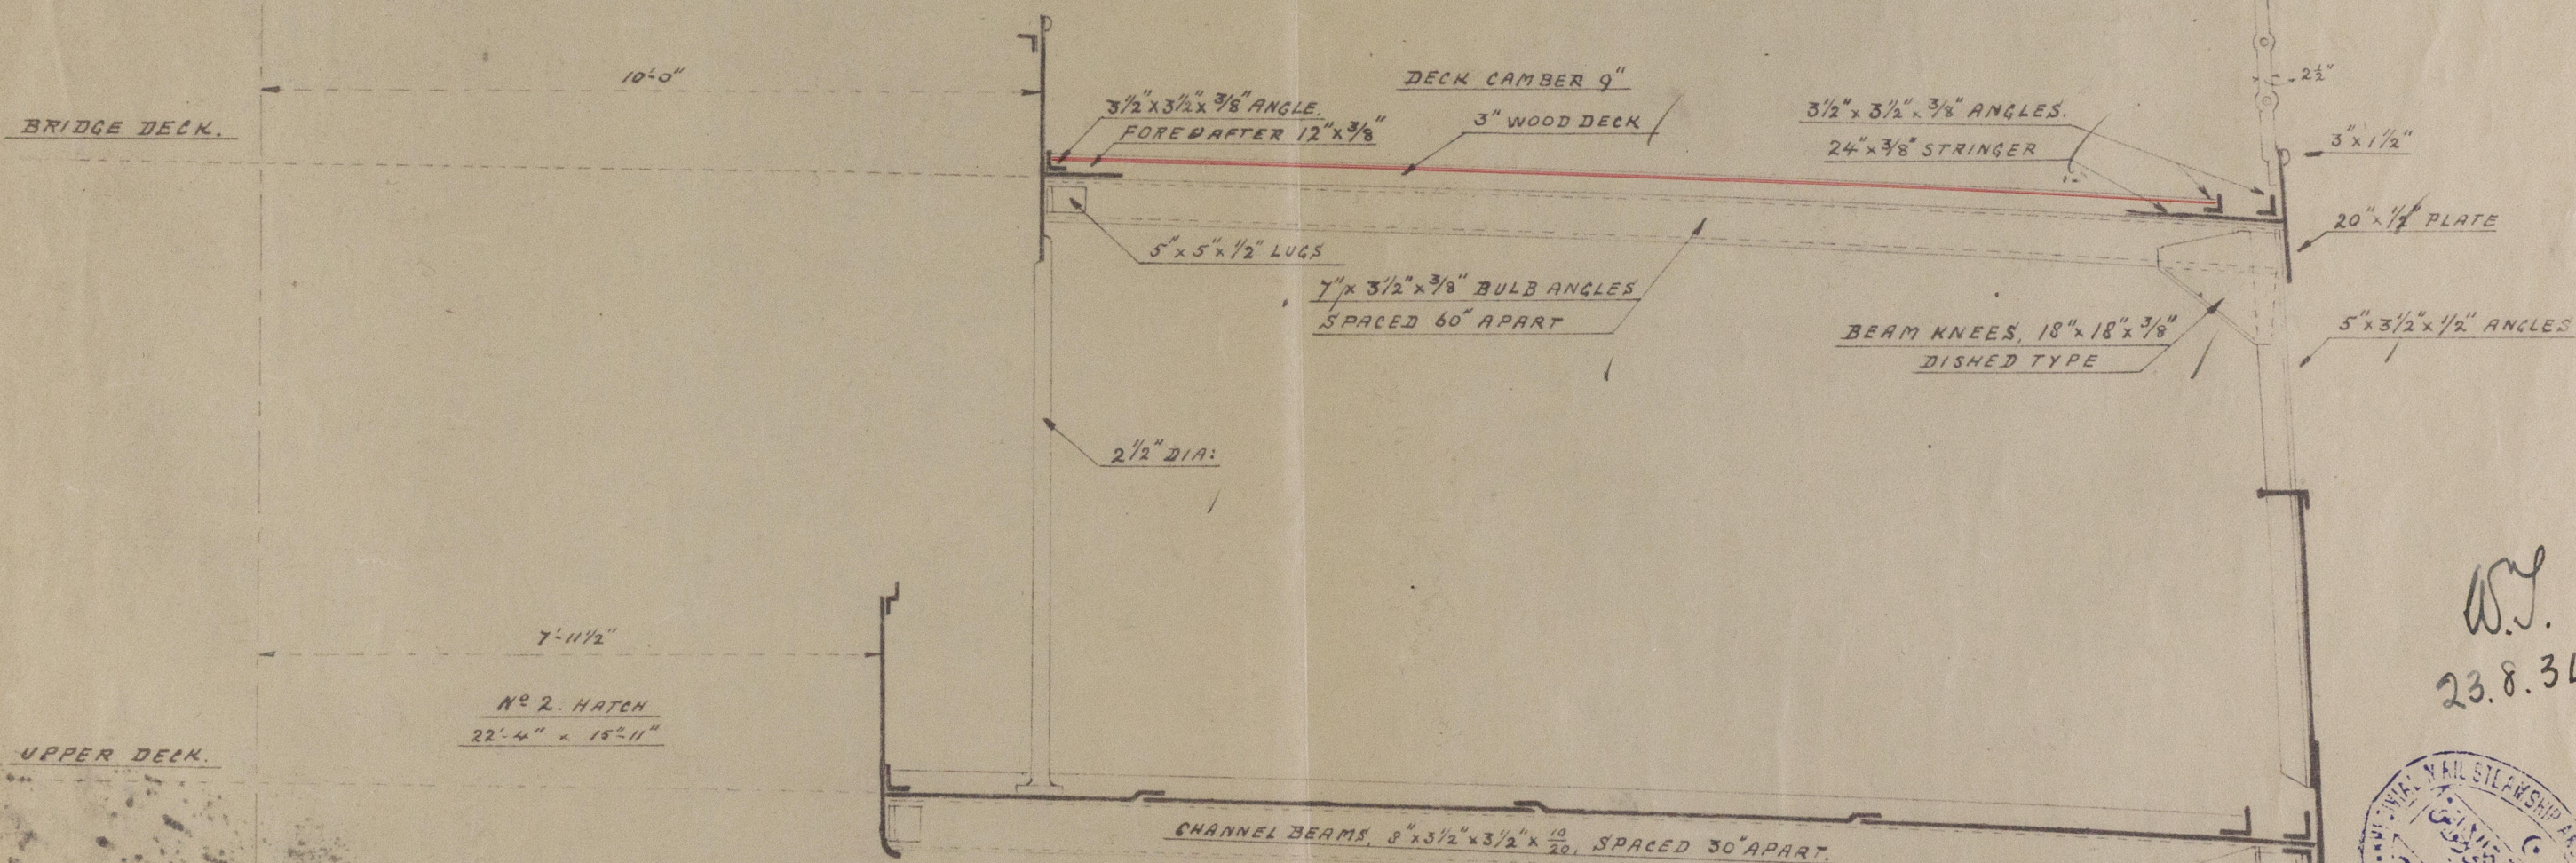

Supports under hulls to Surveyor Satisfaction

SECTION VIEW AT A. B. SHOWING STRUCTURE OF BRIDGE DECK EXTENSION FOR
FROM FRAME Nº 63 TO 32.



ARG. Nº 1576

Lloyd's Register
Foundation

W98-0120

S.P. Jamzani.

M. S. Ref. No. 2219.



© 2020

Lloyd's Register
Foundation

W98-0120