


HALF PLAN OF Nº 2 HOLD, SHOWING PROPOSED TRANSVERSE & MIDDLE LINE BULK²

SCALE 1/4" = 1'

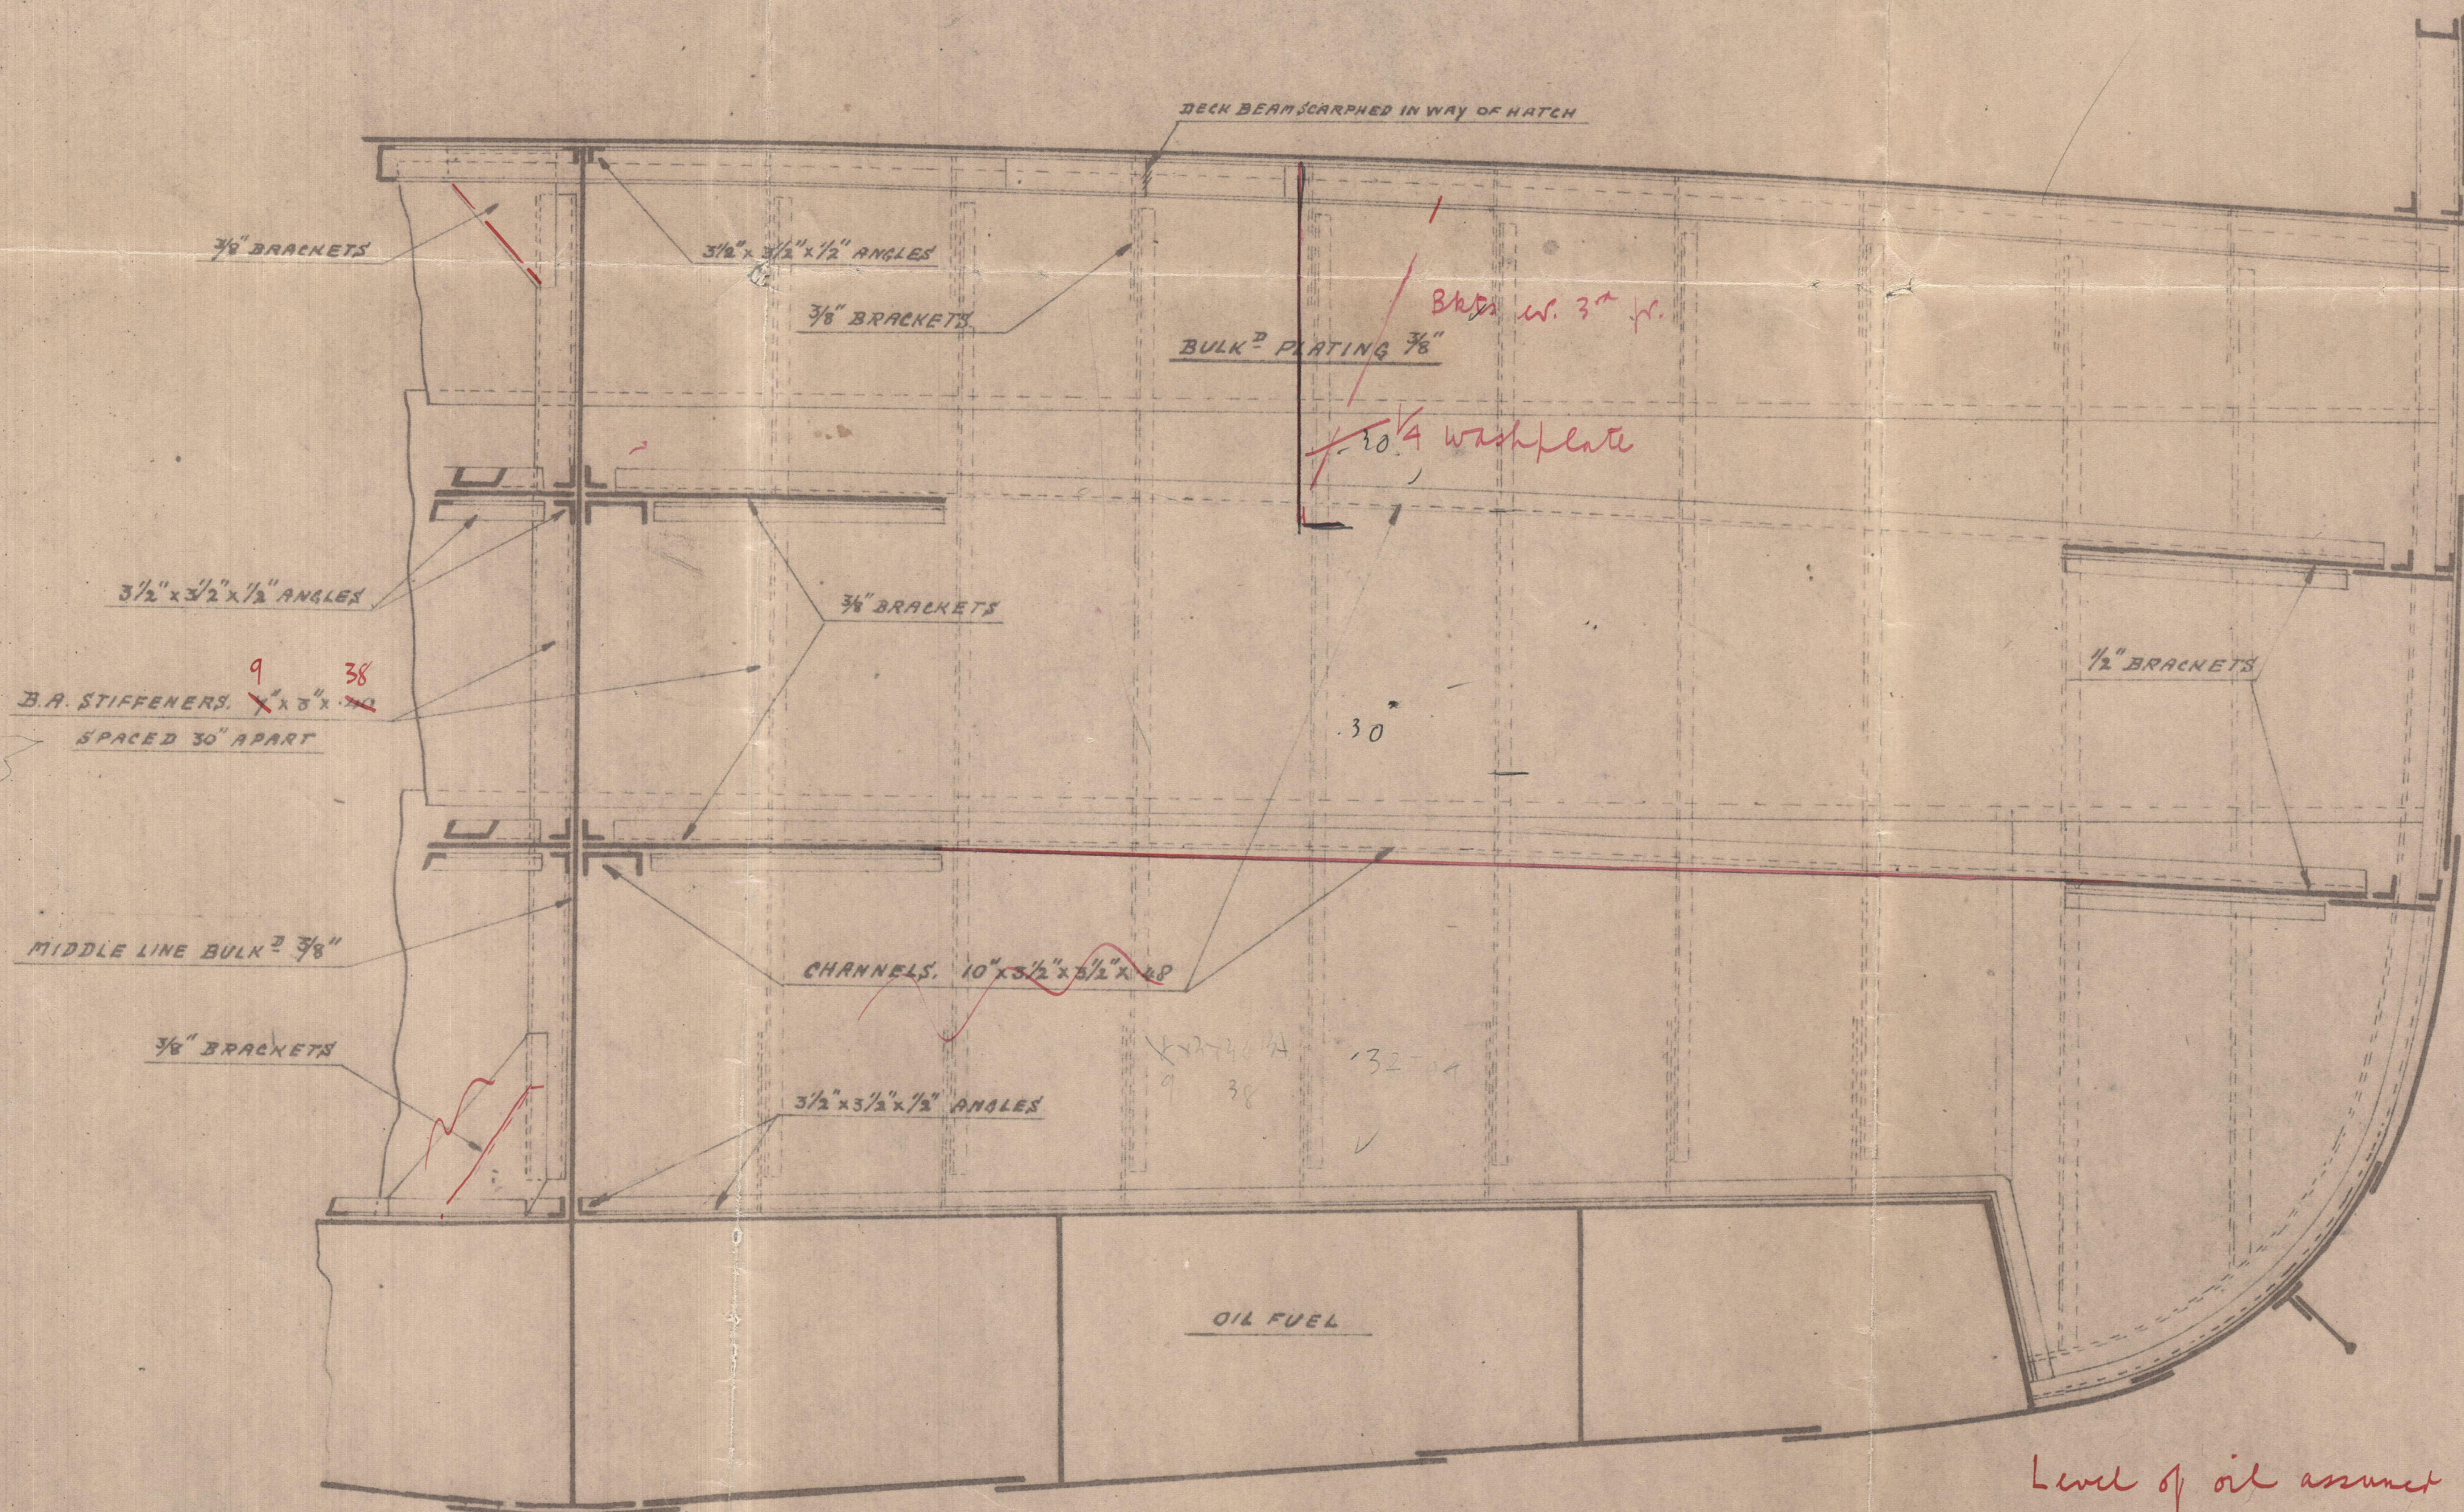

SECTION SHOWING PROPOSED TRANSVERSE BULK² IN WAY OF FRAME 50.

SCALE 1/2" = 1'

PROPOSED CONVERTING, Nº 2, HOLD, TO CARRY OIL IN BULK

T.S.S. ZAMZAM

THE FLASH POINT OF THE OIL FUEL TO BE CARRIED SHOULD BE NOT LOWER THAN 150°F AND THE REQUIREMENTS OF SECTION 20 OF THE RULES SHOULD BE COMPLIED WITH.

NOTE: BULKHEADS, DECK PLATING & ANGLES AT THE CORNERS TO BE ELECTRIC WELDED



K. M. L. WORKSHOPS.

ALEXANDRIA, 2. 9. 34.

DRG. Nº 1582.

Lloyd's Register Foundation

W98-0121

ZAMZAM

S.S. Zamzam

Pt. Ld. Regt. No 2219



© 2020

Lloyd's Register
Foundation

W18-0021