



PLAN OF NO 5 HOLD, SHOWING PROPOSED STRUCTURE  
SCALE, 1/4" = 1'

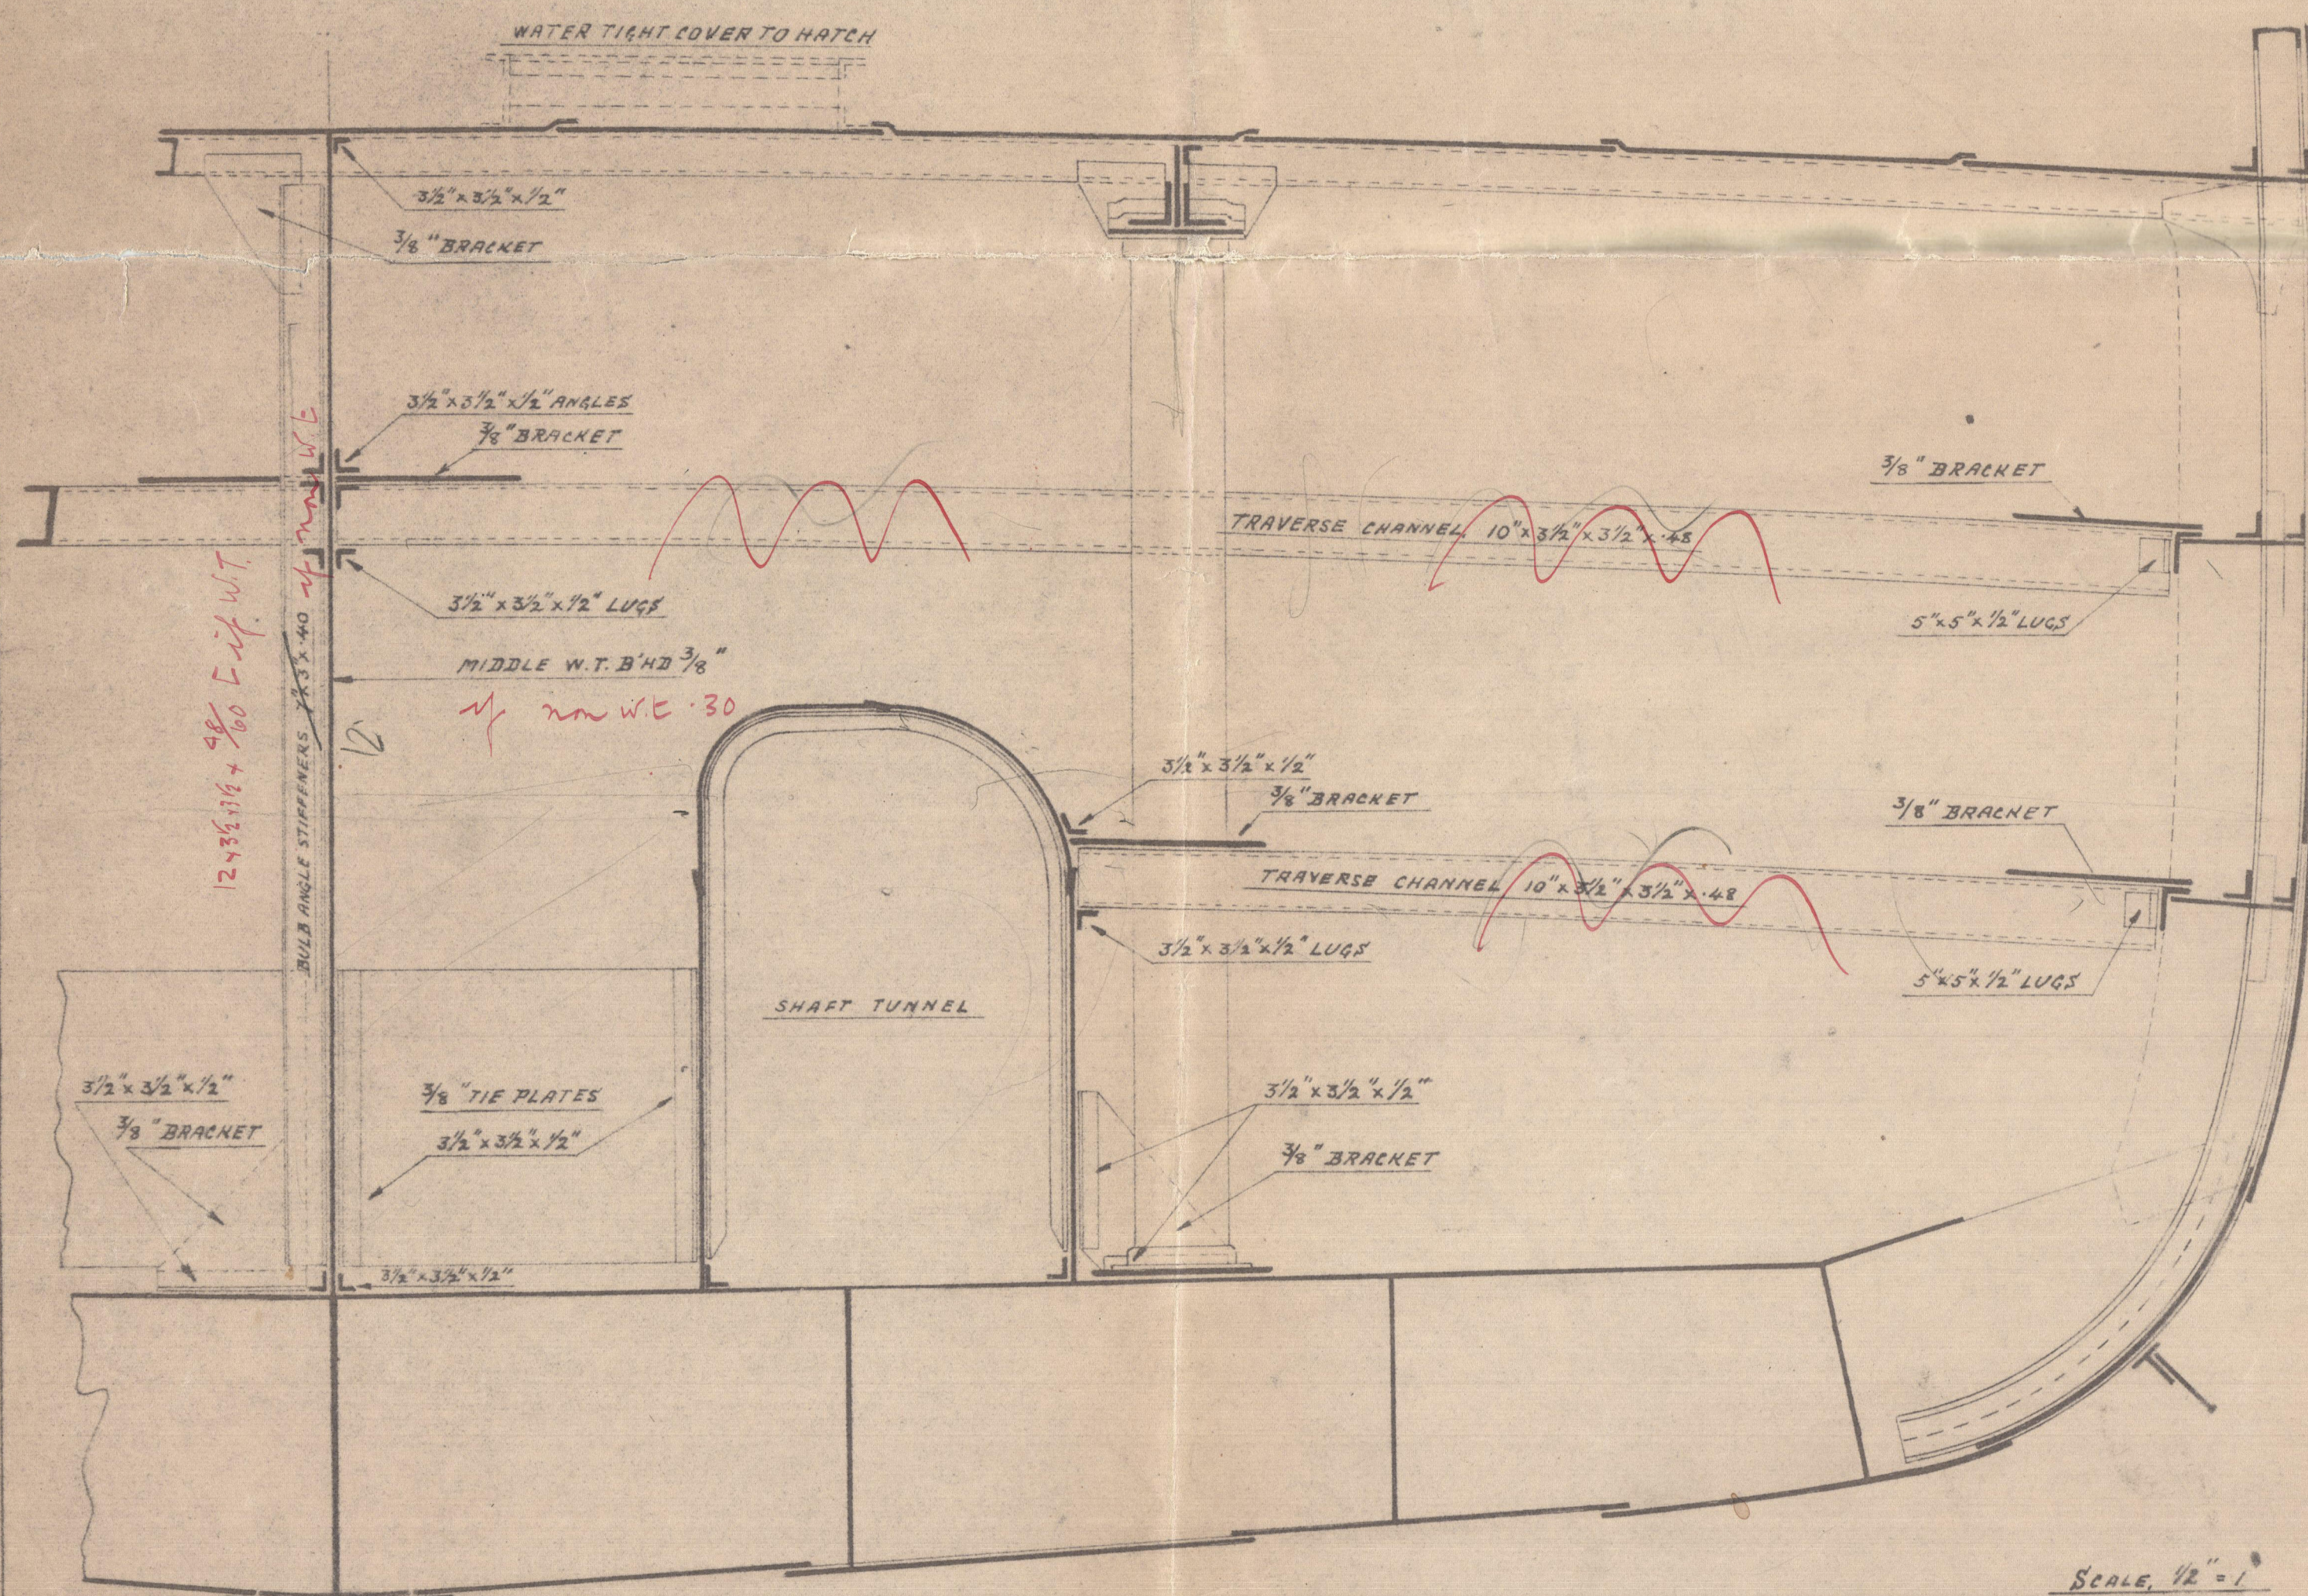


SECTION THROUGH NO 5 HOLD.

SCALE, 1/2" = 1'

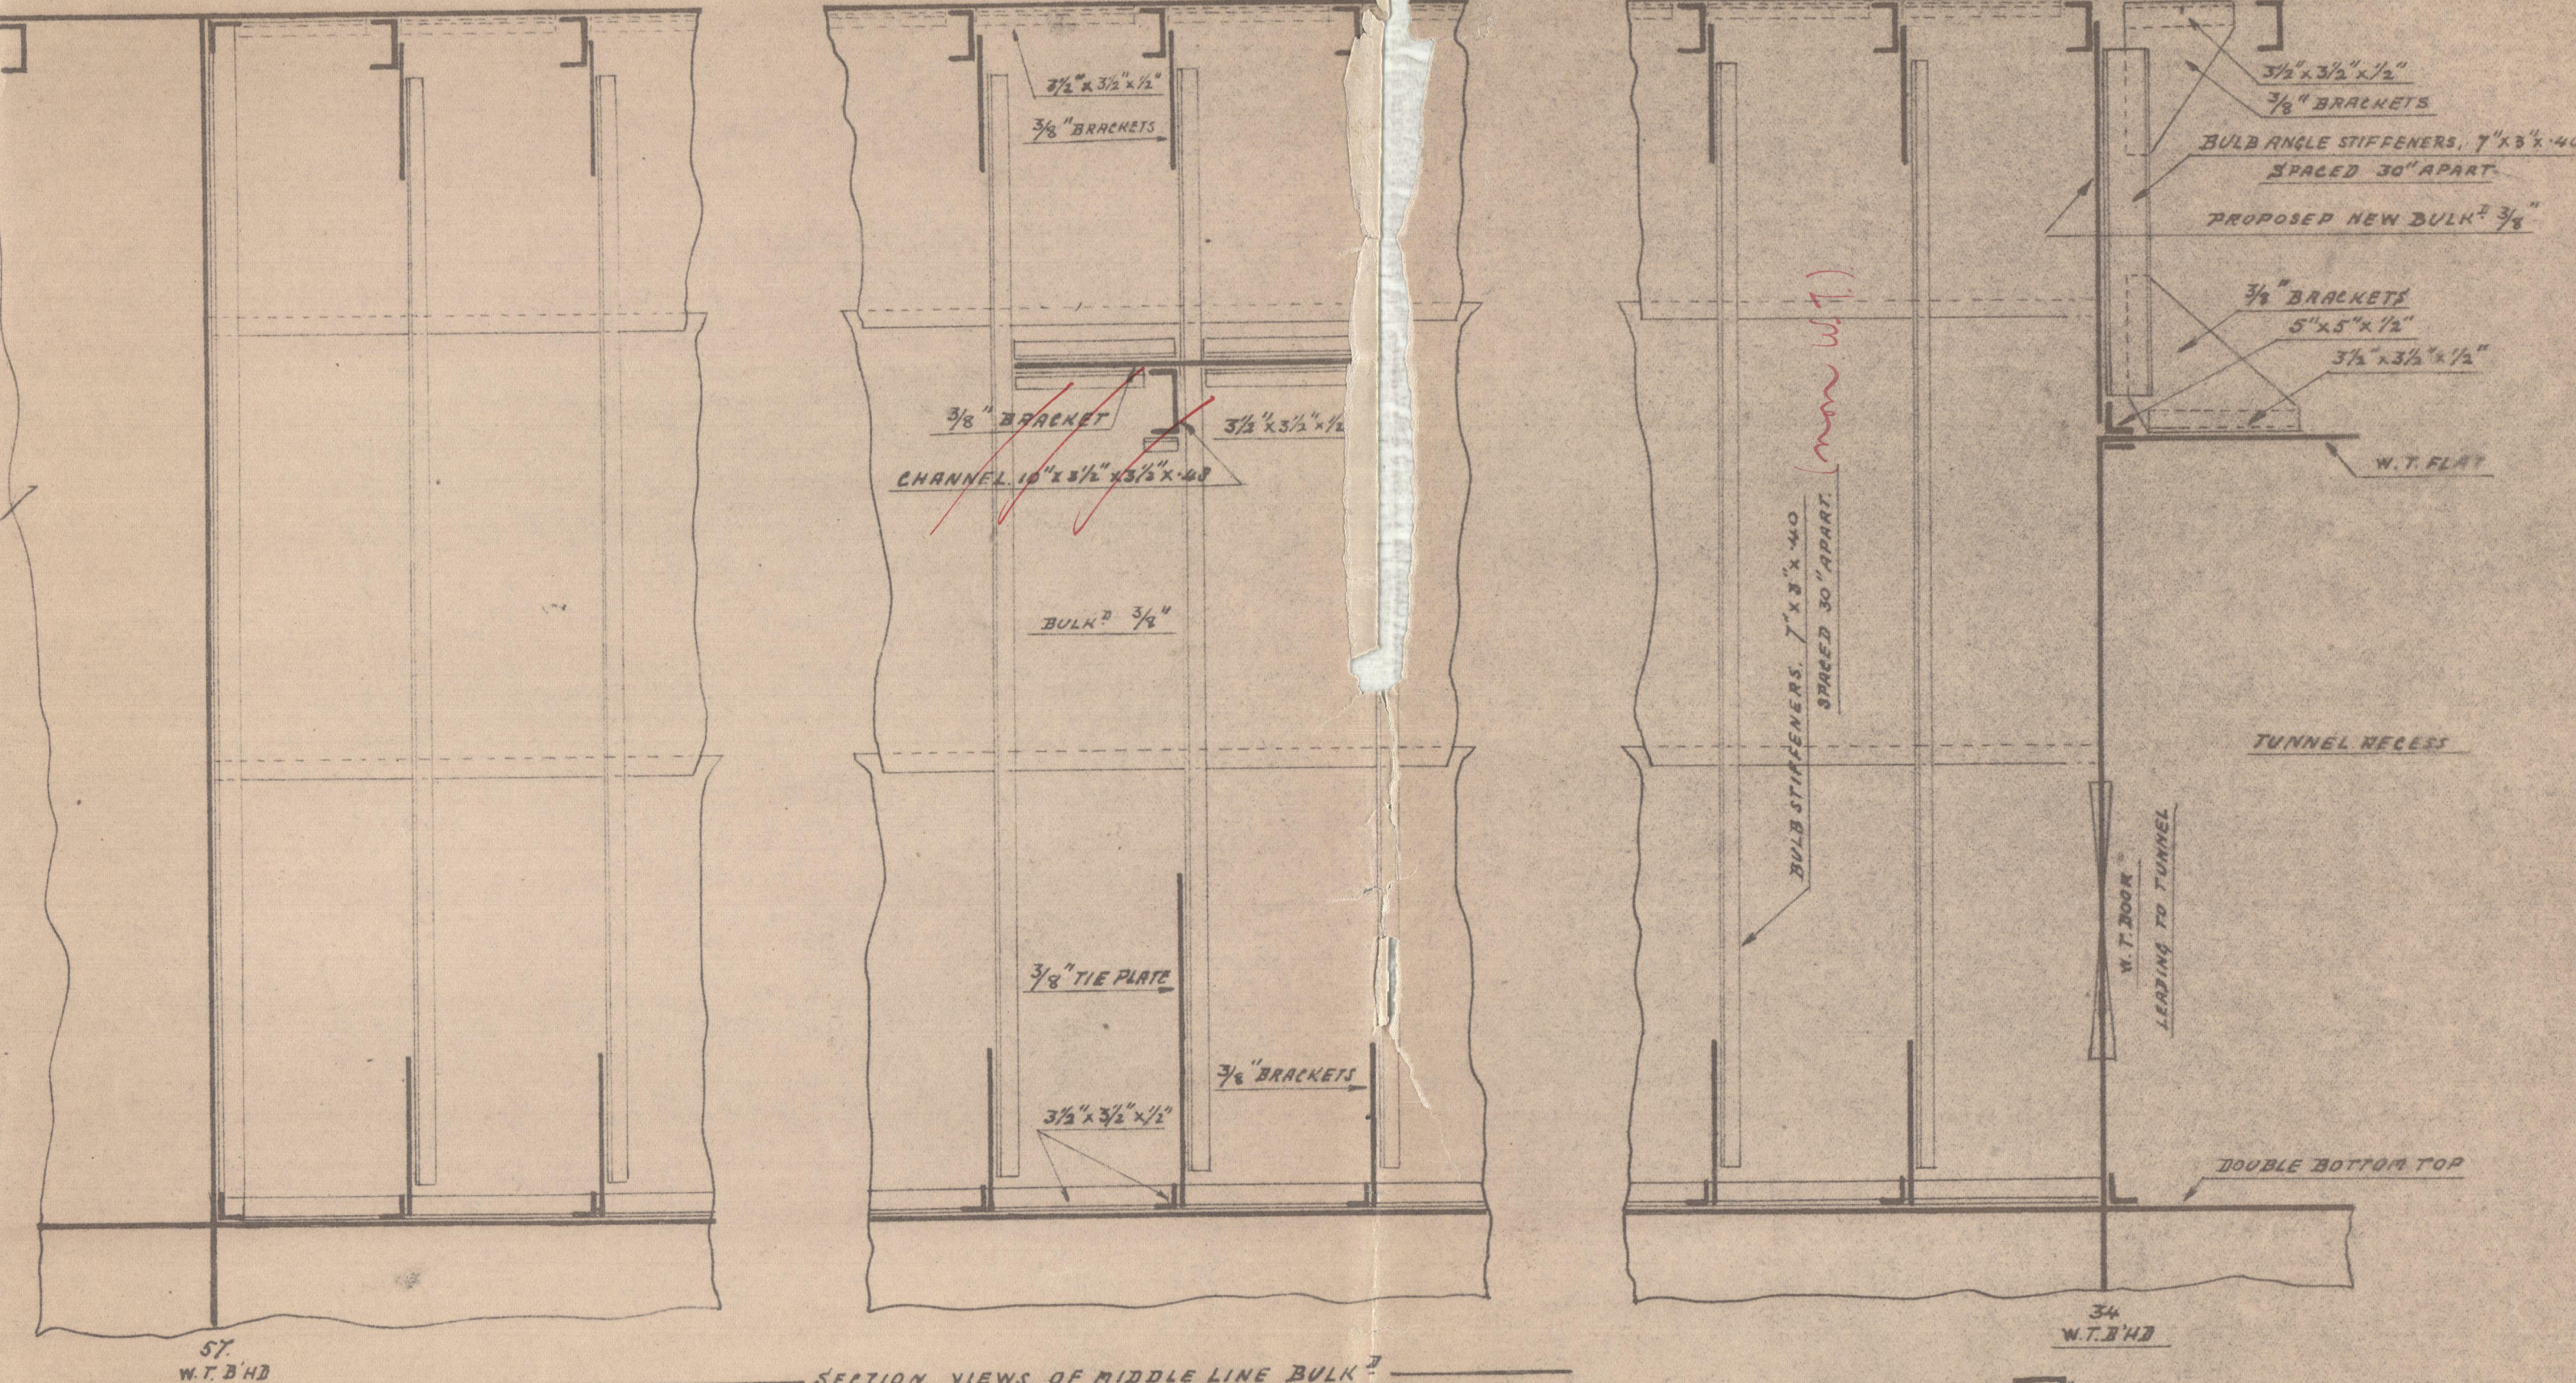

SECTION VIEWS OF MIDDLE LINE BULKHEAD

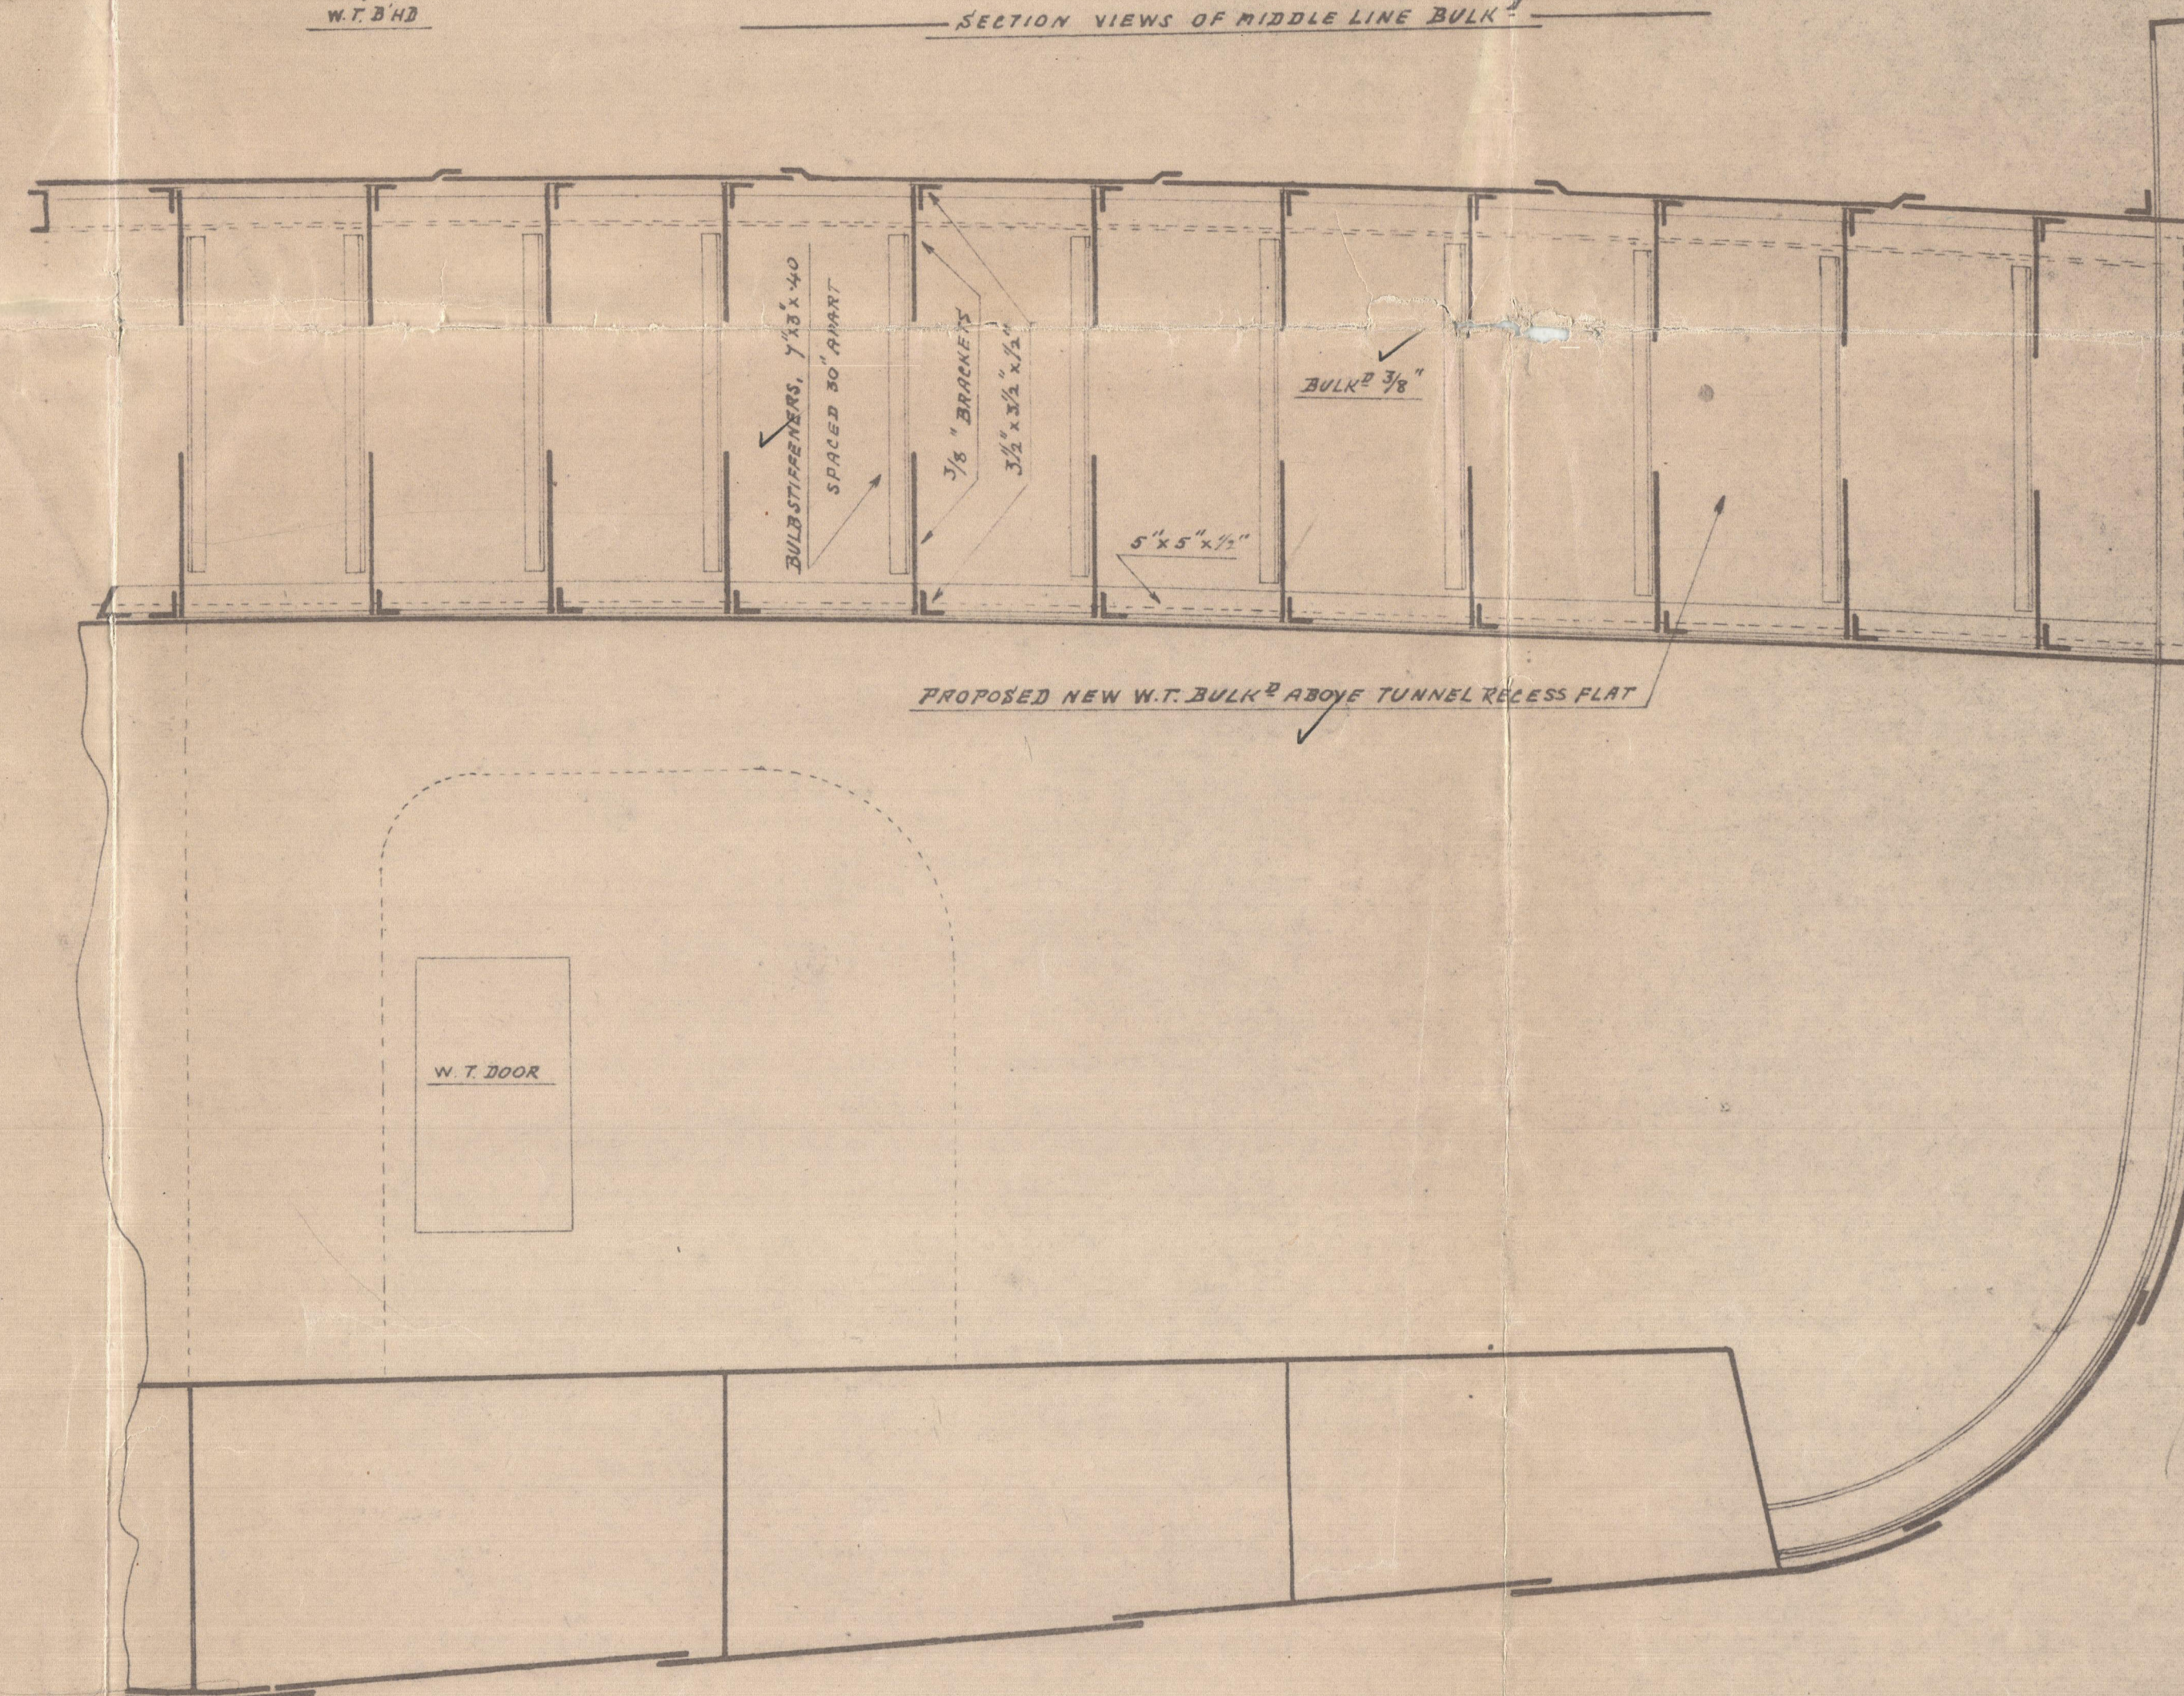

EXISTING W.T. BULKHEAD FRAME 34 IN TUNNEL RECESS

PROPOSED CONVERTING NO 5 HOLD INTO F.W. DEEP TANK.

T.S.S. ZAMZAM



ZAMZAM

S.P. Zamzam.

Atto - up No. 2219.



© 2020

Lloyd's Register  
Foundation

W98-0125