

— N^o 403 —
-MIDSHIP SECTION-

T.S.S. 467'-0" x 54'-0" x 35'-6" (KEEL TO BEAMS)

TO CLASS 100 A.1. AT LLOYDS THREE DECK RULE

SCALE $\frac{1}{2}$ " = ONE FOOT.

NUMERALS.

$27.0 + 35.5 + 57.4 + 1.12 - 7 = 114.02$ FRAMING NO


$114.02 \times 464.96 = 53014.73$ PLATING NO

$121.02 \times 464.96 + 6515 = 62784$ EQUIPMENT NO

PROPORTIONS

BREADTHS TO LENGTH = 8.6 ✓

DEPTHS TO LENGTH = 12.96 TO UPPER DECK

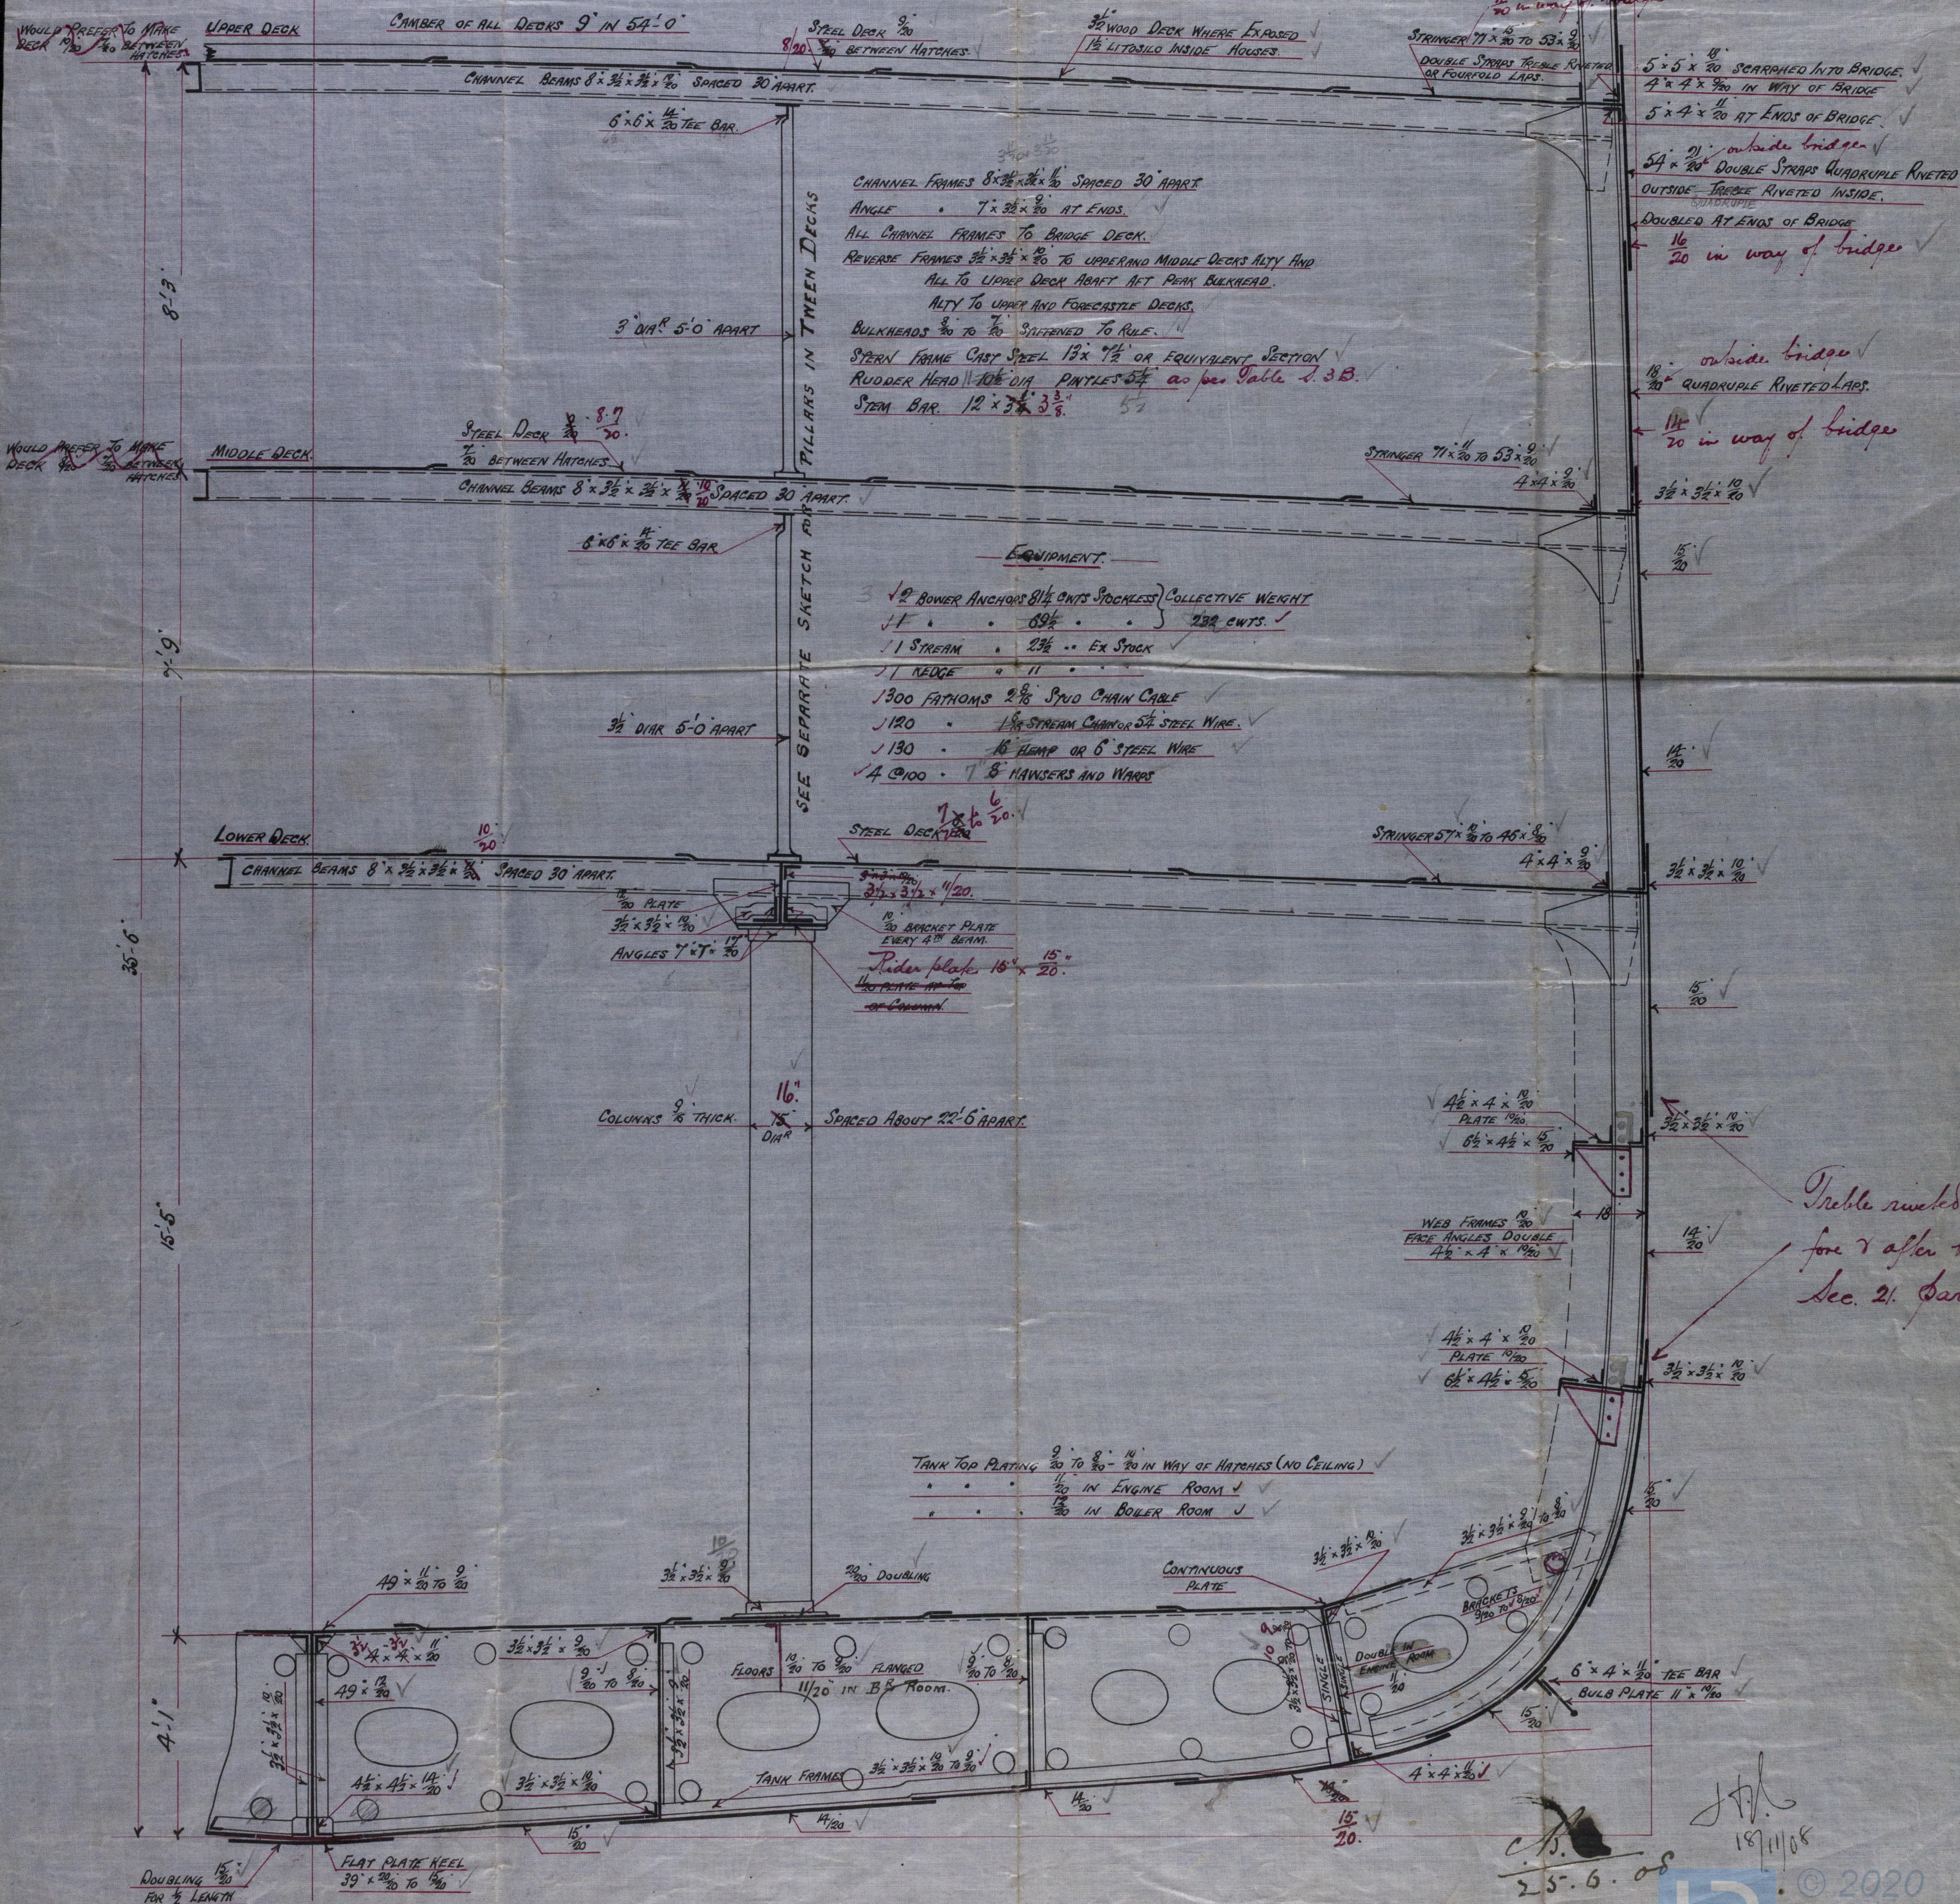

Treble riveted in
fore & after bodies
Sec. 21. Para. 6.

J.H.
18/11/08

25.6.08

Lloyd's Register
Foundation

W98-0132

Messrs Harland & Wolff

N^o 1403.

Midship Section

St. Leicestershire

Bel Rep! bbs.

W98-0132



© 2020

Lloyd's Register
Foundation