





17.8.08.

— ALTERNATIVE ARR^{ng} of TWEEN DECK COLUMNS INSTEAD OF STANCHIONS. —

— N^o 403. —

— SCALE $\frac{1}{2}$ " = 1. FOOT. —

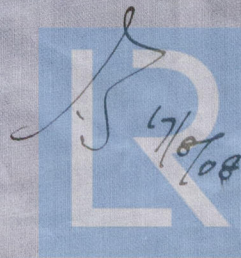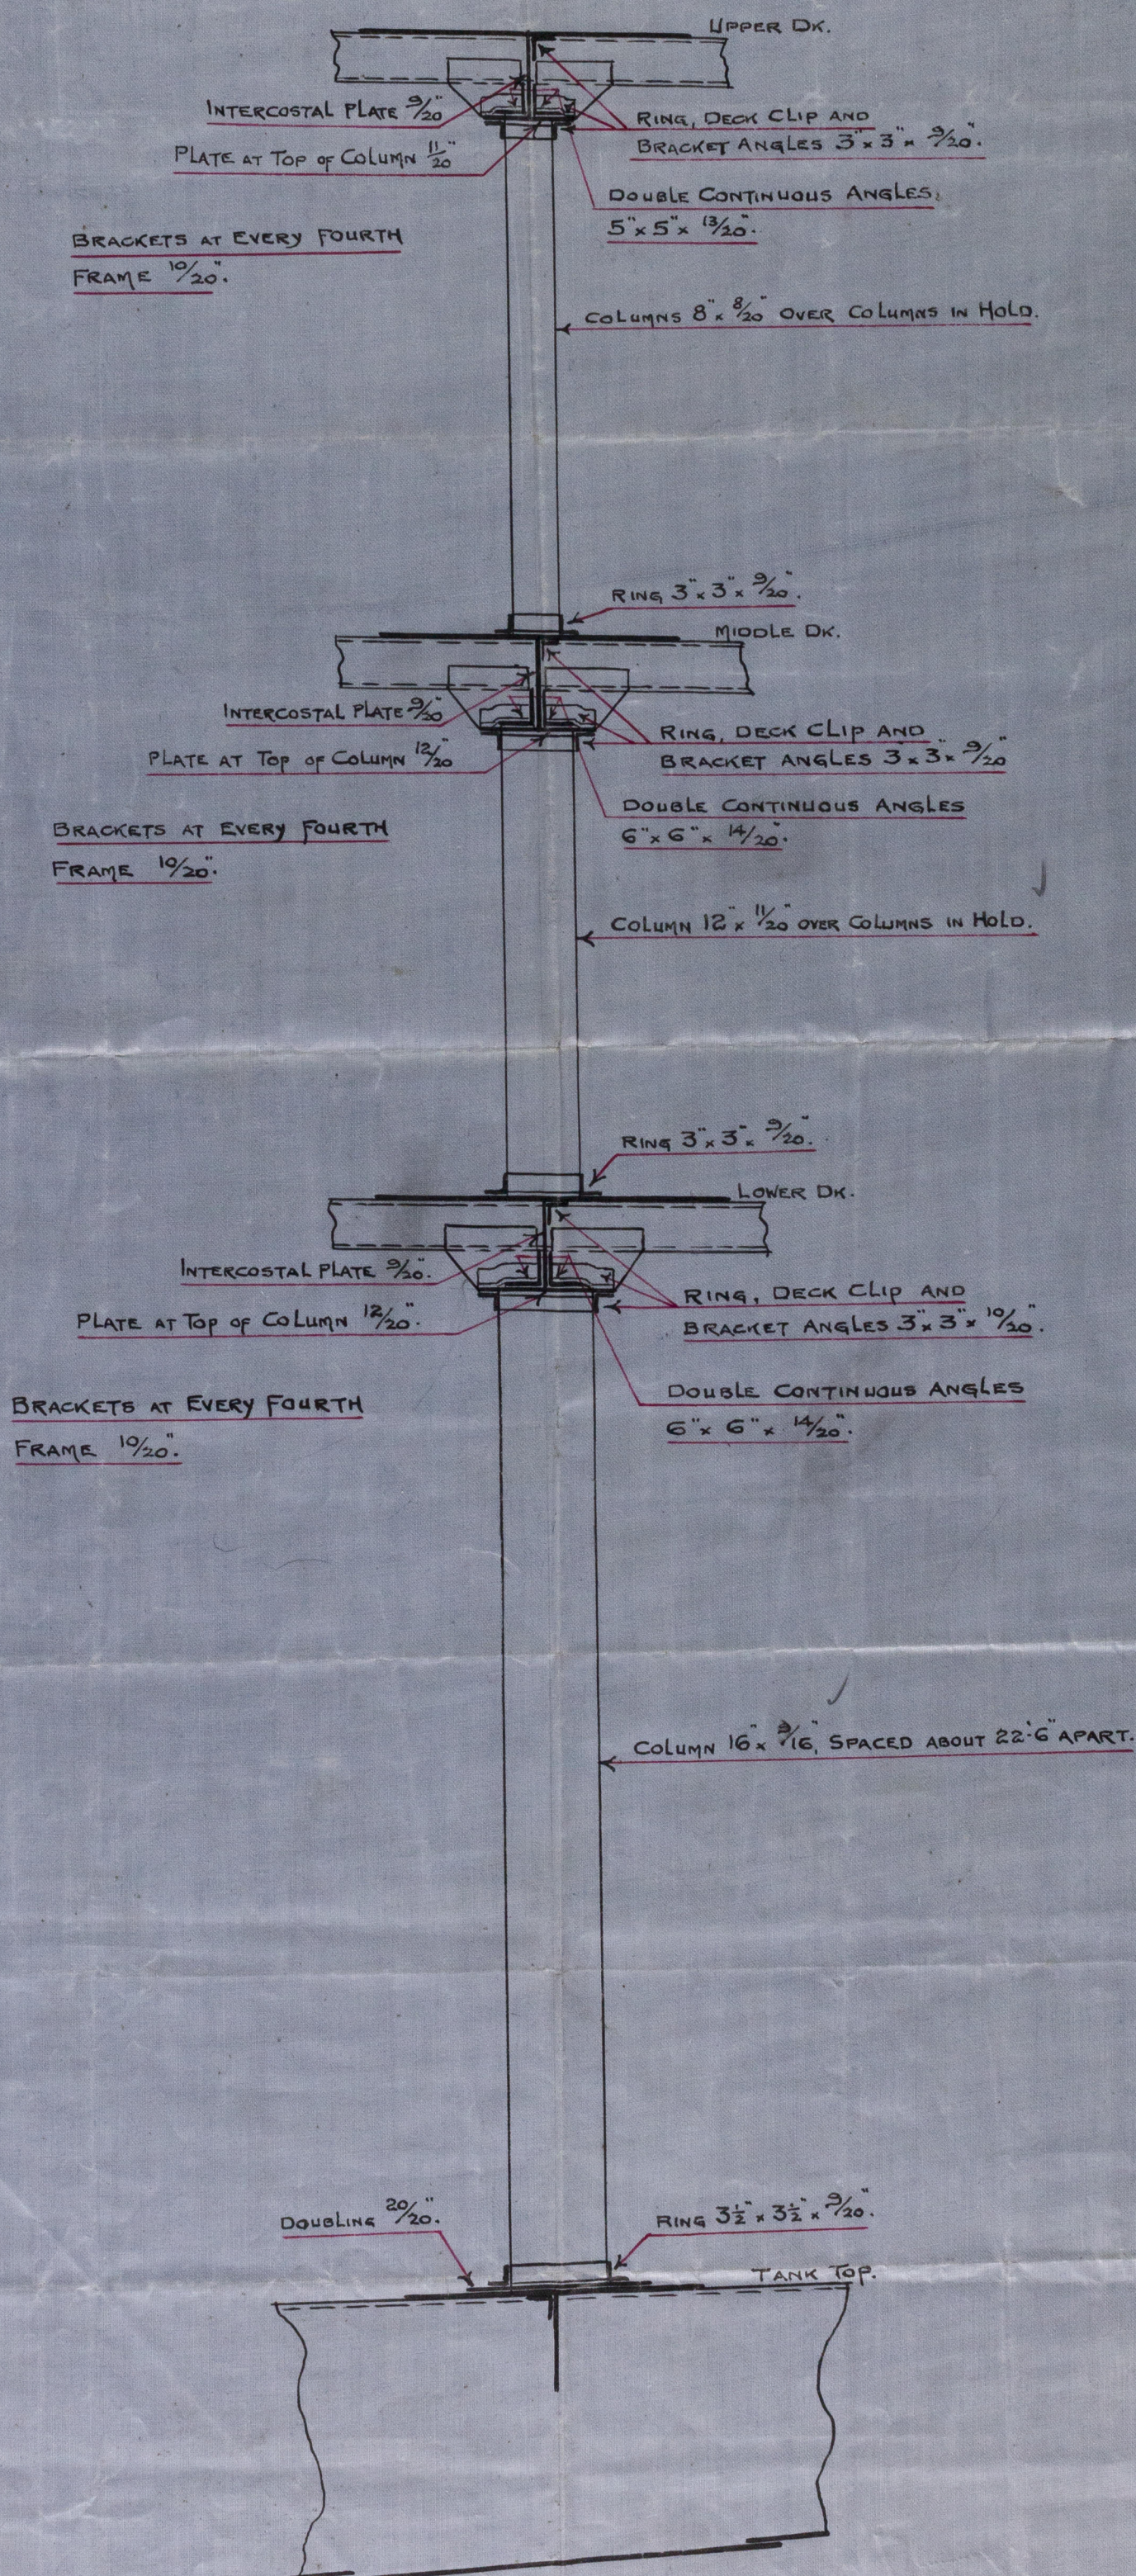

© 2020


Lloyd's Register
Foundation

W98-0133

Messrs Harland & Wolff

N^o 403.

Alternative arrangement of pillars

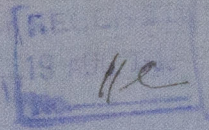

© 2020

Lloyd's Register
Foundation

98-0133