

# SHIP No 188.

## PROFILE & DECKS.

DIMENSIONS: - LENGTH L.W.L. 396'0", BREADTH M<sup>ld</sup> 54'10", DEPTH 27'5 1/2" + 8'7"

TO CLASS +100 A.L. LLOYDS WITH FREEBOARD C.S.S. TYPE.

SCALE - 1/8" = 1 FOOT

**BULKHEAD SCANTLINGS.**



NO.	HEIGHT ABOVE BASELINE	LENGTH	THICKNESS	STIFFENING	SPACING	ON ANGLE	FRAMES	TT. ANGLE	SKTS.	RIVETS.
40	25' 2"	29	30" x 39"	11" x 3/4"	30"	5" x 3/4"	35" x 3/4"	8" x 3/4"	7/8" x 3/4"	7/8" x 3/4"
62	25' 3"	29	"	"	"	"	"	"	"	"
86	24' 11 1/2"	29	"	"	"	"	"	"	"	"
130	24' 11 1/2"	29	36" x 39"	"	"	"	"	"	"	"
131	24' 11 1/2"	29	36" x 39"	"	"	"	"	"	"	"
ALL BULB ANGLES ARE 1924 STANDARD.

WINDHES, WINDLASS, MASTS, STEERING GEAR, SUPPORTED TO SURVEYORS SATISFACTION.

SEE SEPARATE PLAN FOR OR GRIDERS, HOLD & TWEEN OR.

PILLARS

 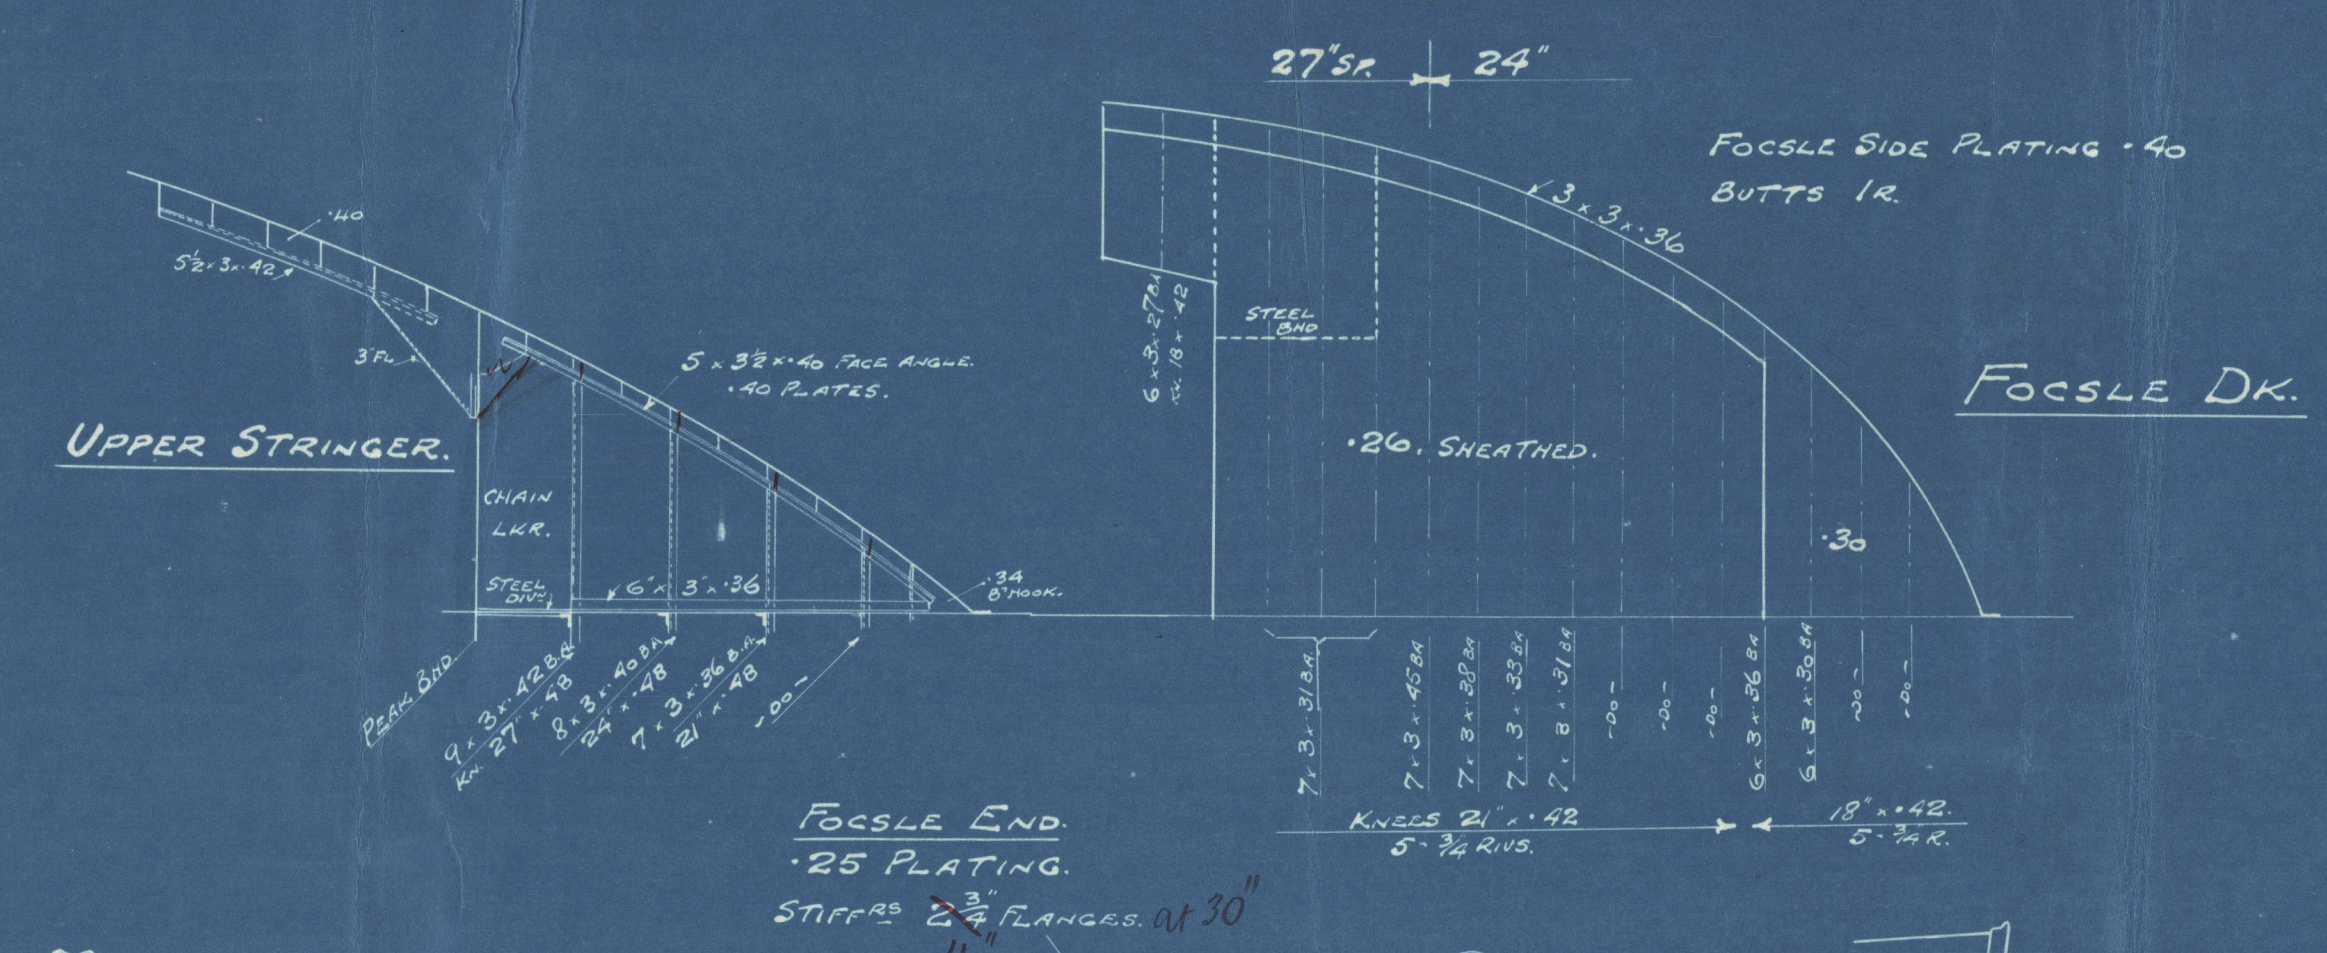



⑥  
BURNT ISLAND. SECOLA  
No 188  
PROFILE & DECKS

s.s. "Woodbury"

Lith. Rpt. No. 18988.



© 2020

Lloyd's Register  
Foundation

W98-0163