
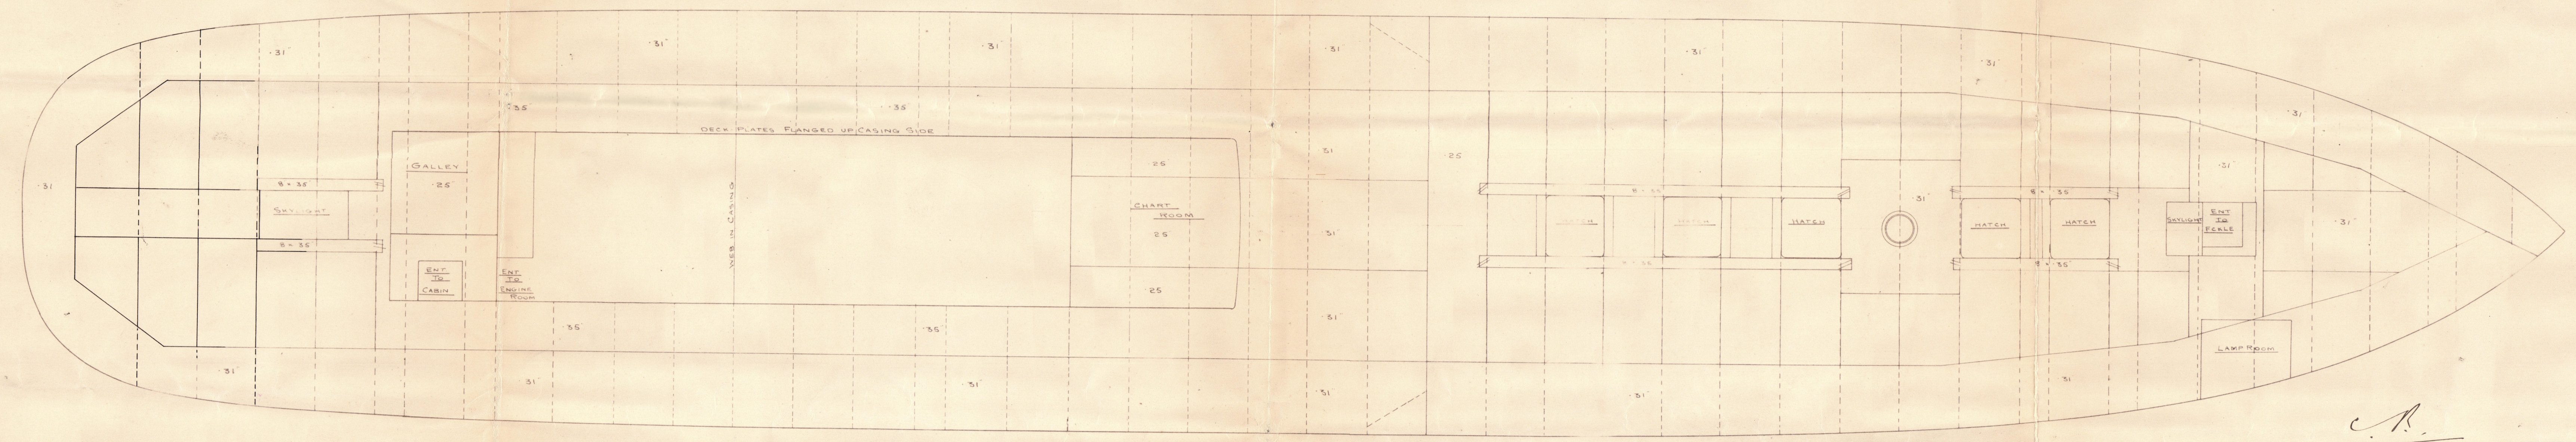


7.10.13.

PROFILE & DECK PLAN
N° 595
DIMS 136'8" BP x 24'0" EXT x 13'3" MLD
SCALE 1/4" INCH

PLAN No. 3437
FOR ENCLOSURE TO
Messrs Lloyd's Surveyors
Hull FROM
COCHRANE & SONS, LTD.
SHIPBUILDERS, SELBY.
DATE 7.10.13.

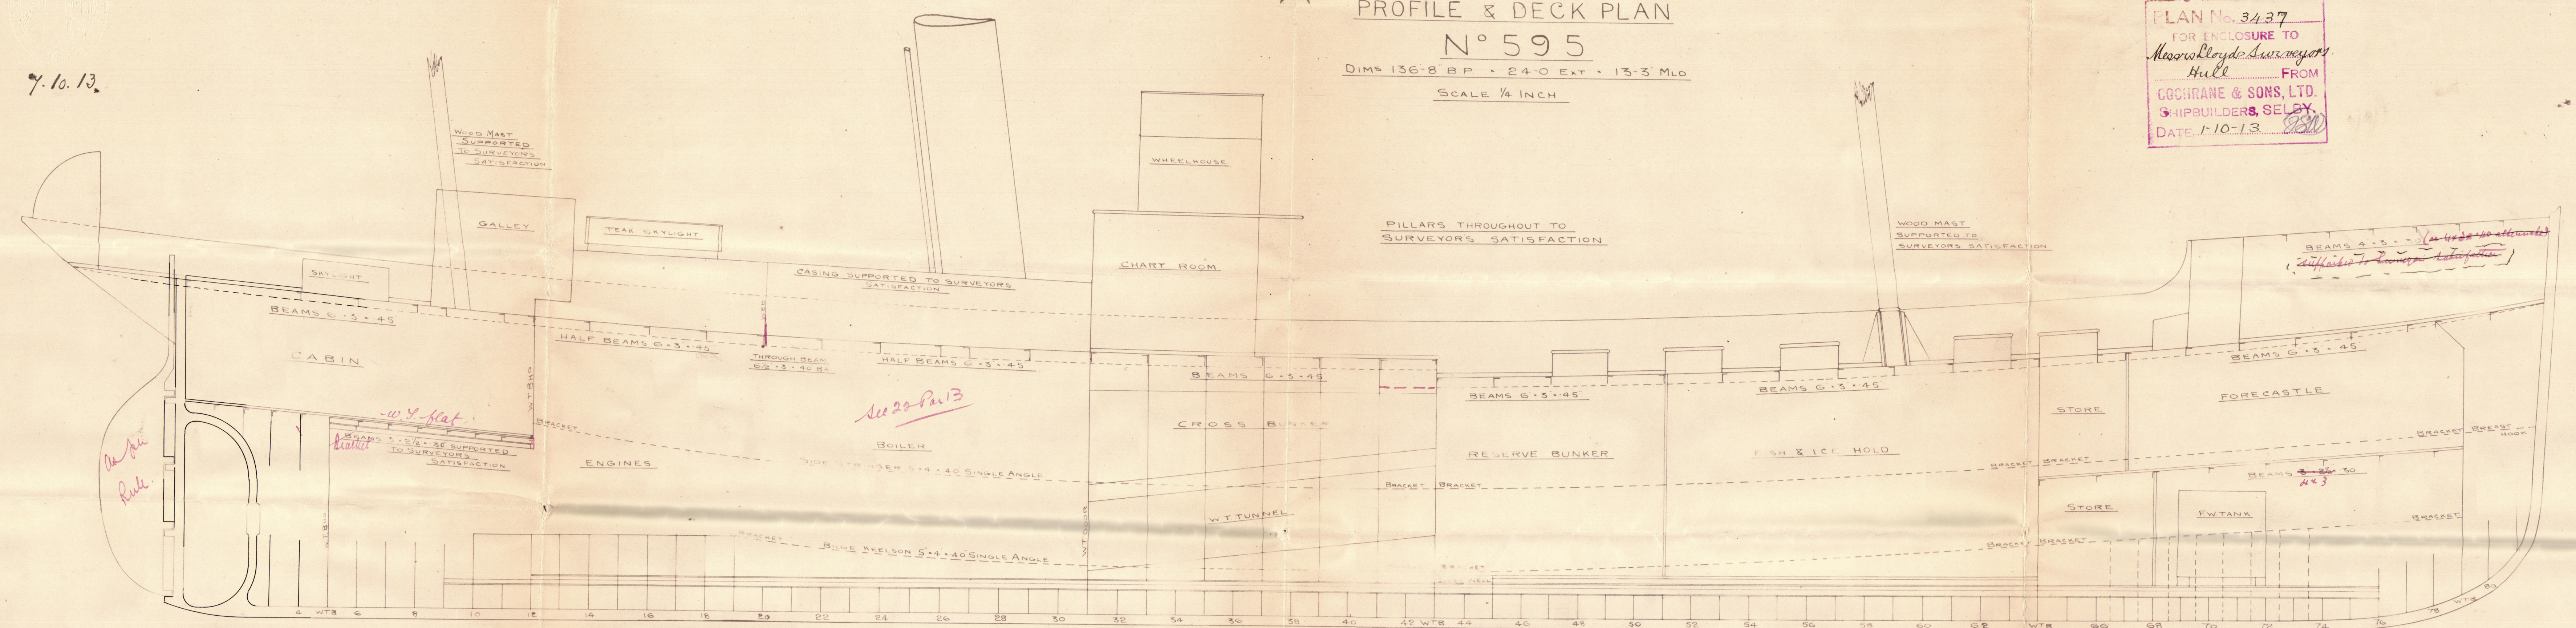

C.R.
7.10.13.



© 2020

Lloyd's Register
Foundation

Cochrane & Sons.

Nº 595

Profile & Decks.
Wimereux

136.66 x 23.87 x 13.25.

s/s Andromache
Hull Rpt No. 27293



w981-0104

RETAIN



© 2020

Lloyd's Register
Foundation