



7.10.13.

# MIDSHIP SECTION

STEEL SCREW TRAWLER


N° 595

DIMS 136-8" B.P. x 24-0" EXT. x 13-3" MLD

SCALE 1/2 INCH

TO CLASS 100 A1 STEAM TRAWLER  
ENGINE & BOILER CASING AS PREVIOUSLY APPROVED  
DECK PLATED OVER IN WAY OF MACHINERY SPACE

PLAN No. 3436  
FOR ENCLOSURE TO  
*Messrs Lloyd's Surveyors*  
Hull FROM  
COCHRANE & SONS, LTD.  
SHIPBUILDERS, SELBY.  
DATE 1-10-13. *BSN*

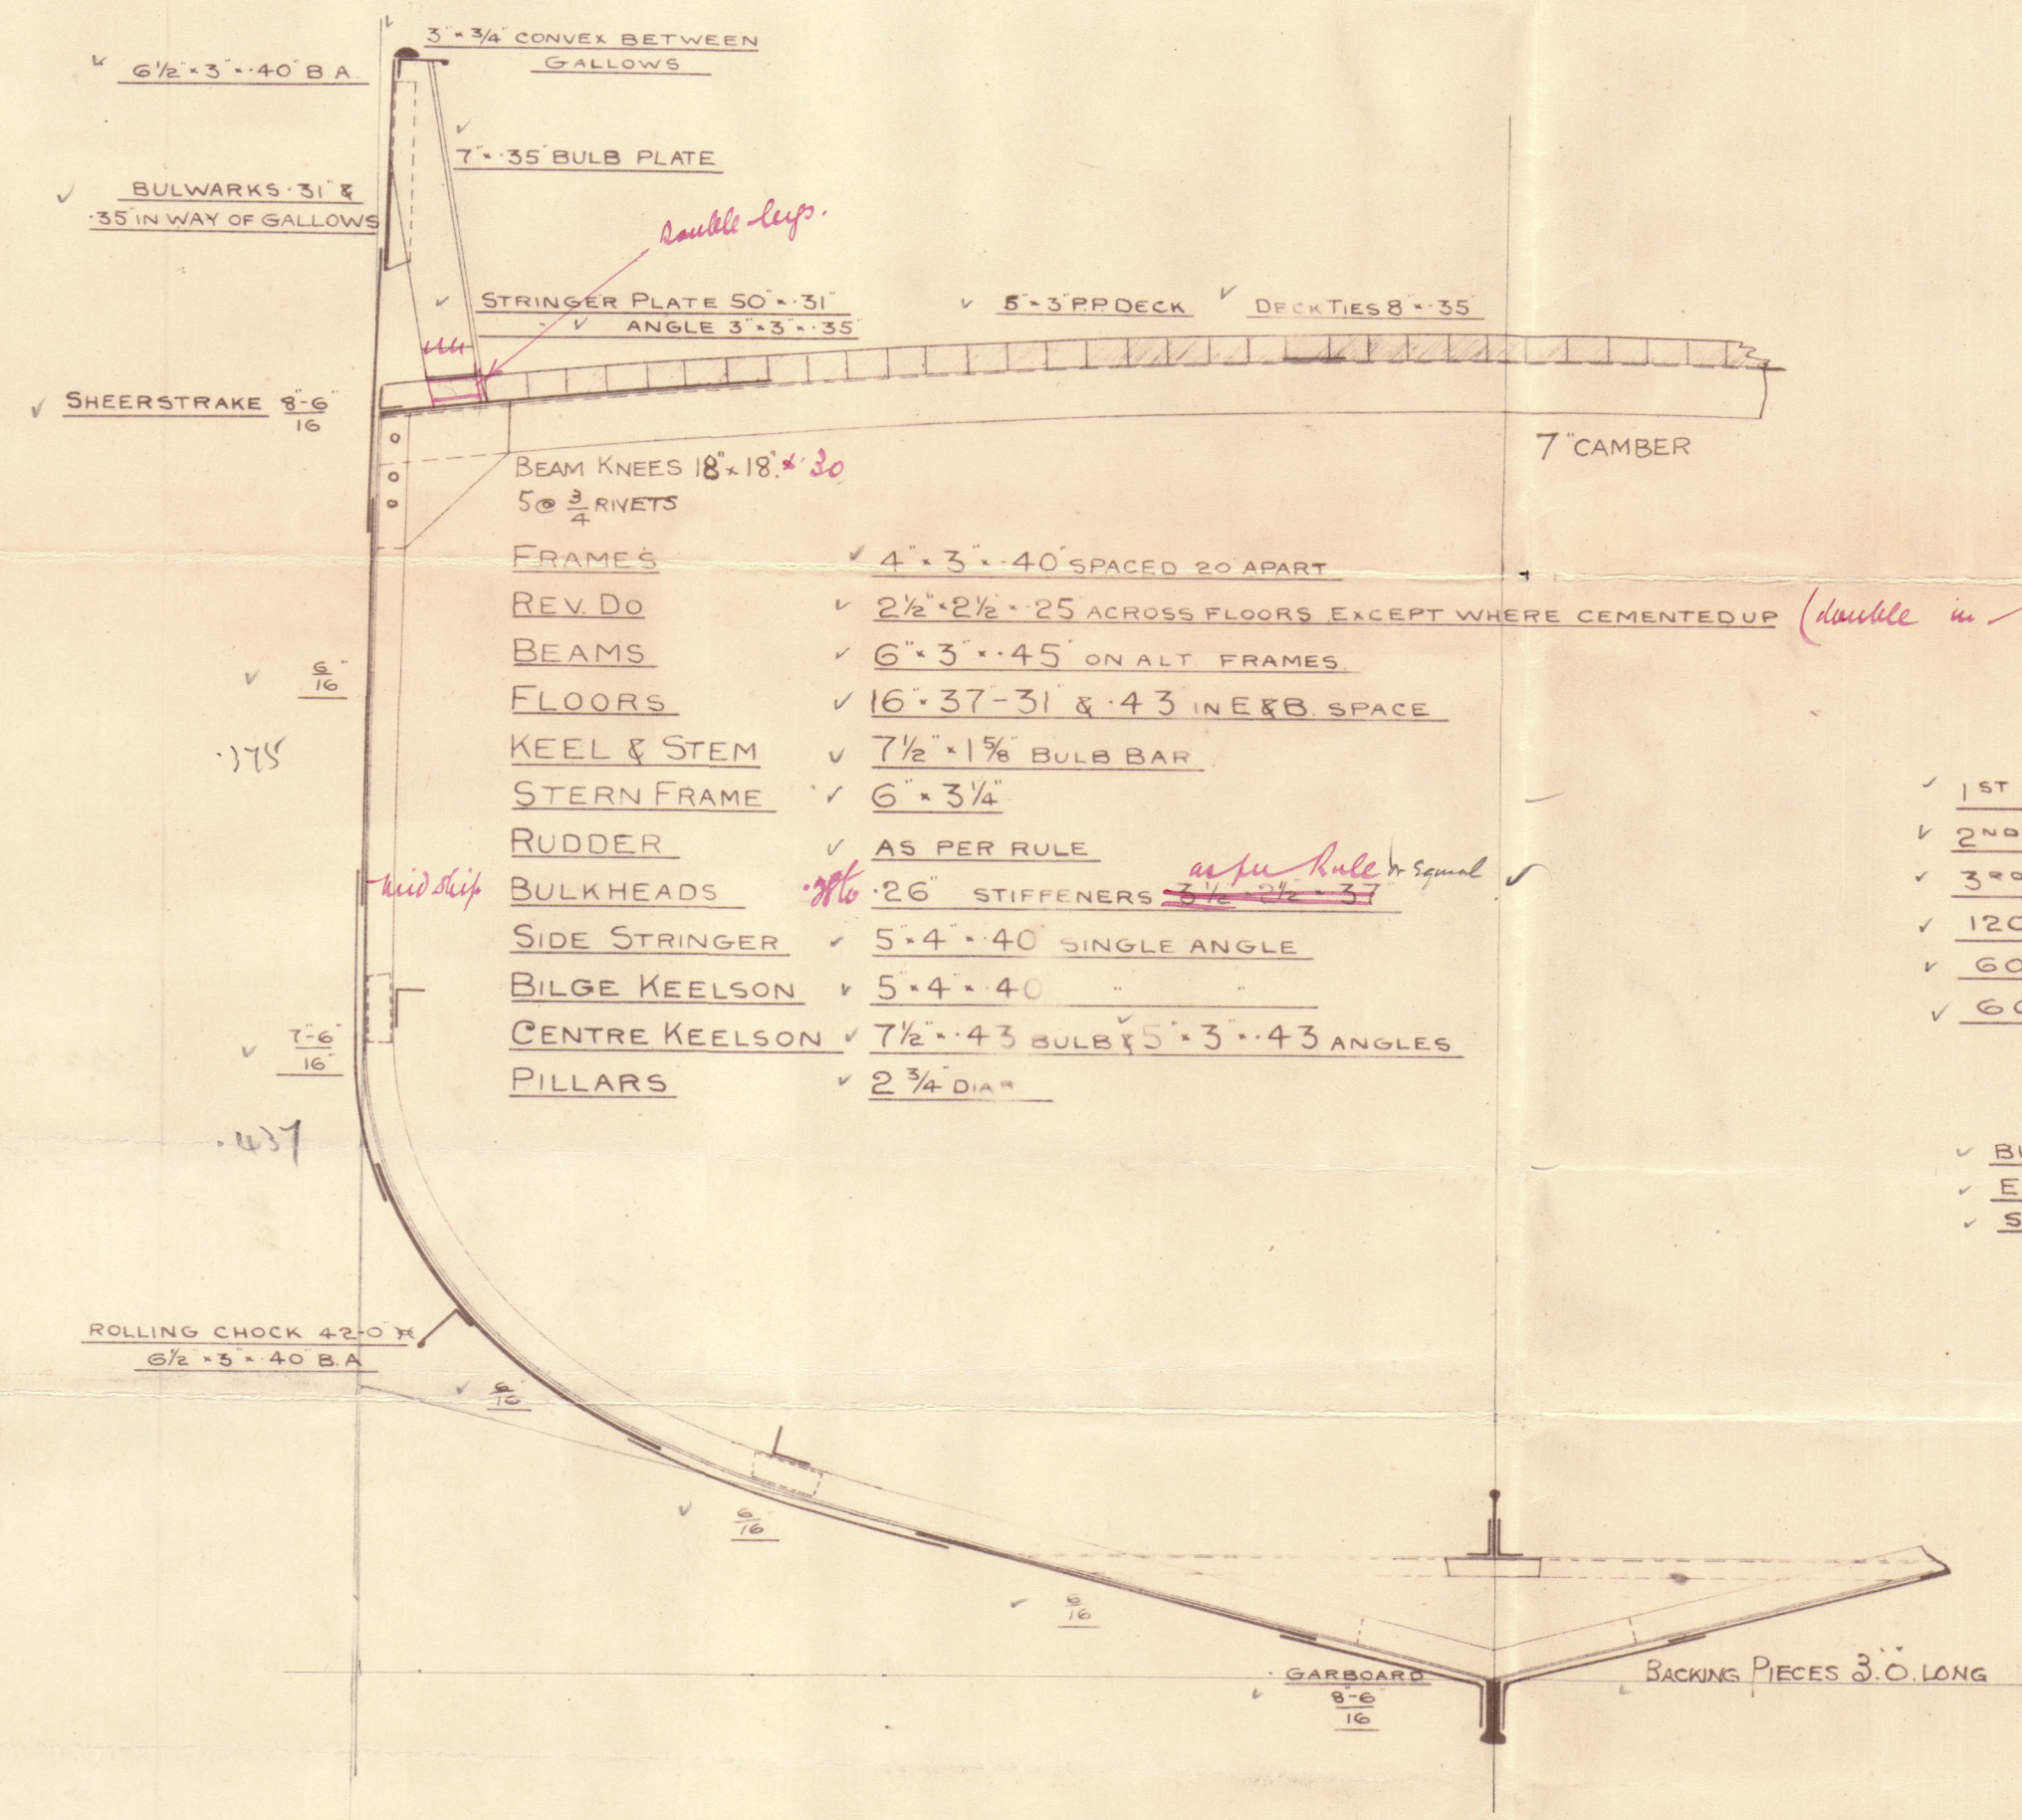

## NUMERALS

✓ B+D 37.12  
✓ L x (B+D) 5072.81

## PROPORTIONS

✓ L 10.31  
✓ B 5.73

## EQUIPMENT

✓ 1ST BOWER ANCHOR 8 CWTs STOCKLESS  
✓ 2ND " 7 1/4 " "  
✓ 3RD " 3 1/4 " EX STOCK  
✓ 120 FATHOMS 1 1/2 / 16 STUD LINK CABLE  
✓ 60 " 6 " HAWSER  
✓ 60 " 5 " WARP

## RIVETING

✓ BUTTS OF SHELL PLATING LAPPED & DOUBLE RIVETED  
✓ EXCEPT GARBOARD & SHEERSTRAKE WHICH ARE TO BE STRAPPED. ✓ LANDINGS DOUBLE RIVETED  
✓ BULWARKS SINGLE RIVETED

*C.B.*  
7.10.13.




Cochrane & Sons  
N<sup>o</sup> 595.


Midship Section

Dimensions  
136.66 x 23.87 x 13.25

s/s "Andromache"  
Hull Rpt. No. 27293

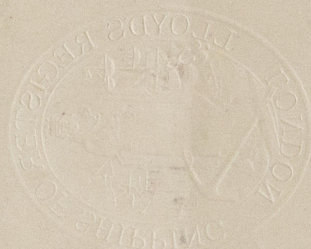


RETAIN

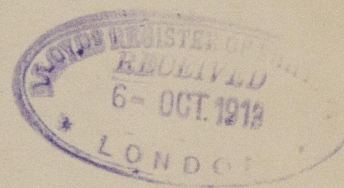

W981-0105



RETAIN

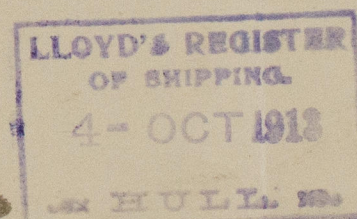

W981-0105



© 2020

Lloyd's Register  
Foundation





7.10.13.

# MIDSHIP SECTION

STEEL SCREW TRAWLER

N° 595

DIMS 136'-8" B P x 24'-0" EXT x 13'-3" MLD


SCALE 1/2" INCH

TO CLASS 100 A1 STEAM TRAWLER

ENGINE & BOILER CASING AS PREVIOUSLY APPROVED

DECK PLATED OVER IN WAY OF MACHINERY SPACE

PLAN No. 3436  
FOR ENCLOSURE TO  
Messrs Lloyd's Surveyors  
Hull FROM  
COCHRANE & SONS, LTD.  
SHIPBUILDERS, SELBY.  
DATE 1-10-13.

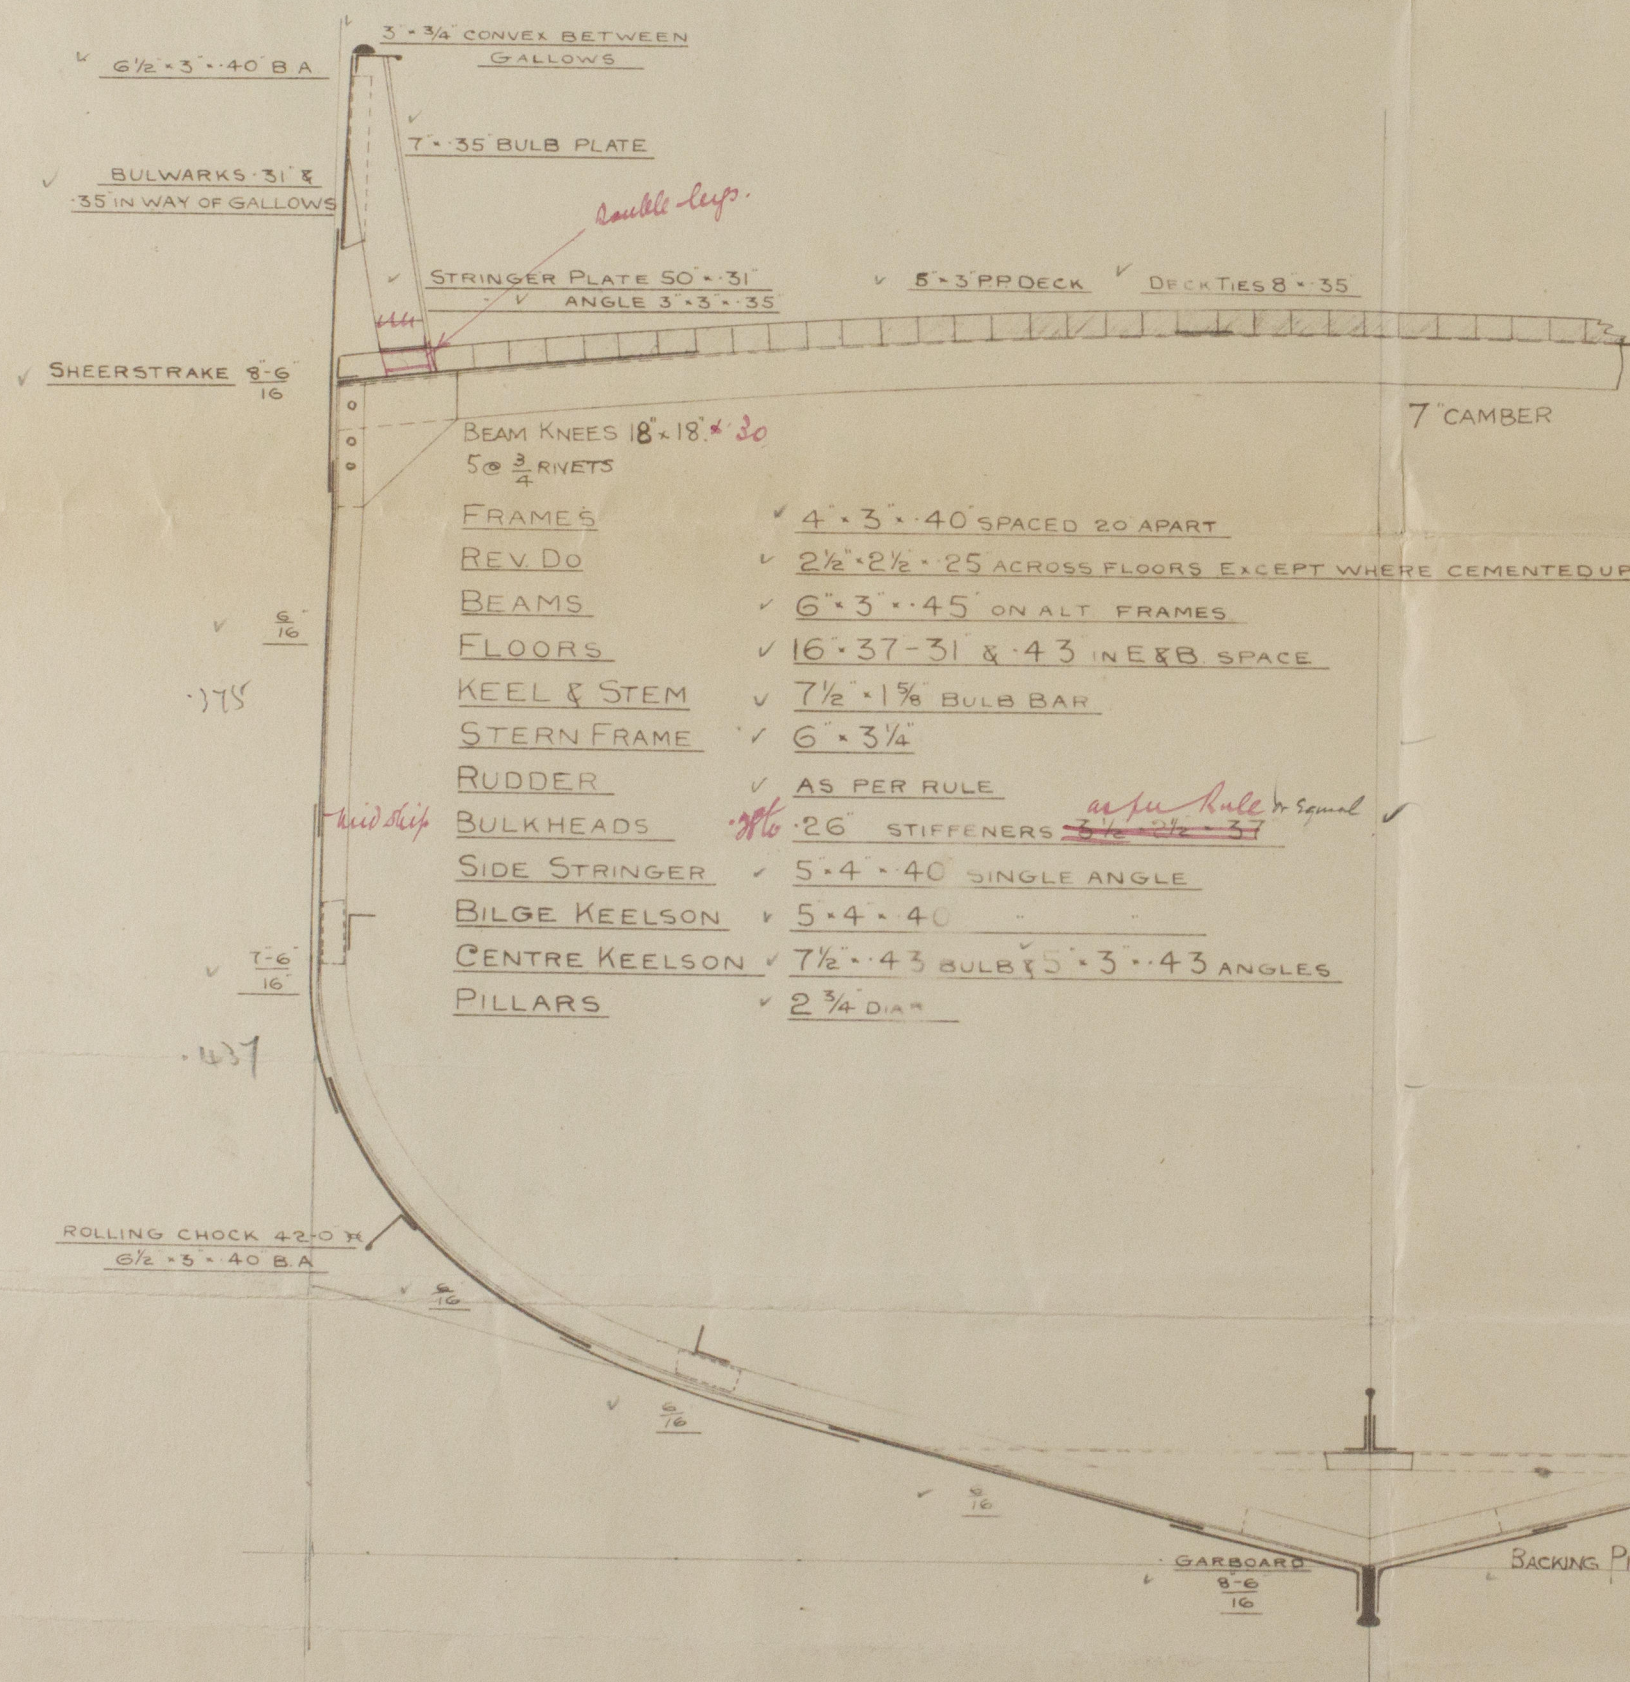

## NUMERALS

B+D 37.12  
L x (B+D) 5072.81

## PROPORTIONS

10.31  
5.73

## EQUIPMENT

1ST BOWER ANCHOR 8 CWTs STOCKLESS  
2ND " 7 1/2 " "  
3RD " 3 1/4 " EX STOCK  
120 FATHOMS 12/16 STUD LINK CABLE  
60 " 6" HAWSER  
60 " 5" WARP

## RIVETING

BUTTS OF SHELL PLATING LAPPED & DOUBLE RIVETED  
EXCEPT GARBORD & SHEER STRAKE WHICH ARE TO BE  
STRAPPED. LANDINGS DOUBLE RIVETED  
BULWARKS SINGLE RIVETED

C.S.  
7.10.13.