

27.3.05




S.S. N<sup>os</sup> 79+80.

ELEVATION.

SCALE 1/4" = 1 FT.

DIMS 125'-0" x 22'-0" x 13'-0" MOULDED.

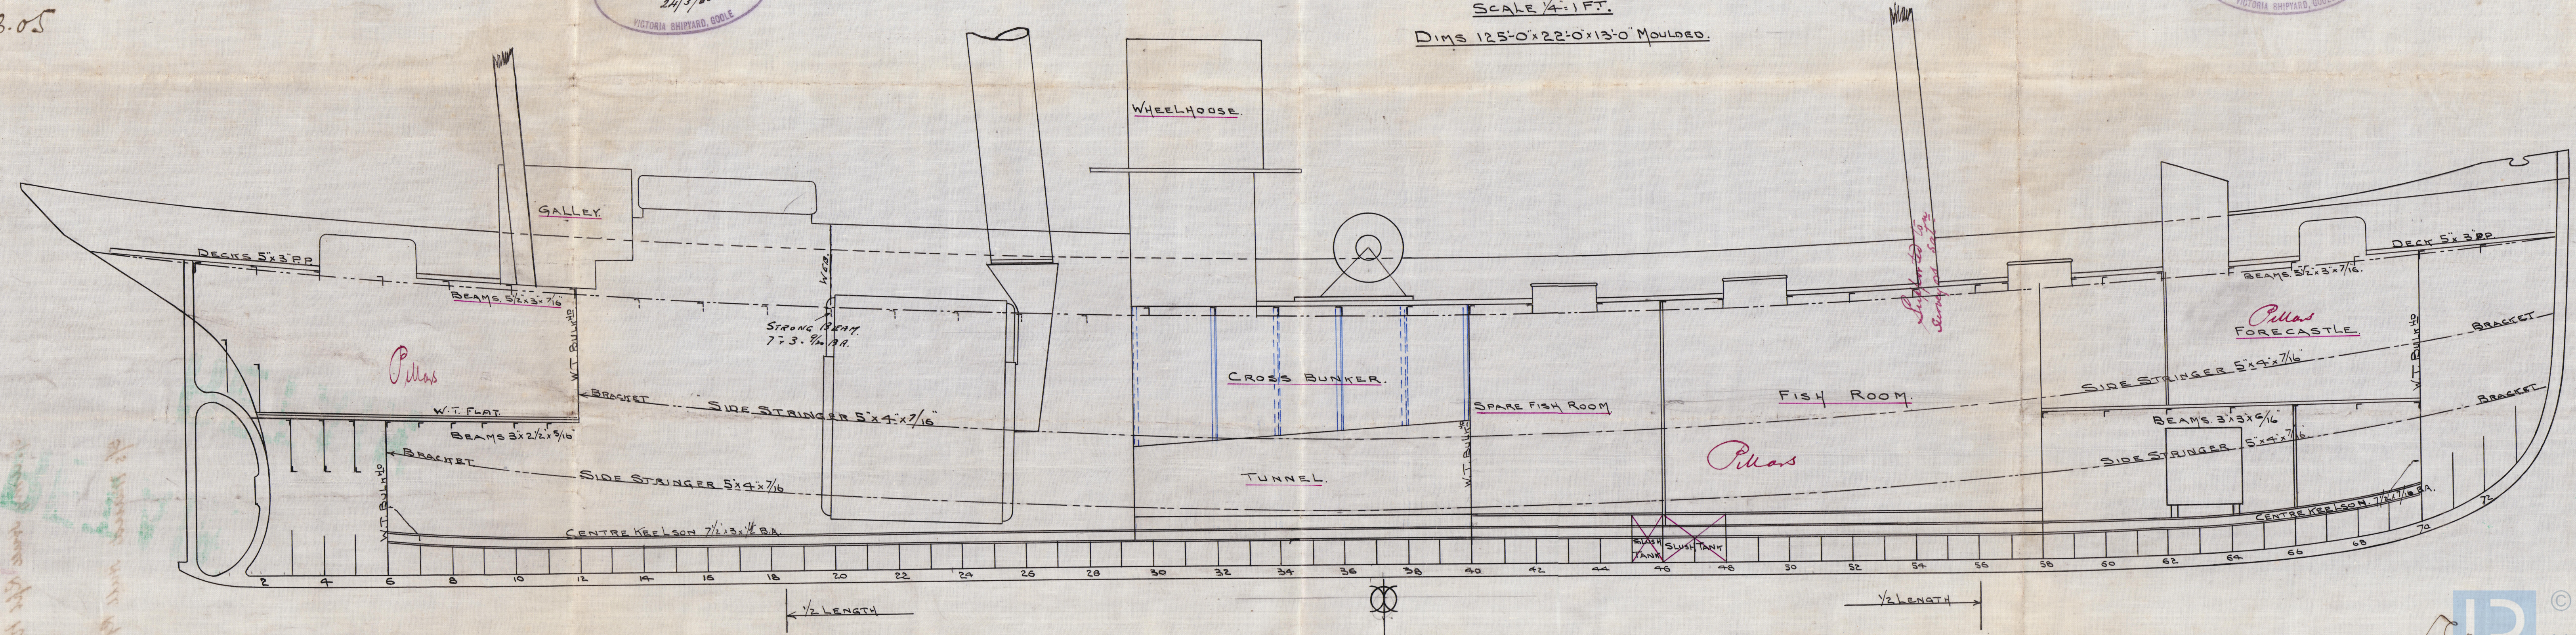



Escoe S. & R. Co.  
No 49. & 80.

W981-0142

Profile.

S/S Army Hull Rpt No. 17201

S/S Maud Hull Rpt No. 17250



© 2020

Lloyd's Register  
Foundation