

OOOLE SHIPBUILDING & REPAIRING CO. LTD.
SHIPBUILDERS & ENGINEERS
24/3/05
VICTORIA SHIPYARD, OOOLE

MIDSHIP SECTION.

OFTWO
STEEL SCREW TRAWLERS.

DIMS:- 125'-0" BP x 22'-0" x 13'-0" MLD.

TO CLASS 100A.I. LLOYDS FOR FISHING PURPOSES

FLUSH DECK NO ERECTIONS.

SCALE $\frac{1}{2}'' = 1 \text{ FT.}$

$$\frac{L}{B} = 5.63$$
$$\frac{L}{D} = 9.17.$$

EQUIPMENT N° 5512.

ANCHOR 5 1/2 CWTs. Ex STOCK.

1 " 5 " " "

1 " 2³/₄ " " "

105 FATHOMS 1 1/2" STUD LINK CHAIN.

GO " 6" HAWSER


60 " 4 1/2" WARP

27.3.05

NUMERALS

1/2 GIRTH	20.00
1/2 BREADTH	11.00
DEPTH	13.50
1ST NO	44.50
LENGTH	123.88
2ND NO	5512.66

OF TWO

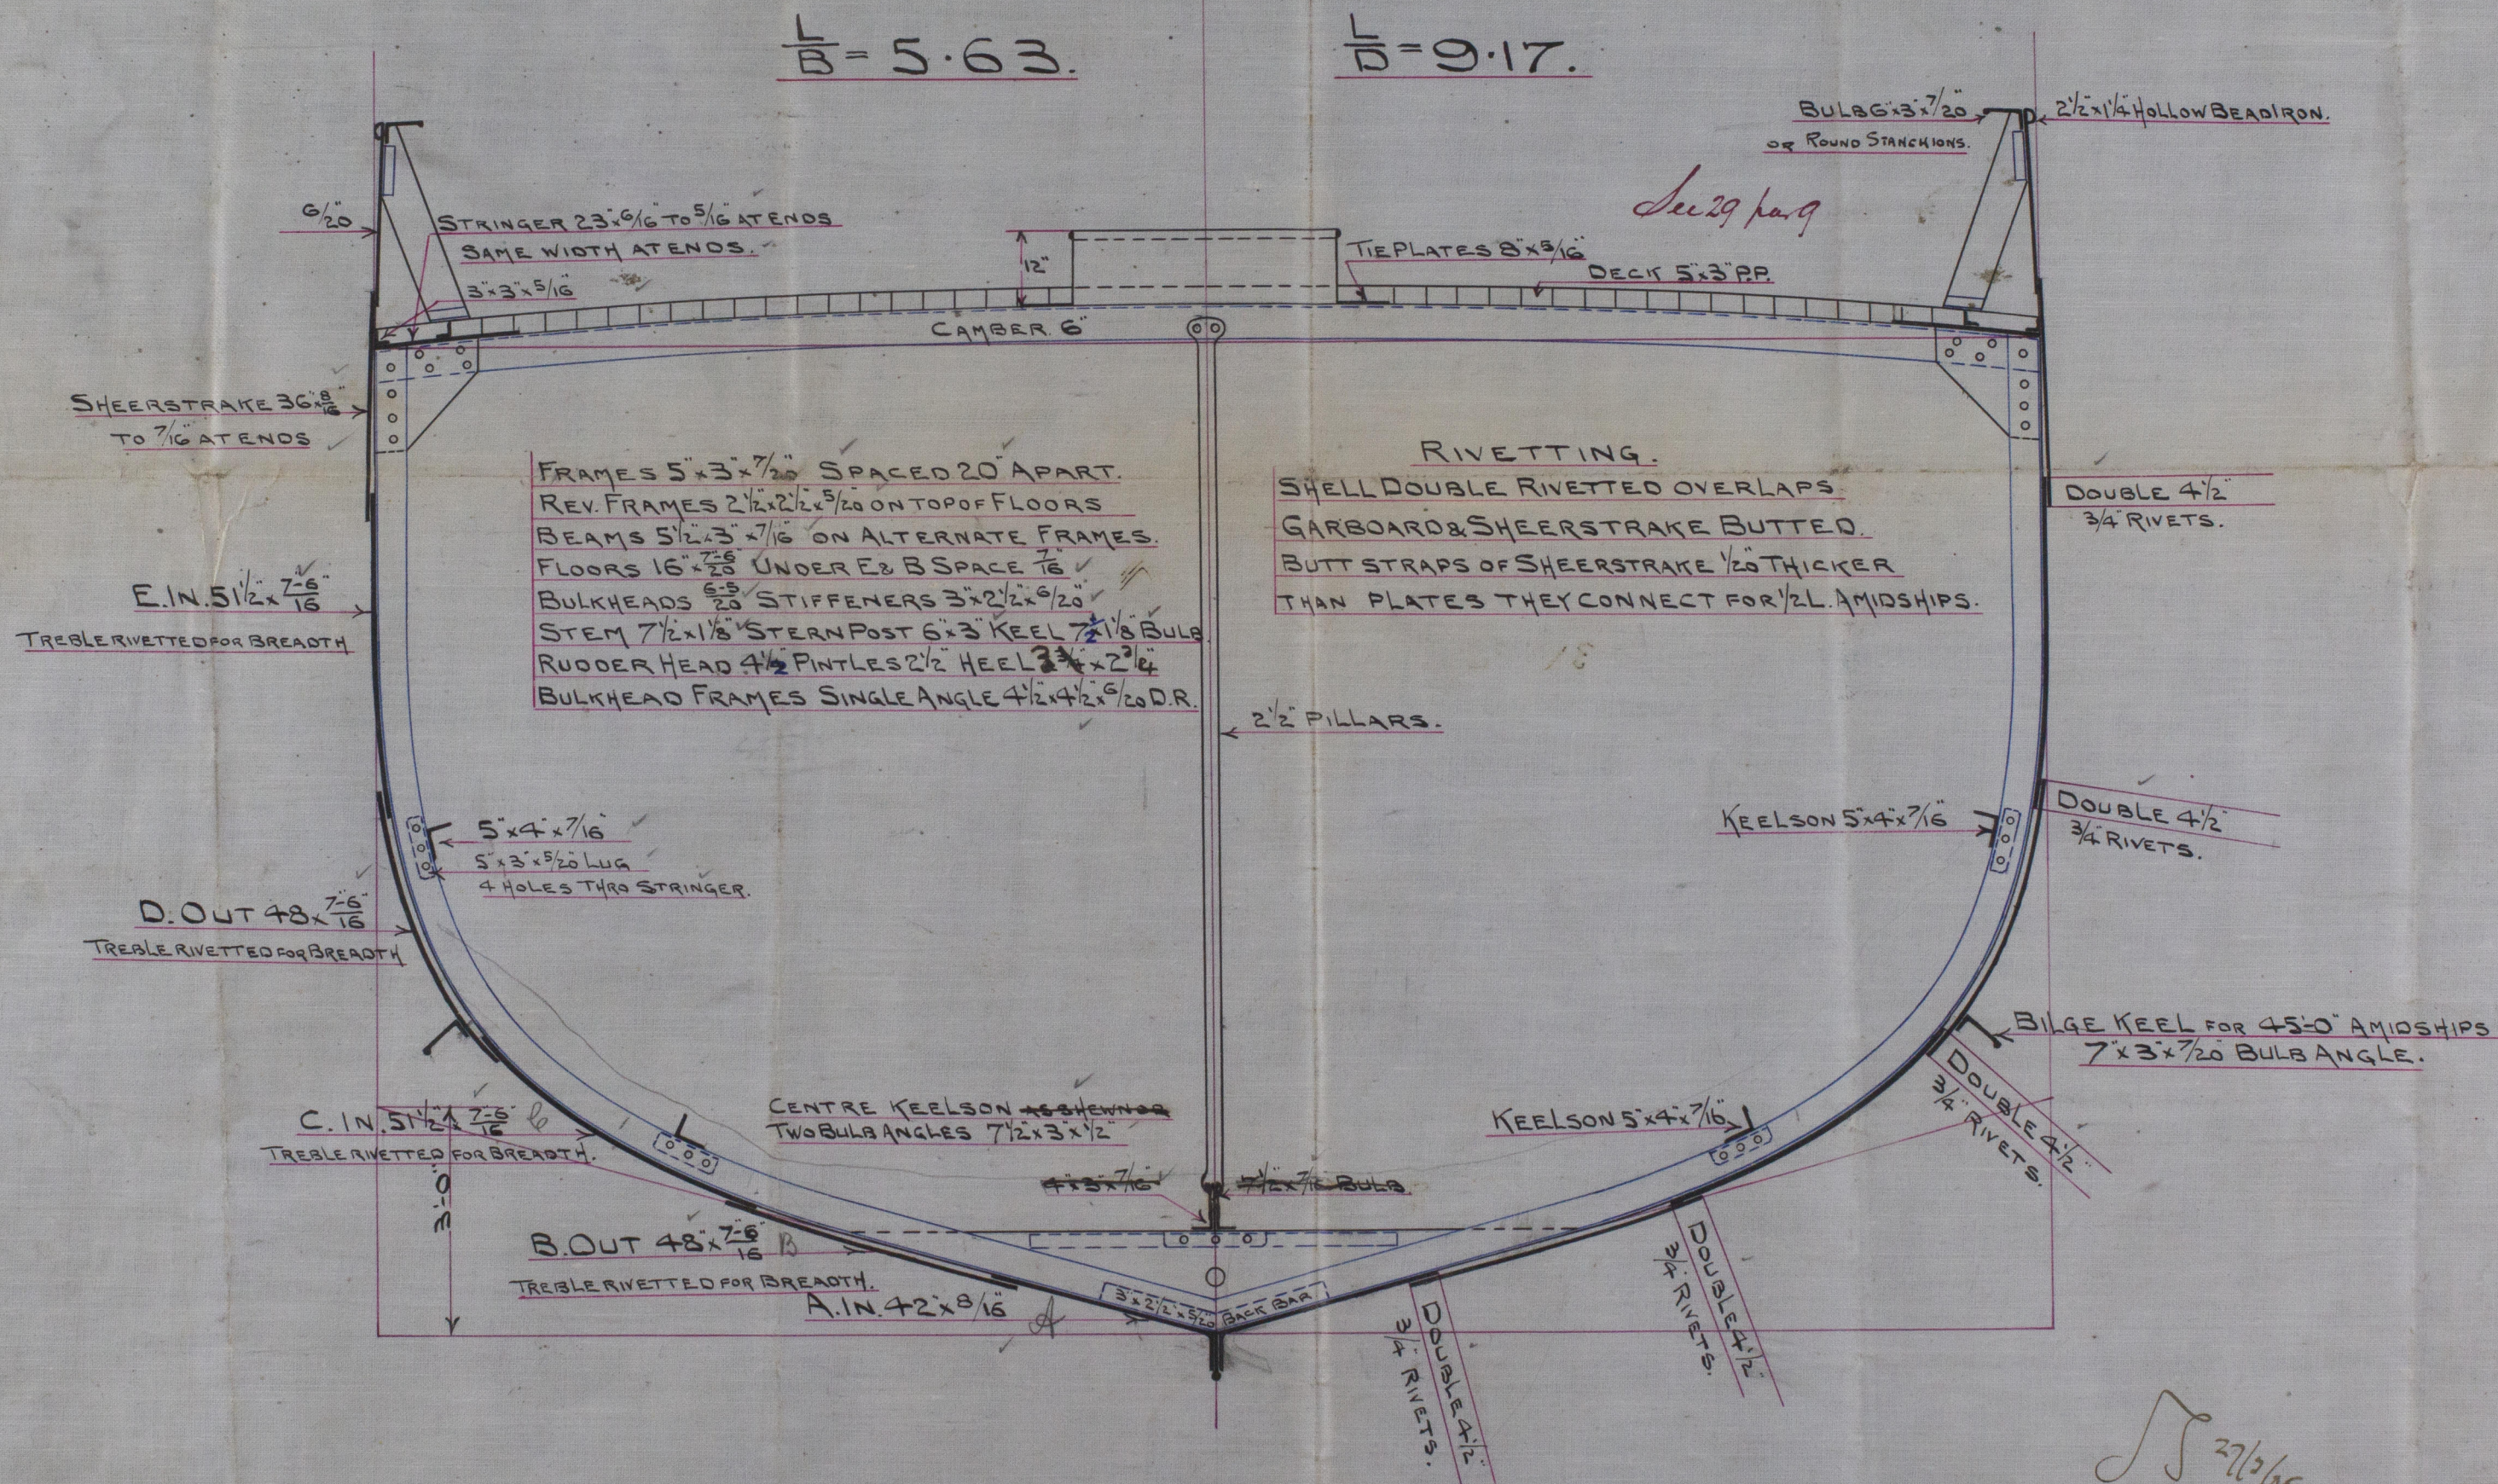

JS 27/2/08

Lloyd's Register
Foundation

W981-0144

Boole S. + R. Co.
Nos 79. + 80.

Amended
Midship Section

St. "Amy" Ital. 17201.

W981-0144

s/s Maud
Hull Report No. 17250



© 2020

Lloyd's Register
Foundation