

# Lloyd's Register of Shipping.

## SURVEYS FOR FREEBOARD.-STEAM SHIPS.

16 MAR 1927

PARTICULARS RELATING TO ALL STEAM SHIPS EITHER FLUSH DECKED, OR WITH TOP GALLANT FORECASTLES, SHORT POOPS AND BRIDGE HOUSES DISCONNECTED, OR WITH TOP GALLANT FORECASTLES HAVING LONG POOPS, OR RAISED QUARTER DECKS CONNECTED WITH BRIDGE HOUSES, OR OTHERWISE.

Port of Survey Newcastle-on-TyneDate of Survey 14<sup>th</sup> March 1927Name of Surveyor G. L. Brown

GLEEGORSE

Palmer's Co. No. 922

Ship's Name.

HEDGEHOPE

Number in Register Book

Port of Registry and Nationality.

Newcastle U.K.

Official Number.

149425

Gross Tonnage.

Date of Build.

1927

Particulars of Classification.

+ 100A1 Contemplated

Registered dimensions from Ship's Register.	LENGTH.	BREADTH.	DEPTH.	UNDER DECK TONNAGE.
	<u>386.3</u>	<u>52.75</u>	<u>26.0</u>	<u>4285</u>
Length on LOADLINE.	<u>385.8</u>	Frame Depth $\frac{1}{2}$ Rule " $\frac{6}{2}$ = <u>1.0</u>	Ceiling <u>none</u> Sheer <u>+ .60</u> $\frac{3}{16}$ " Drop in Tank Top <u>4.15</u>	Peak Tanks <u>incl</u> Tank top <u>same</u> depth as margin <u>graduated</u> from <u>midships</u> to <u>ends</u>
CORRECTED DIMENSIONS.	<u>385.8</u>	<u>51.75</u>	<u>26.95</u>	<u>4285</u>

Moulded Depth as measured..... 28' 6"

Addition for Keel below base line for draught record..... inches.

NOTE. - If the depth is measured when vessel is afloat, the details of measurement should be reported.

## CORRECTION FOR LENGTH

Length of Ship on Loadline.....	<u>385.8</u>
Length in Table .....	<u>342.0</u>
Difference .....	<u>43.8</u>
Correction for 10ft., Table A. ....	<u>1.5</u> Table C.
× Difference divided by 10 .....	<u>6.57</u> (if required.)
If $\frac{1}{10}$ ths length covered divide by 2	<u>3.28</u>
	<u>+ 3 1/4</u>

## CORRECTION FOR IRON DECK.

Proportion covered, if less than $\frac{1}{10}$ ths length covered .....	<u>3 1/2</u>
Thickness of usual wood deck, less stringer .....	<u>3 1/2</u> - <u>3 1/2</u>

## CORRECTION FOR ROUND OF BEAM.

Breadth at Gunwale amidships.....	<u>51.5</u>
Round of Beam.....	<u>13"</u> on full breadth = <u>52.5</u>
Normal round.....	<u>13</u>
Difference .....	<u>-</u> ÷ 2 = .....
Proportion of Deck uncovered (Para. 19) .....	<u>-</u>

NOTE. - The round of beam should be reported on the full breadth of vessel at the gunwale.

Co-efficient of fineness..... .496Any modification necessary [Para. 4 (a) to (e)]\* C.D.B.Co-efficient as corrected ..... .78Sheer { Stem..... 102 } 141 ÷ 2 = 70 1/2 ... Mean 36 1/2 21.87  
at { Sternpost ... 39 } 60Sheer at  $\frac{1}{2}$  of the length from { Stem 56 } 77 1/2 ÷ 2 = 38 3/4 ... Mean  
Sternpost 21 1/2Gradual mean Sheer ..... 70.45 ÷ .65 = 40.45Standard mean Sheer [Table, Para. 18] ..... 48.58 CorrectionDifference..... 21.84 ÷ 4 = 5.47

§ If limited as Para. 18 (f) .....

- 5 1/2Rise in Sheer { At front of bridge house.....  
from amidships { Para. 18 (e) } At after end of forecastle .....Fall in Sheer { Para. 18 (d) } ÷ 2 = ✓

Length uncovered ..... Correction

## ALLOWANCE FOR DECK ERECTIONS:—

Freeboard, Table C..... 3' 10"

Correction for Length, if required (Para. 12, 13, and 14) .....

Freeboard by Table A, corrected for sheer, and for length, if required (Para. 12, 13, and 14) } 6 - 6 1/2Difference ..... 4 - 1 2 - 8 1/2Percentage as below ..... 3 - 3 1/2 60.2%

Correction for R. Q. Dk. if engine and boiler openings not covered by bridge house (Para. 11)

Allowance for Deck Erections ..... - 1 - 7 1/2

	Length.	Length allowed.	Height.
Forecastle.....	<u>37.75</u>	<u>37.75</u> ✓	<u>7' 6"</u>
Bridge House .....	<u>231.6</u>	<u>231.6</u> ✓	<u>7' 6"</u>
† Raised Q. Dk. ....	<u>-</u>	<u>-</u>	<u>-</u>
Poop.....	<u>40.1</u>	<u>40.1</u> ✓	<u>7' 6"</u>

Total ..... 309.45Length of Ship ..... 385.8 = .802 ✓Corresponding percentage { Para. 11, 12, 13, and 14 } 60.2% ✓

FREEBOARD recommended amidships from centre of Disc to top of Statutory Deck Line, Wood (Steel) Deck:—

Fresh Water Line

above centre of Disc

Indian Summer Line

"

Winter Line

below

Winter North Atlantic Line

"

17 MAR 1927

† If the frames, skin planking, or ceiling are of unusual thickness the breadth of vessel to inside of ceiling should be reported if possible.  
‡ In vessels obtaining an allowance for deck erections under Para. 11 where the sheer drops abaft amidships the height of the R.Q.D. is to be taken from the level of the top of the amidship beam.  
§ In flush-decked vessels the total standard mean sheer means the sheer measured at the stem and stern-post. In vessels having poops and forecastles, it means the sheer measured at points distant one-eighth of the vessel's length from stem and stern-post.

† State dimensions of freeing port area on back of this form.

‡ The Surveyor should state whether the fall in sheer as reported is measured relatively to the straight line of keel or to the water line. If measured relatively to water line the vessel's draft at time of survey, and also the usual load draft forward and aft, should be reported.

RECEIVED 24 MAR 1927

RECEIVED 3 JUL 1927

W982.0149



Do all the Frames extend to the top height in the Poop? *yes* Raised Quarter Deck? *yes* Bridge House? *yes* Forecastle? *yes*  
 To what height do the Reverse Frames extend? *deep frames*  
 Has the Poop or Raised Quarter Deck an efficient Iron Bulkhead at the fore end? *yes*  
 Give particulars of the means for closing the openings in Bulkhead *two openings closed with storm boards in swelled channels*  
 Is the Poop or Raised Quarter Deck connected with the Bridge House? *No* Has the Bridge House an efficient Bulkhead at the fore end? *yes*  
 Give particulars of the means for closing the openings in Bulkhead *no openings*  
 What is the thickness of the Bridge Front plating? *40* and Coaming plate? *44*  
 Give scantlings and spacing of the Stiffeners *9 x 3 1/2 x .62 BA 30" spacing*  
 Are bracket plates fitted at each end of the Stiffeners? *yes* Are hor'l. brackets fitted connecting Bridge Bulk'd. with Bulwarks? *yes*  
 Has the Bridge House an efficient Iron Bulkhead at the after end? *yes*  
 How are the openings closed? *two openings closed with storm boards in swelled channels (full height)*  
 Is the Forecastle at least as high as the main or top-gallant rail? Has the Forecastle an efficient Iron or Wood Bulk'd. at after end?  
 Are the Engine and Boiler openings covered by a Bridge, Poop, Raised Quarter Deck, or enclosed by a Strong Iron or Steel Deckhouse? *Covered by poop Bridge*  
 If the openings are not so protected are the exposed parts of the Casings efficiently constructed?  
 Give thickness of plating; scantlings and spacing of Stiffeners.  
 What is the height of the exposed Casings? Are suitable means provided for closing all openings in them in bad weather?  
 Are the Weather Deck Hatchways efficiently constructed and at least equal to the requirements of Section 28 of the Rules for 1904-5? Give particulars below:— *yes - as approved.*

Position and Size.		N <sup>o</sup> 1 upper deck 29' 9" x 17' 0"		N <sup>o</sup> 2 Bridge deck 31' 10 1/2" x 17' 0"		N <sup>o</sup> 3 Bridge deck 10' 7 1/2" x 17' 0"		N <sup>o</sup> 4 Bridge deck 31' 10 1/2" x 17' 0"		N <sup>o</sup> 5 upper deck 29' 9" x 17' 0"	
Item.		Ship.	Rule.	Ship.	Rule.	Ship.	Rule.	Ship.	Rule.	Ship.	Rule.
COAMING.	Height above top of DECK	3' 3"		2' 6"		2' 6"		2' 6"		2' 6"	
	Sides	44		44		44		44		44	
	Ends	44		44		44		44		44	
SHIFTING BEAMS OR WEB PLATES.	Number	7		7		1		7		7	
	Section and Scantlings	7" 14" x 32		same as N <sup>o</sup> 1		same as N <sup>o</sup> 1		same as N <sup>o</sup> 1		same as N <sup>o</sup> 1	
	Material	JK 3 1/2 x 3 x 44									
* FORE AND AFTERS.	Number										
	Section and Scantlings			none							
	Material										
HATCHES Thickness		2 1/2		2 1/2		2 1/2		2 1/2		2 1/2	
Remarks											

\* The depth of Fore and Afters should be stated from the underside of the hatches in all cases.

(If the sill of the lowest side scuttle will be less than 6 inches above the Indian Summer Load Line if assigned under the tables, state vertical distance from top of deck at side amidships to lower edge of lowest side scuttle.)

The following information is to be given in all Cases of vessels dealt with under Paras. 11, 12 (under 15 feet Moulded depth) and under Shelter Deck Rules.

What is the thickness of the Bridge Sheerstrake?

Strake between Main and Bridge Sheerstrakes?

Delete the words { The Crew are, are not, berthed in the bridge house.

that do not apply { The arrangements to enable them to get backwards and forwards from their quarters are, are not satisfactory.

Length of Bulwarks in well *For 38' aft 38'*

Area of Freeing Ports required by Para. 11 (e) each side of vessel

Ft. Tenths. Ft. Tenths. No.

*For 19.0 x 0.75 x 1*

*aft 20.0 x 0.75 x 1*


Freeing Ports (each side of vessel)

Total deficiency or excess

*10.3 found*  
*20.6 Total* Sq. ft.

*14.25 found*  
*15 aft* Sq. ft.

*3.95 found*  
*4.7 aft* Sq. ft.

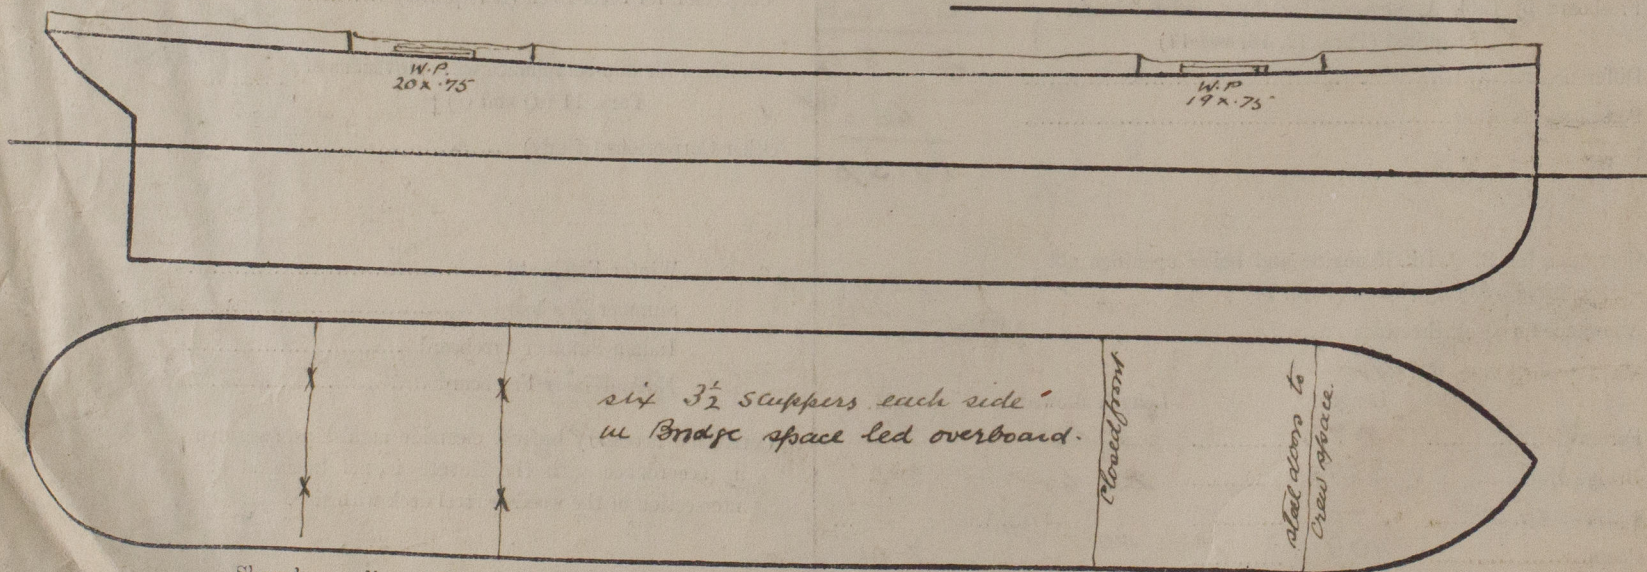

Show hereon line of Floors or Tank Top with position of any Breaks in same; also height of Peak Tank tops, &c., &c.

State any special features in the construction of the Vessel *Copies of app'd plans in London*

Builder's name and yard number *Palmer's S.B. & Co. Ltd N<sup>o</sup> 922*

Names of sister vessels

Owners *Medomley S.S. Co. Ltd*

Address *Newcastle*

Approx Fee £ 10

Received by me *See L.C. Rpt.*



© 2020

Lloyd's Register Foundation