
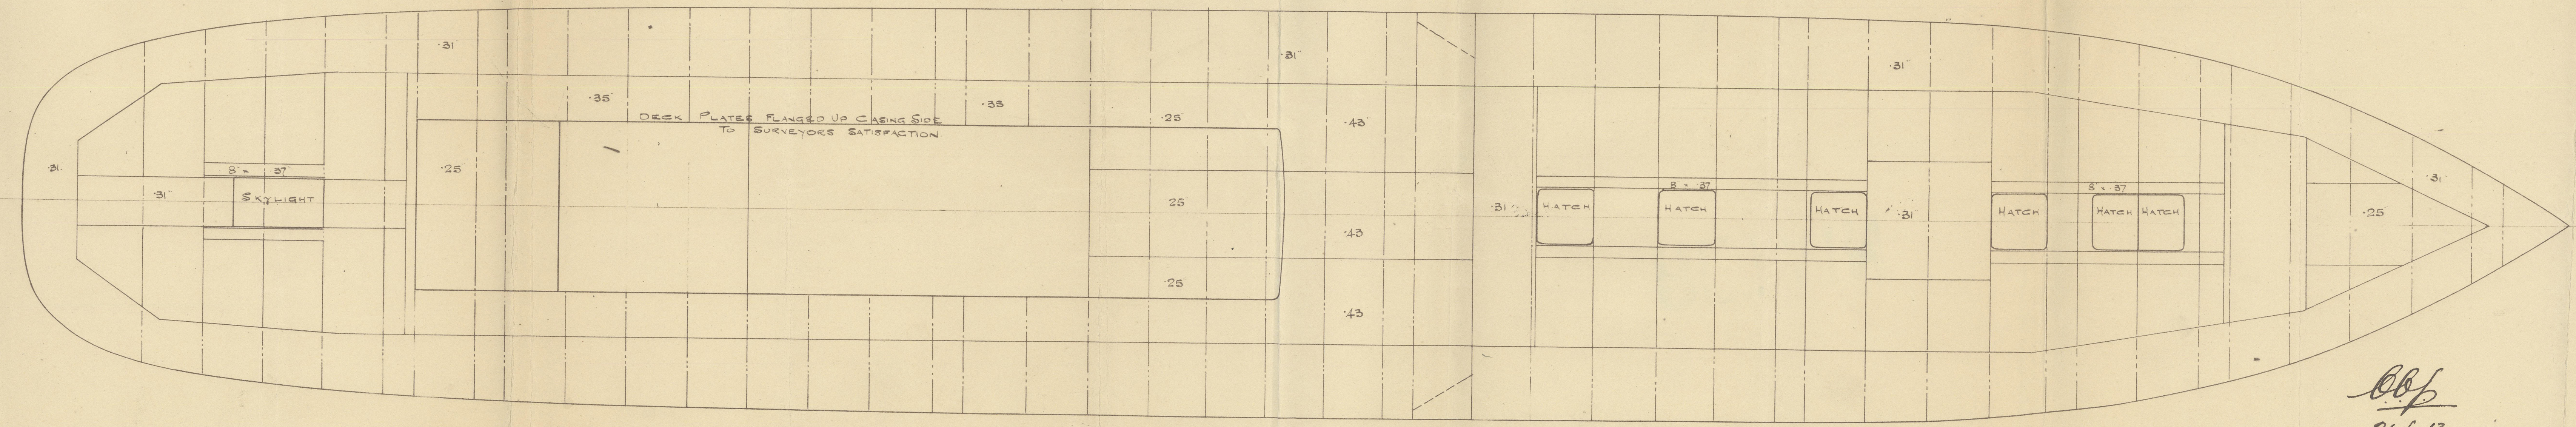


Nº 592
DIMS. 135'-0" B.P. x 23'-3" EXT. x 13'-4" MLO
SCALE 1/4" INCH

PLAN No. 3254
FOR ENCLOSURE TO
Messrs Lloyd's Surveyors
Hall
FROM
COCHRANE & SONS, LTD.
SHIPBUILDERS, SELBY.
DATE 19/8/13. JSD

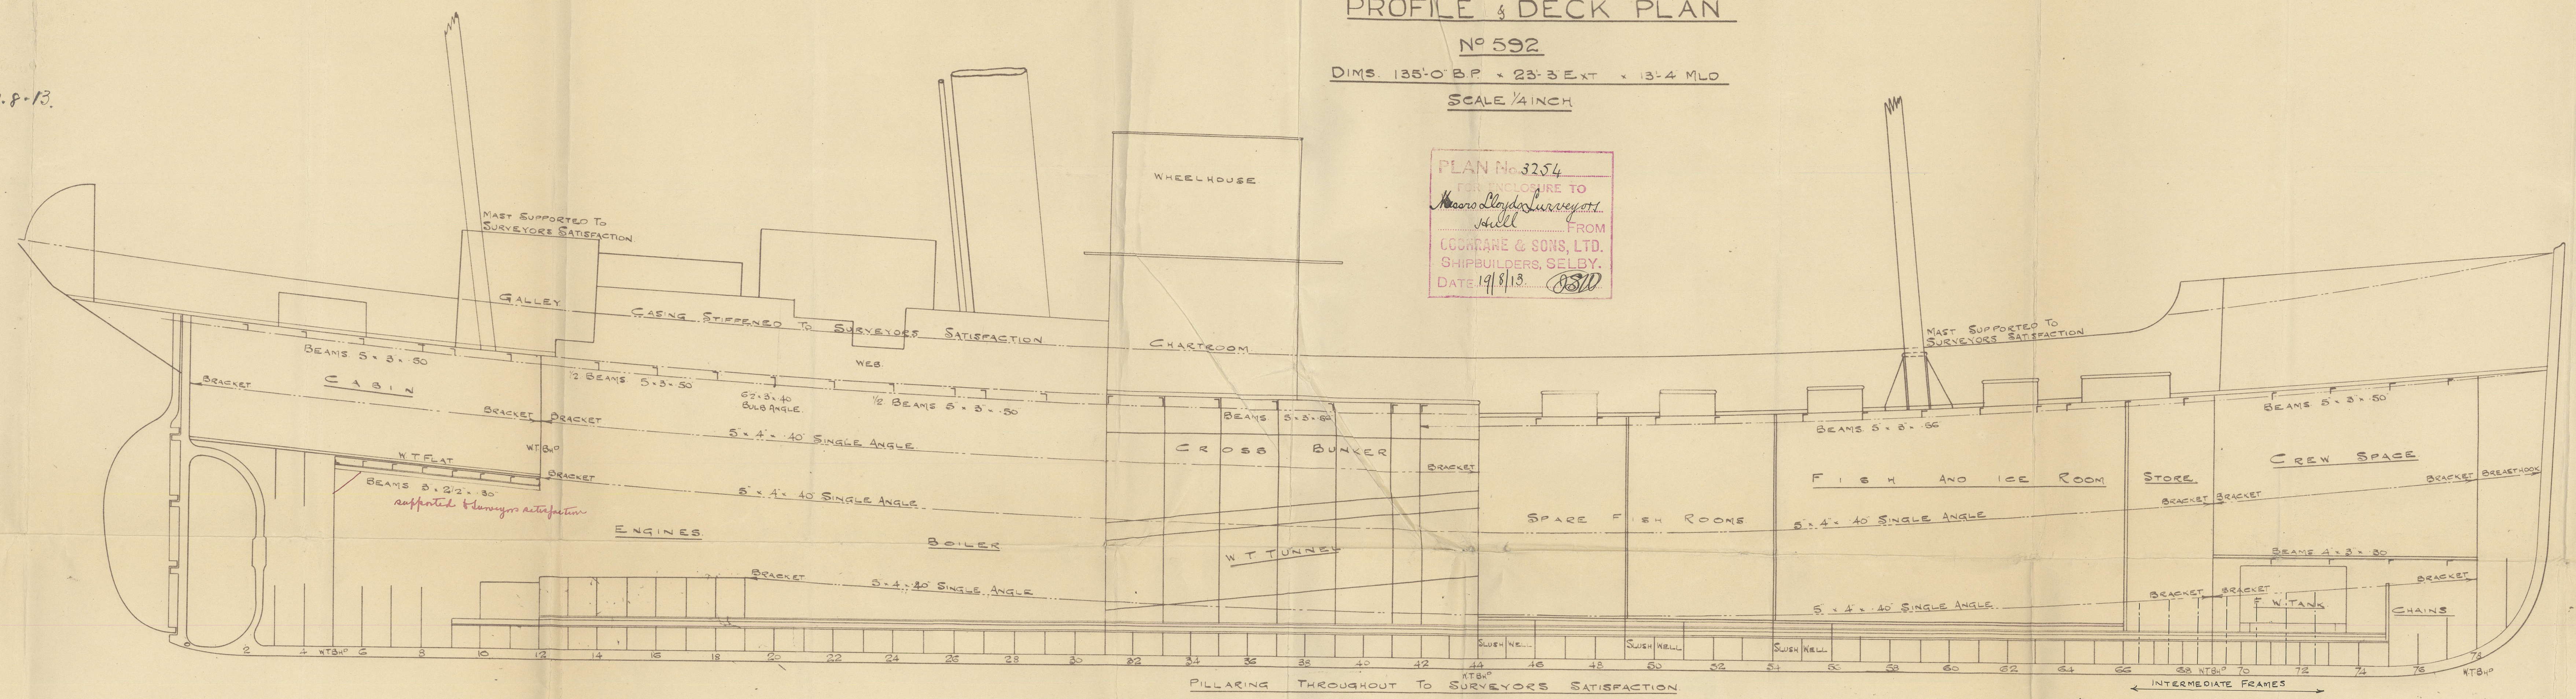

CCF
21-f. 13.

LLOYD'S REGISTER
OF SHIPPING.
20 AUG 1913
HULL.



© 2020

Lloyd's Register
Foundation

Cochrane & Sons. Ltd.

N^o 592.


Profile & Deck
Dimensions

135-0' x 23-128' x 13-33'

s/s *Angelus*
Hull Rpt in 27315-



RETAIN

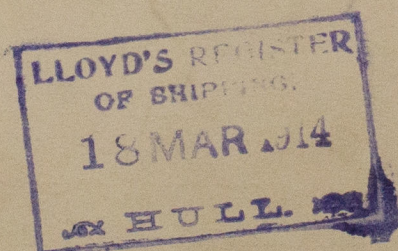

© 2020

Lloyd's Register
Foundation

W982-0207