

N^o 286

PROFILE & DECK PLAN.

SCALE 1" = ONE FOOT

LENGTH B.P. 215'-0"

BREADTH M^d 34'-0"

DEPTH M^d 15'-9" TO MAIN DECK.


CLASS 100 A.I. + LLOYDS.

R.Q. DEK 4'-3"

FREEBOARD PARTICULARS





SHEER AT STEM 6'-9"
 1/2" AT 10' OF STEM 4'-55"
 AT STERN 3'-6"
 1/2" FROM STERN 22'-10"
 BLOCK COEFF. .76

BRIDGE JACK.

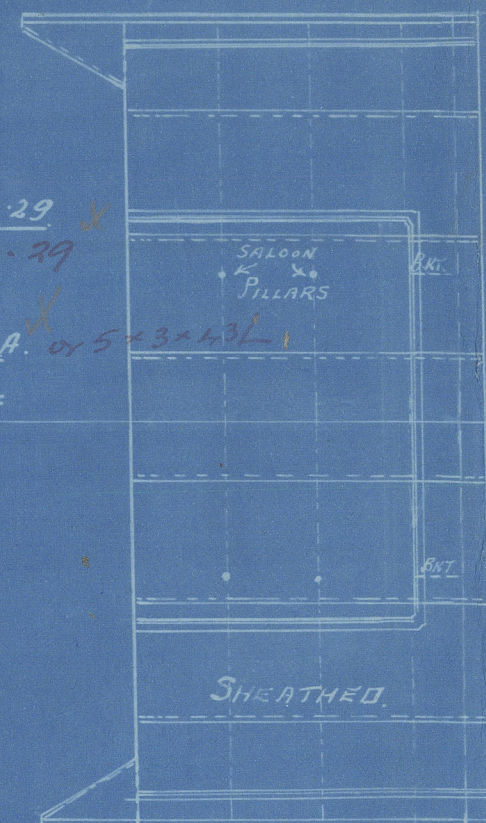



STRONGER ANGLE 3x3x29
 PLATING 26x29
 DECK PLATING 22x10
 BEAMS 5x3x30 B.H. or 5x3x30
 BEAM KNEES 15x30

PANTING STRINGER.

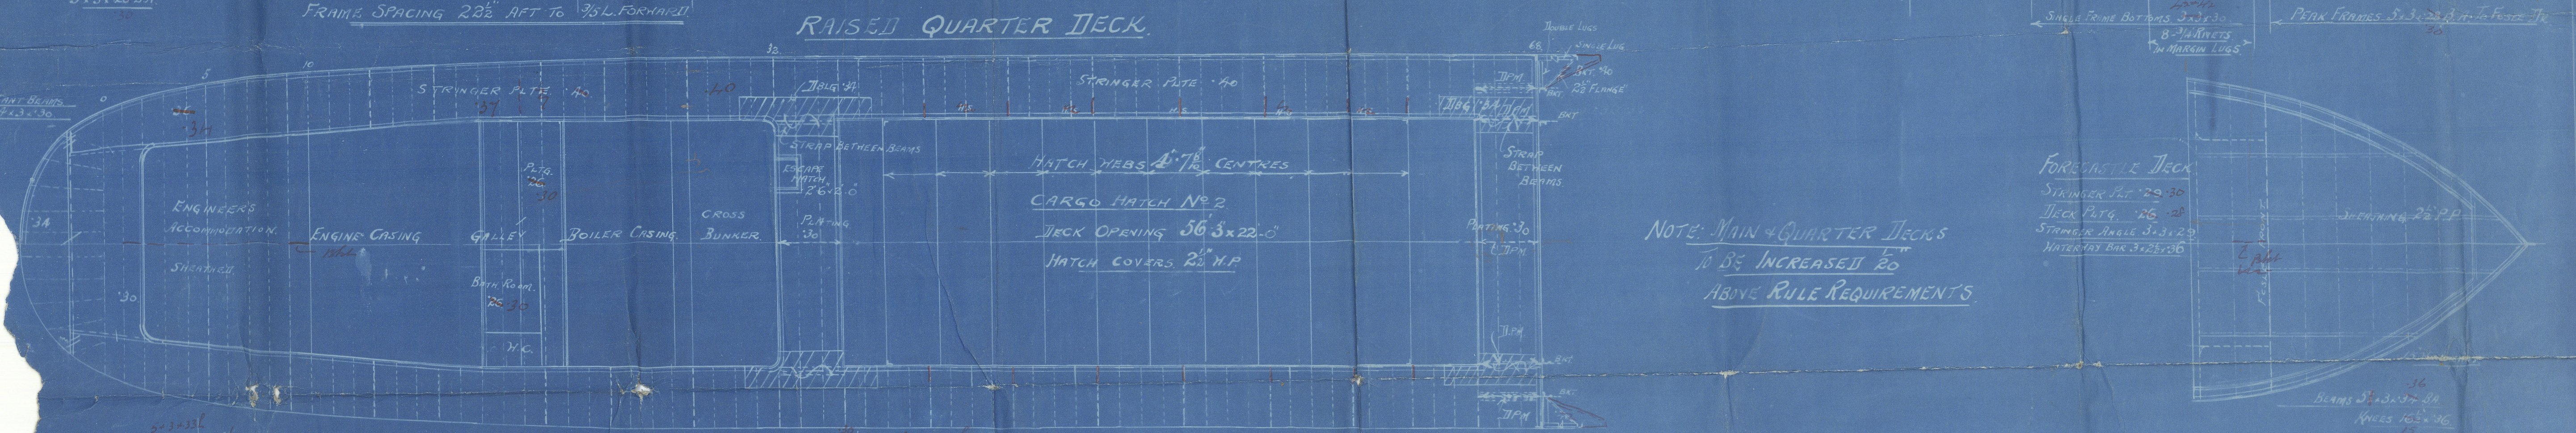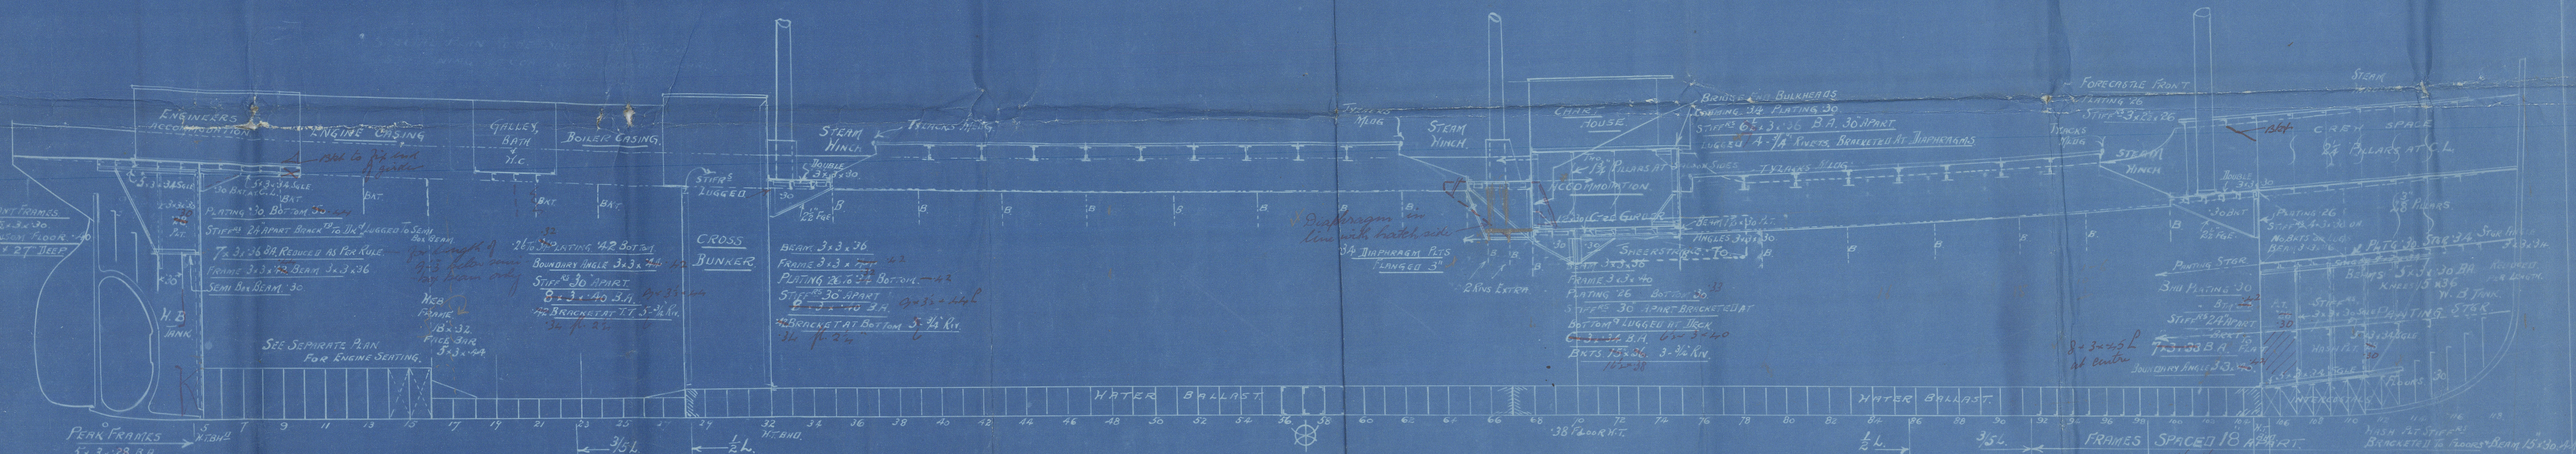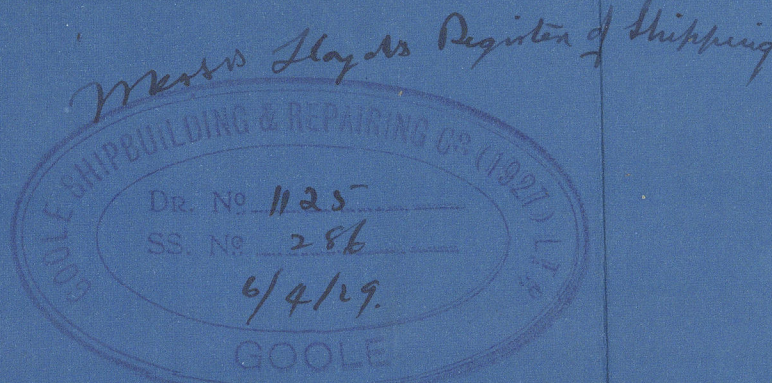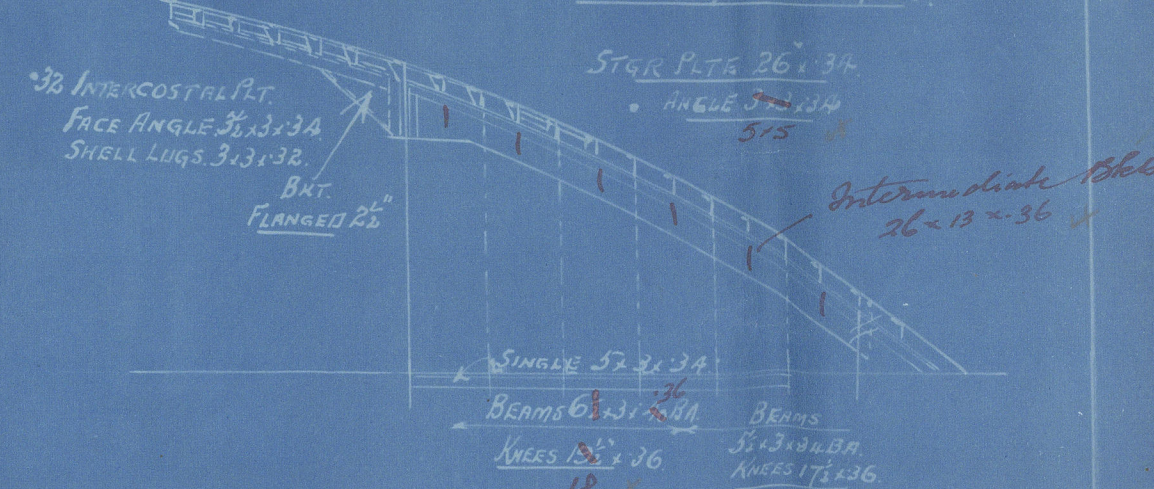

NOTE: MAIN & QUARTER DECKS
 TO BE INCREASED 20"
 ABOVE RULE REQUIREMENTS.

UPPER DECK.

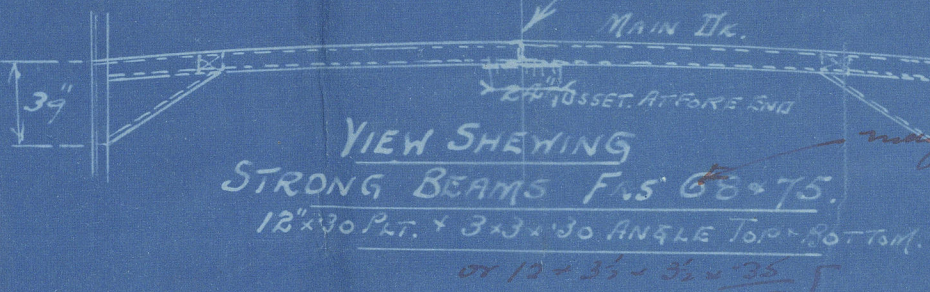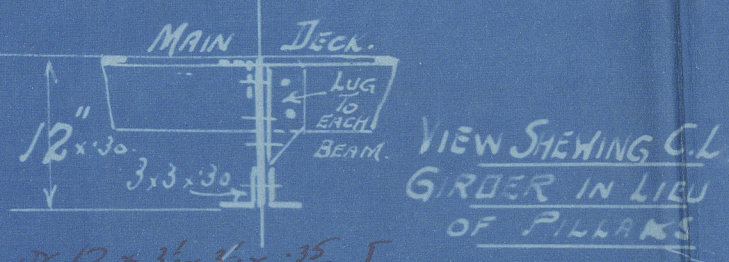

GOOLE.

GOOLE.

10.4090
 Lloyd's Register
 Foundation

No. 286.

Profile & Deck.

Goole S.B. & R. Co. Ltd.

S.S. "Holme Force"

HULL REPORT NO. H0622



© 2020

Lloyd's Register
Foundation

W984-0349