

For the information of Surveyors and the Committee only.

Received at Hull Office, 5-9-17 19

Lloyd's Register of Shipping.

(Report on Vessel No. 30492. Part Hull
S.T. "Joseph Button",)

SHIP FORGINGS OR CASTINGS.

I have to report that the undermentioned Iron or ~~Steel~~ Forgings or castings, manufactured by M^{essrs} L. S. Forster & Son L^{td} Sunderland for the Vessel No. 379, being built by Book, Helton & Gemmill L^{td} of Beverley, have been inspected by me as set forth below and found to be, so far as can be seen, Sound

Forgings or Castings.


Lloyd's
No. 686

D. D. Williamson

Sunderland . 3-9-17


	STERN FRAME.	RUDDER FRAME.	STEM.
...	<u>Scrap Iron</u>	<u>Scrap Iron</u>	/
...	<u>Forged</u>	<u>Forged</u>	
...	<u>6" x 3"</u>	<u>4 1/2" dia 4 1/2" x 4 & 3 1/2" x 3</u>	
Inspection ...	<u>Forged & Finished</u>	<u>Forged & Finished</u>	
Inspected	<u>18-4-17 to 17-5-17</u>	<u>17-5-17 to 28-8-17</u>	
STANDARDS.			
Standard Test pieces.			
t =			
square inch			
per cent. ...			
ing Test—			
re fracture			
ground ...			
Test—			
ording to Rules			
and satisfactory ...			

SKETCHES OF FRAMES SHOWING POSITION AND DESCRIPTION OF WELDS OF FORGINGS.

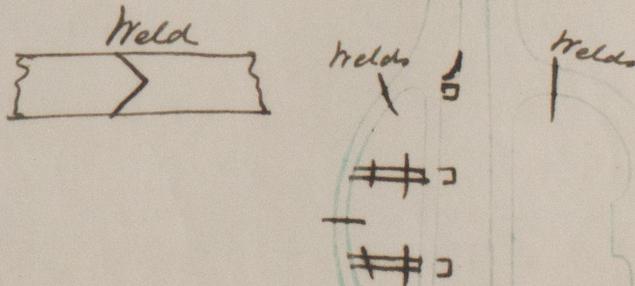

(if any chargeable) £ : :
to be paid at

on, state whether scrap or puddled Iron. If of steel, state whether made on the Open Hearth process.

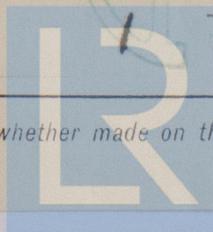

© 2020

Lloyd's Register
Foundation
W985-0080.

