


M/S JANUS"

CROPPING MY FRAMES
IN WINGTANKS

BUTTS OF FRAMES TO BE
CAREFULLY VEEED OUT AND
EFFICIENTLY WELDED TO
SURVEYORS SATISFACTION.

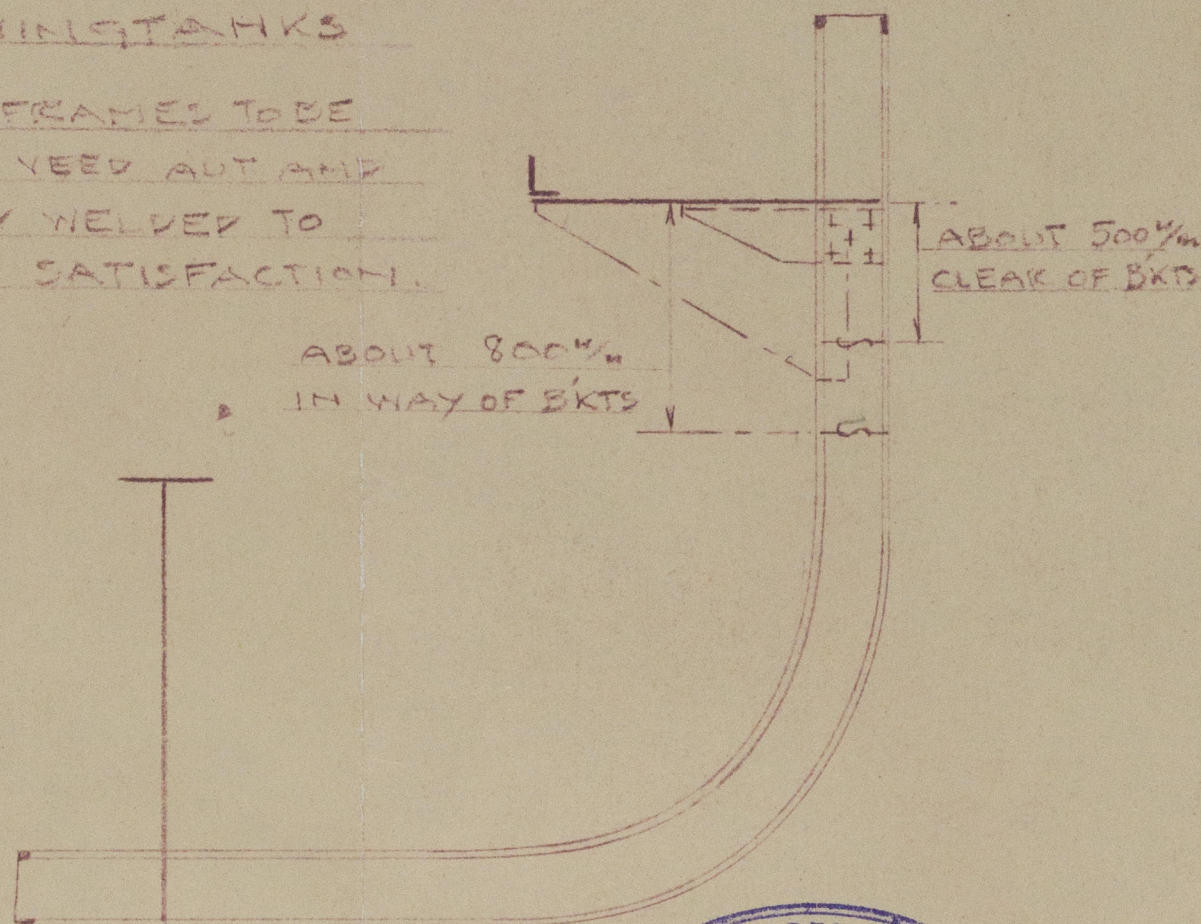

oversight from Lloyd's Register
Signature J.H.
5/3.40

Lloyd's Register
Foundation

W986-0134

m.s. JANUS

Gal. Rpt. No. 12893

Cropping frames in Wing tanks.



© 2020

Lloyd's Register
Foundation

W 986-0134