Rpt. 6.

For the information of Surveyors and the Committee only.

Received at ..... Office .....

Lloyd's Register of Shipping.

Report on Vessel No. 69670 *Port* GLASGOW.

No. .....

SHIP FORGINGS ~~OR CASTINGS~~.

The words FORGINGS or CASTINGS, IRON or STEEL, should be struck out as may be required.

I have to report that the undermentioned Iron ~~or Steel~~ Forgings ~~or Castings~~, manufactured by Messrs.T.S. Forster & Sons, Limited, *of* Sunderland, *for the Vessel No.* 1299, *being built by* Messrs.A. & J. Inglis Ltd. *of* Glasgow, *have been inspected by me as set forth below and found to be, so far as can be seen,* satisfactory.

Mark on Forgings ~~or Castings~~

Lloyd's
No. 3165
CP. 2.10.44.

Chas. S. Porter

Sunderland. 3-10-44

	STERN FRAME.	~~RUDDER FRAME~~.	~~STEM~~.
Material*	Scrap Steel.		
How made	Forged.		
If annealed	----		
Dimensions	As per Plan.		
Progress on Inspection ...	Forging & Machining.		
Date when Inspected ...	2.10.44.		
CASTINGS. Tests on Standard Test Pieces.			
Tensile Test—			
Ultimate Tensile. Tons per sq. in. ...			
Yield Point Tons per sq. in. ...			
Extension per cent. on.....inches ...			
Red. of Area %			
Cold Bending Test— Angle before fracture ...			
Drop Test Height from ground ...			
Hammering Test— If made according to Rules and found satisfactory ...			

SKETCHES OF FRAMES SHOWING POSITION AND DESCRIPTION OF WELDS OF FORGINGS.

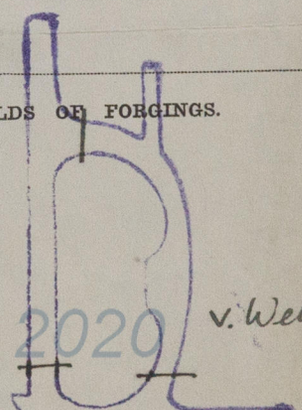

Checked 6/11/44
E.W. Bolwell

Fee (if any chargeable) £ MONTHLY A/C.

To be paid at .....

If of Iron, state whether scrap or puddled Iron. If of Steel, state whether made on the Open Hearth process.

5m,2,42. T. (MADE AND PRINTED IN ENGLAND.)

© 2020 Lloyd's Register Foundation

W 986-0210 MB