



DIMENSIONS.

TOTAL HEATING SURFACE 1698 #
 SURFACE OF TUBES 1335 #
 AREA OF FIRE GRATE 49.2 #
 LENGTH OF FIRE BARS 5'-0"
 NO OF TUBES 216
 DIAM. OF TUBES OUTSIDE 3 1/2"
 LENGTH OF TUBES OVER PLATES 6'-10"
 WORKING PRESSURE 200 LBS.
 DIAM. OF SAFETY VALVE 2 1/2"

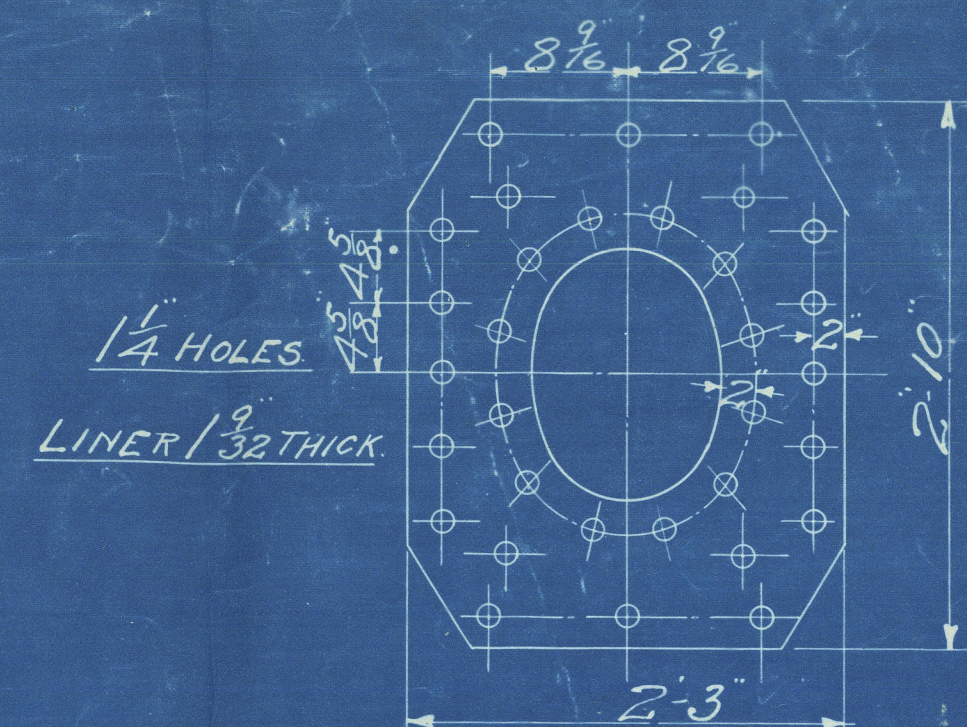


MANHOLE IN SHELL 16" x 12"



DOUBLE PLATE GIRDER STAYS
 PLATE 3/8" THICK
 FITTED WITH 3 SUPPORTING BOLTS
 BOLTS 1 1/8" DIA 2-4 EFF. AREA
 BOLTS 1 1/8" DIA 2-07 EFF. AREA
 IN CENTRE CHAMBER
 IN SIDE CHAMBERS

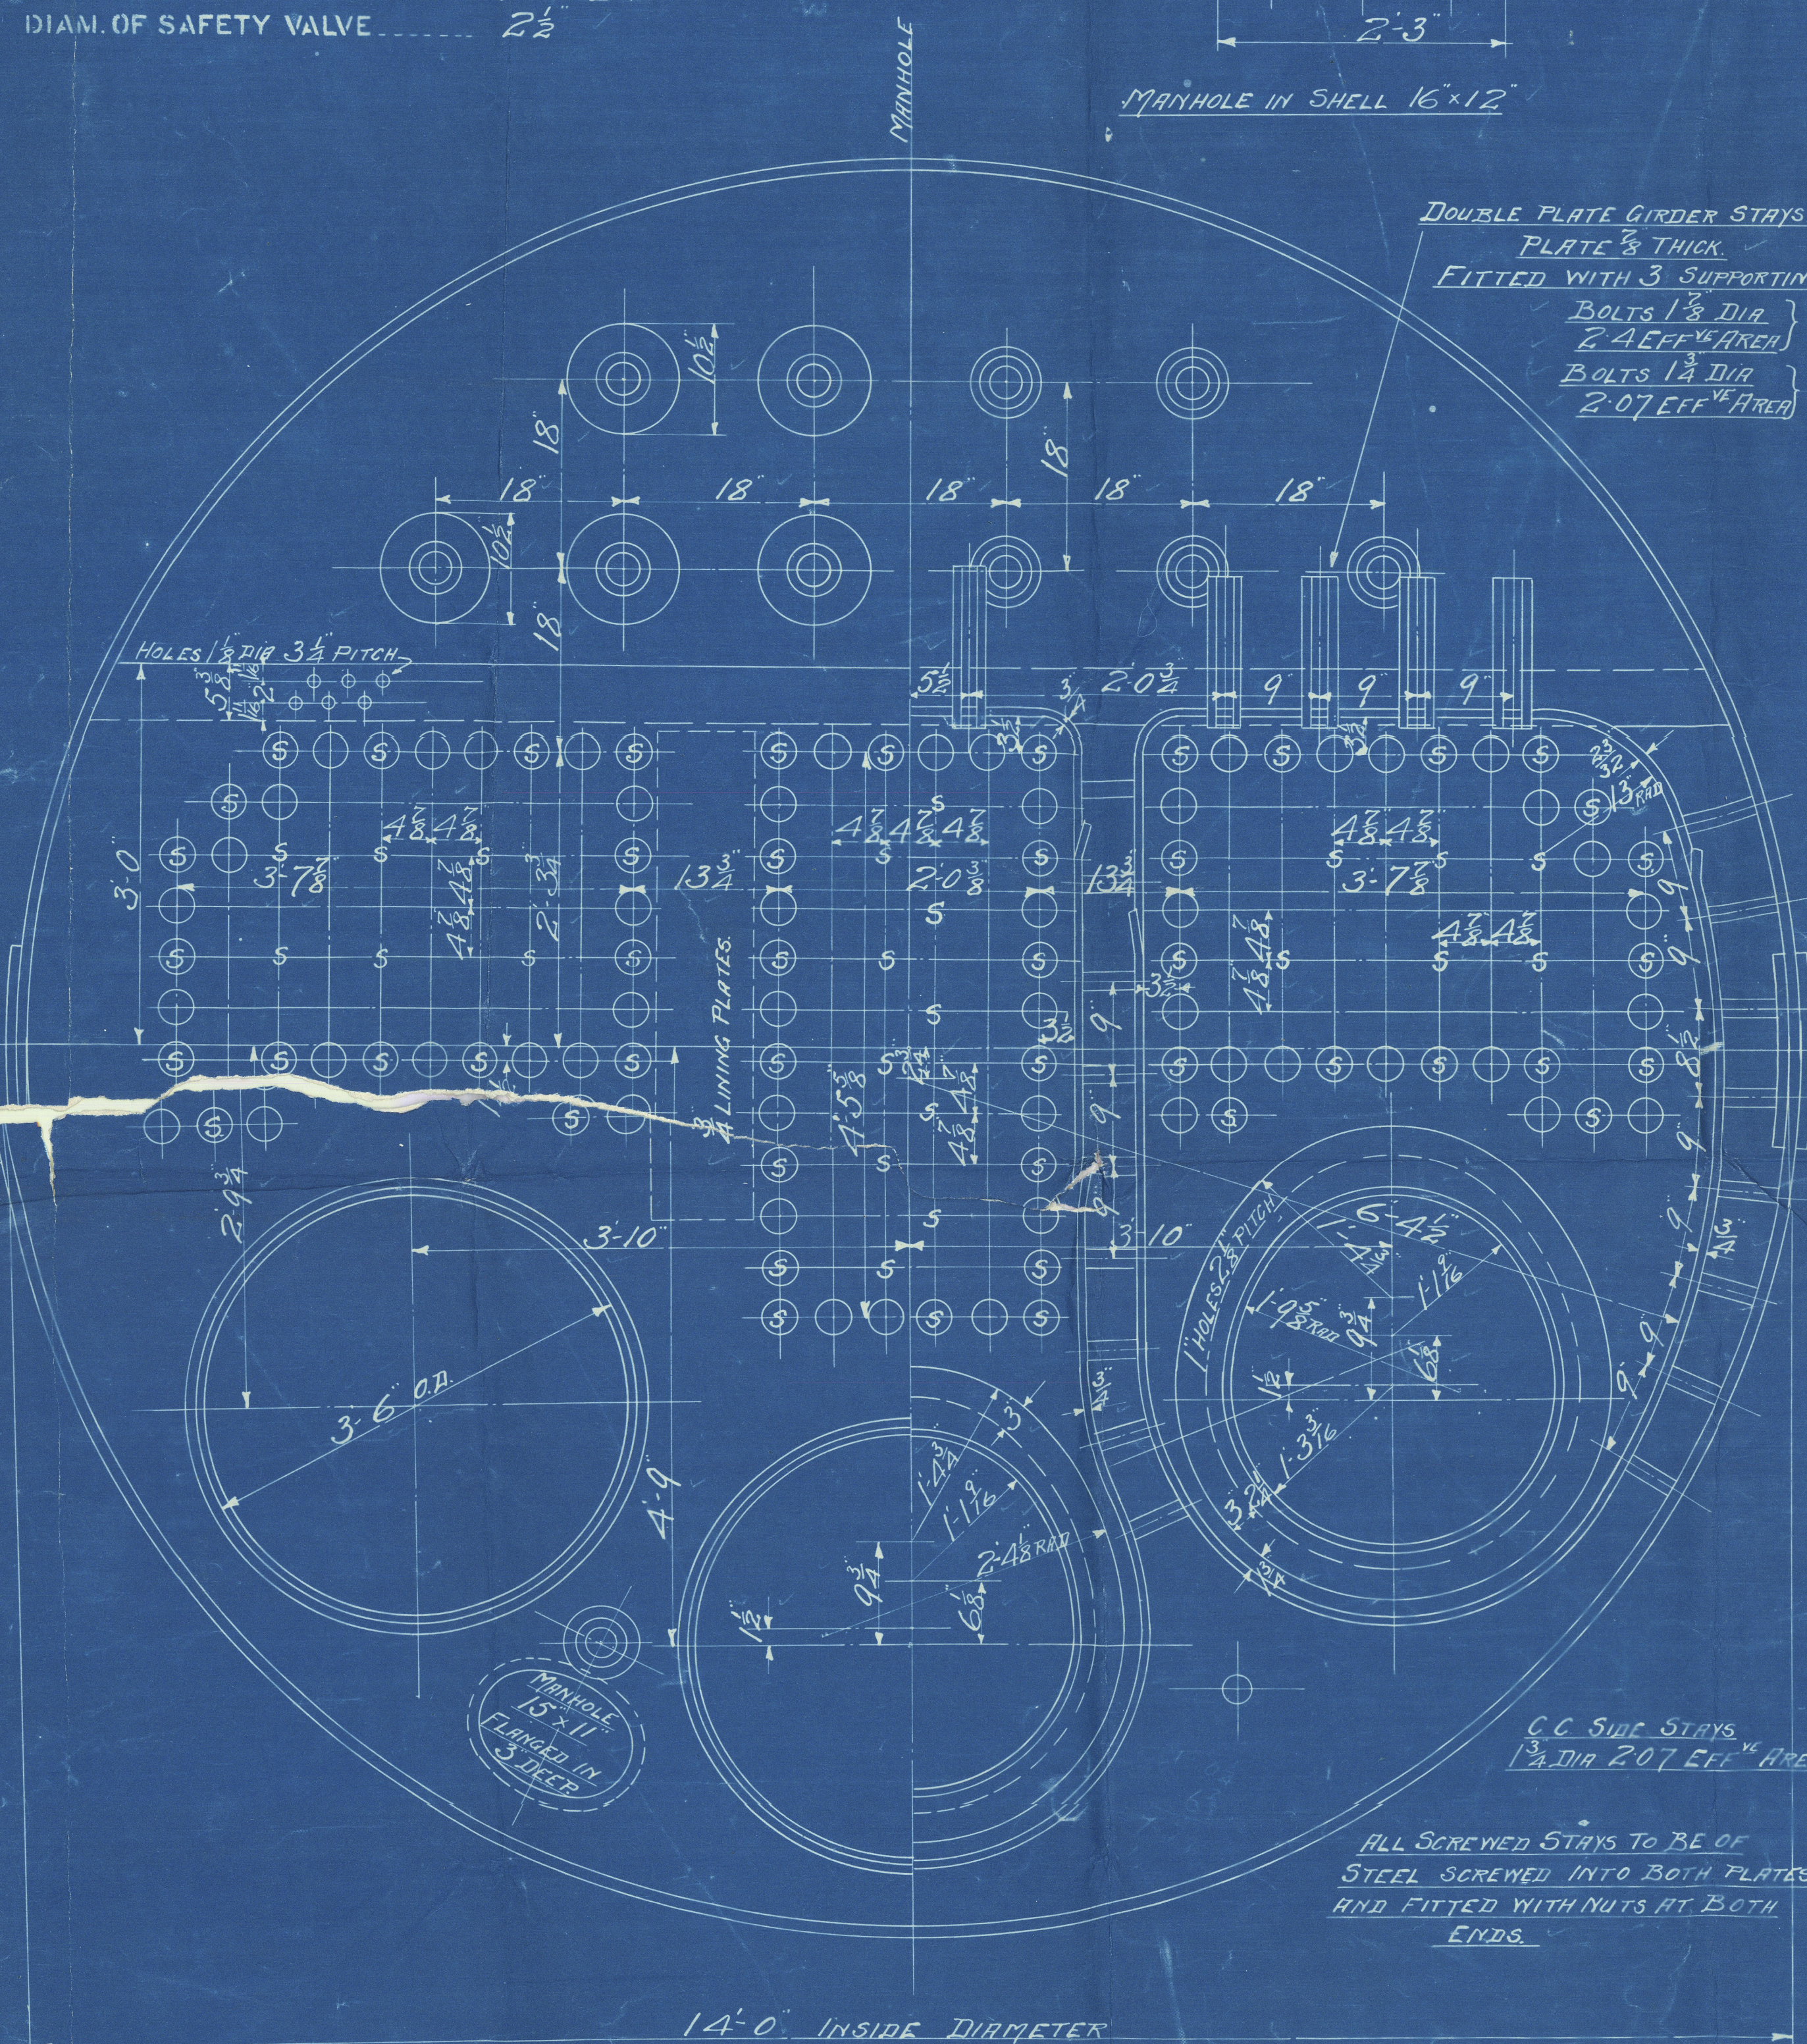

SCALE - 1" = 1 FOOT.

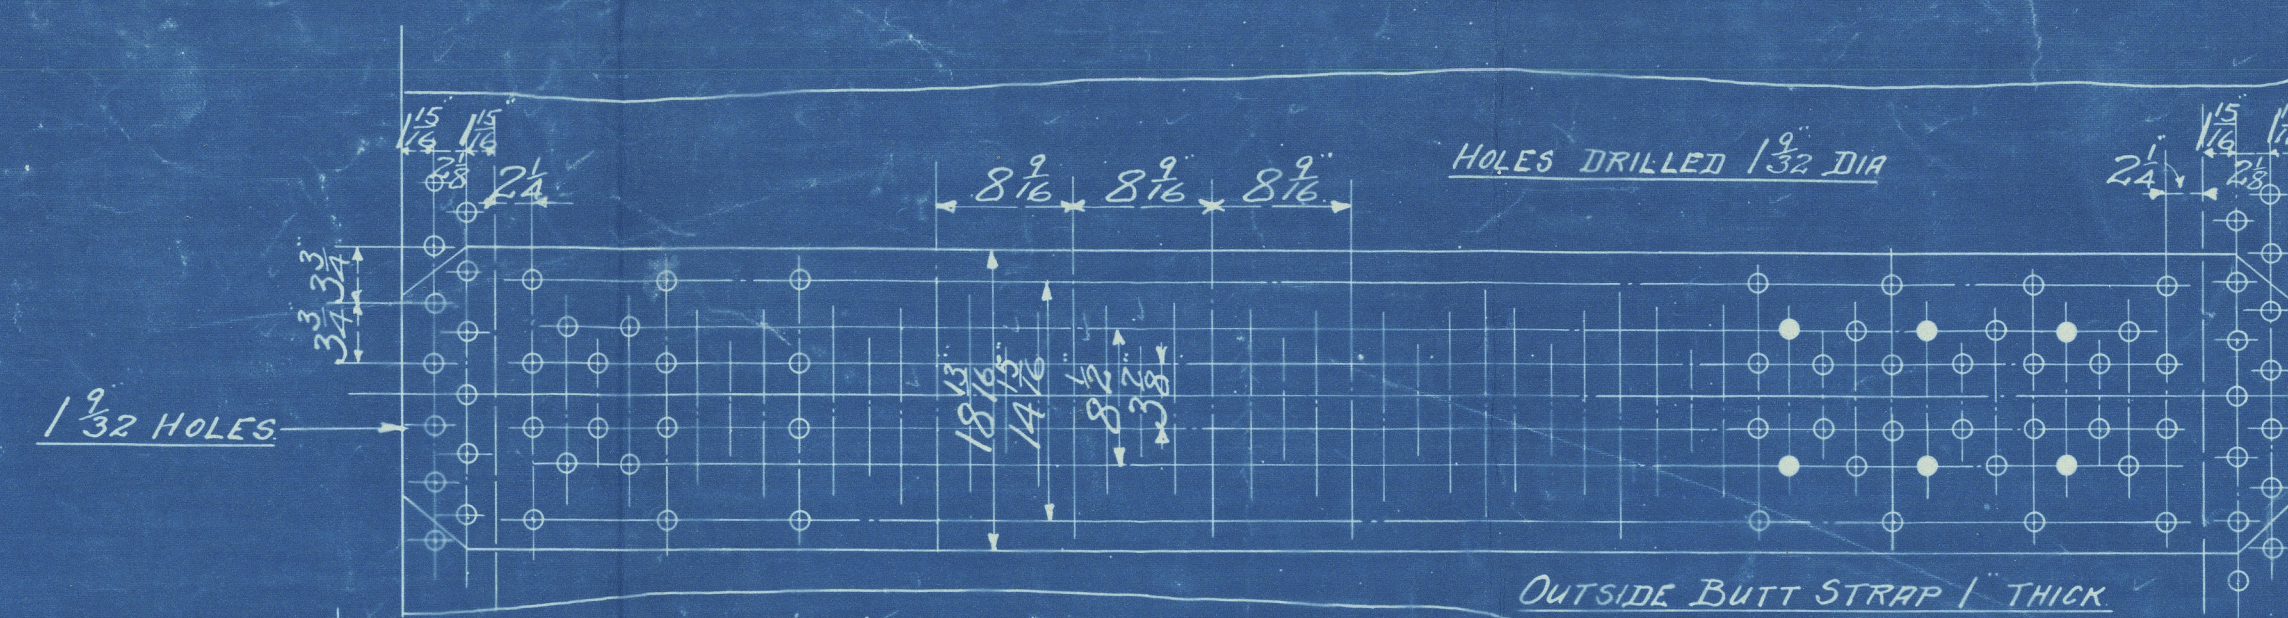

PERCENTAGE OF JOINT.
 PLATE 85.03%, RIVETS 908%
 COMBINED 88.83

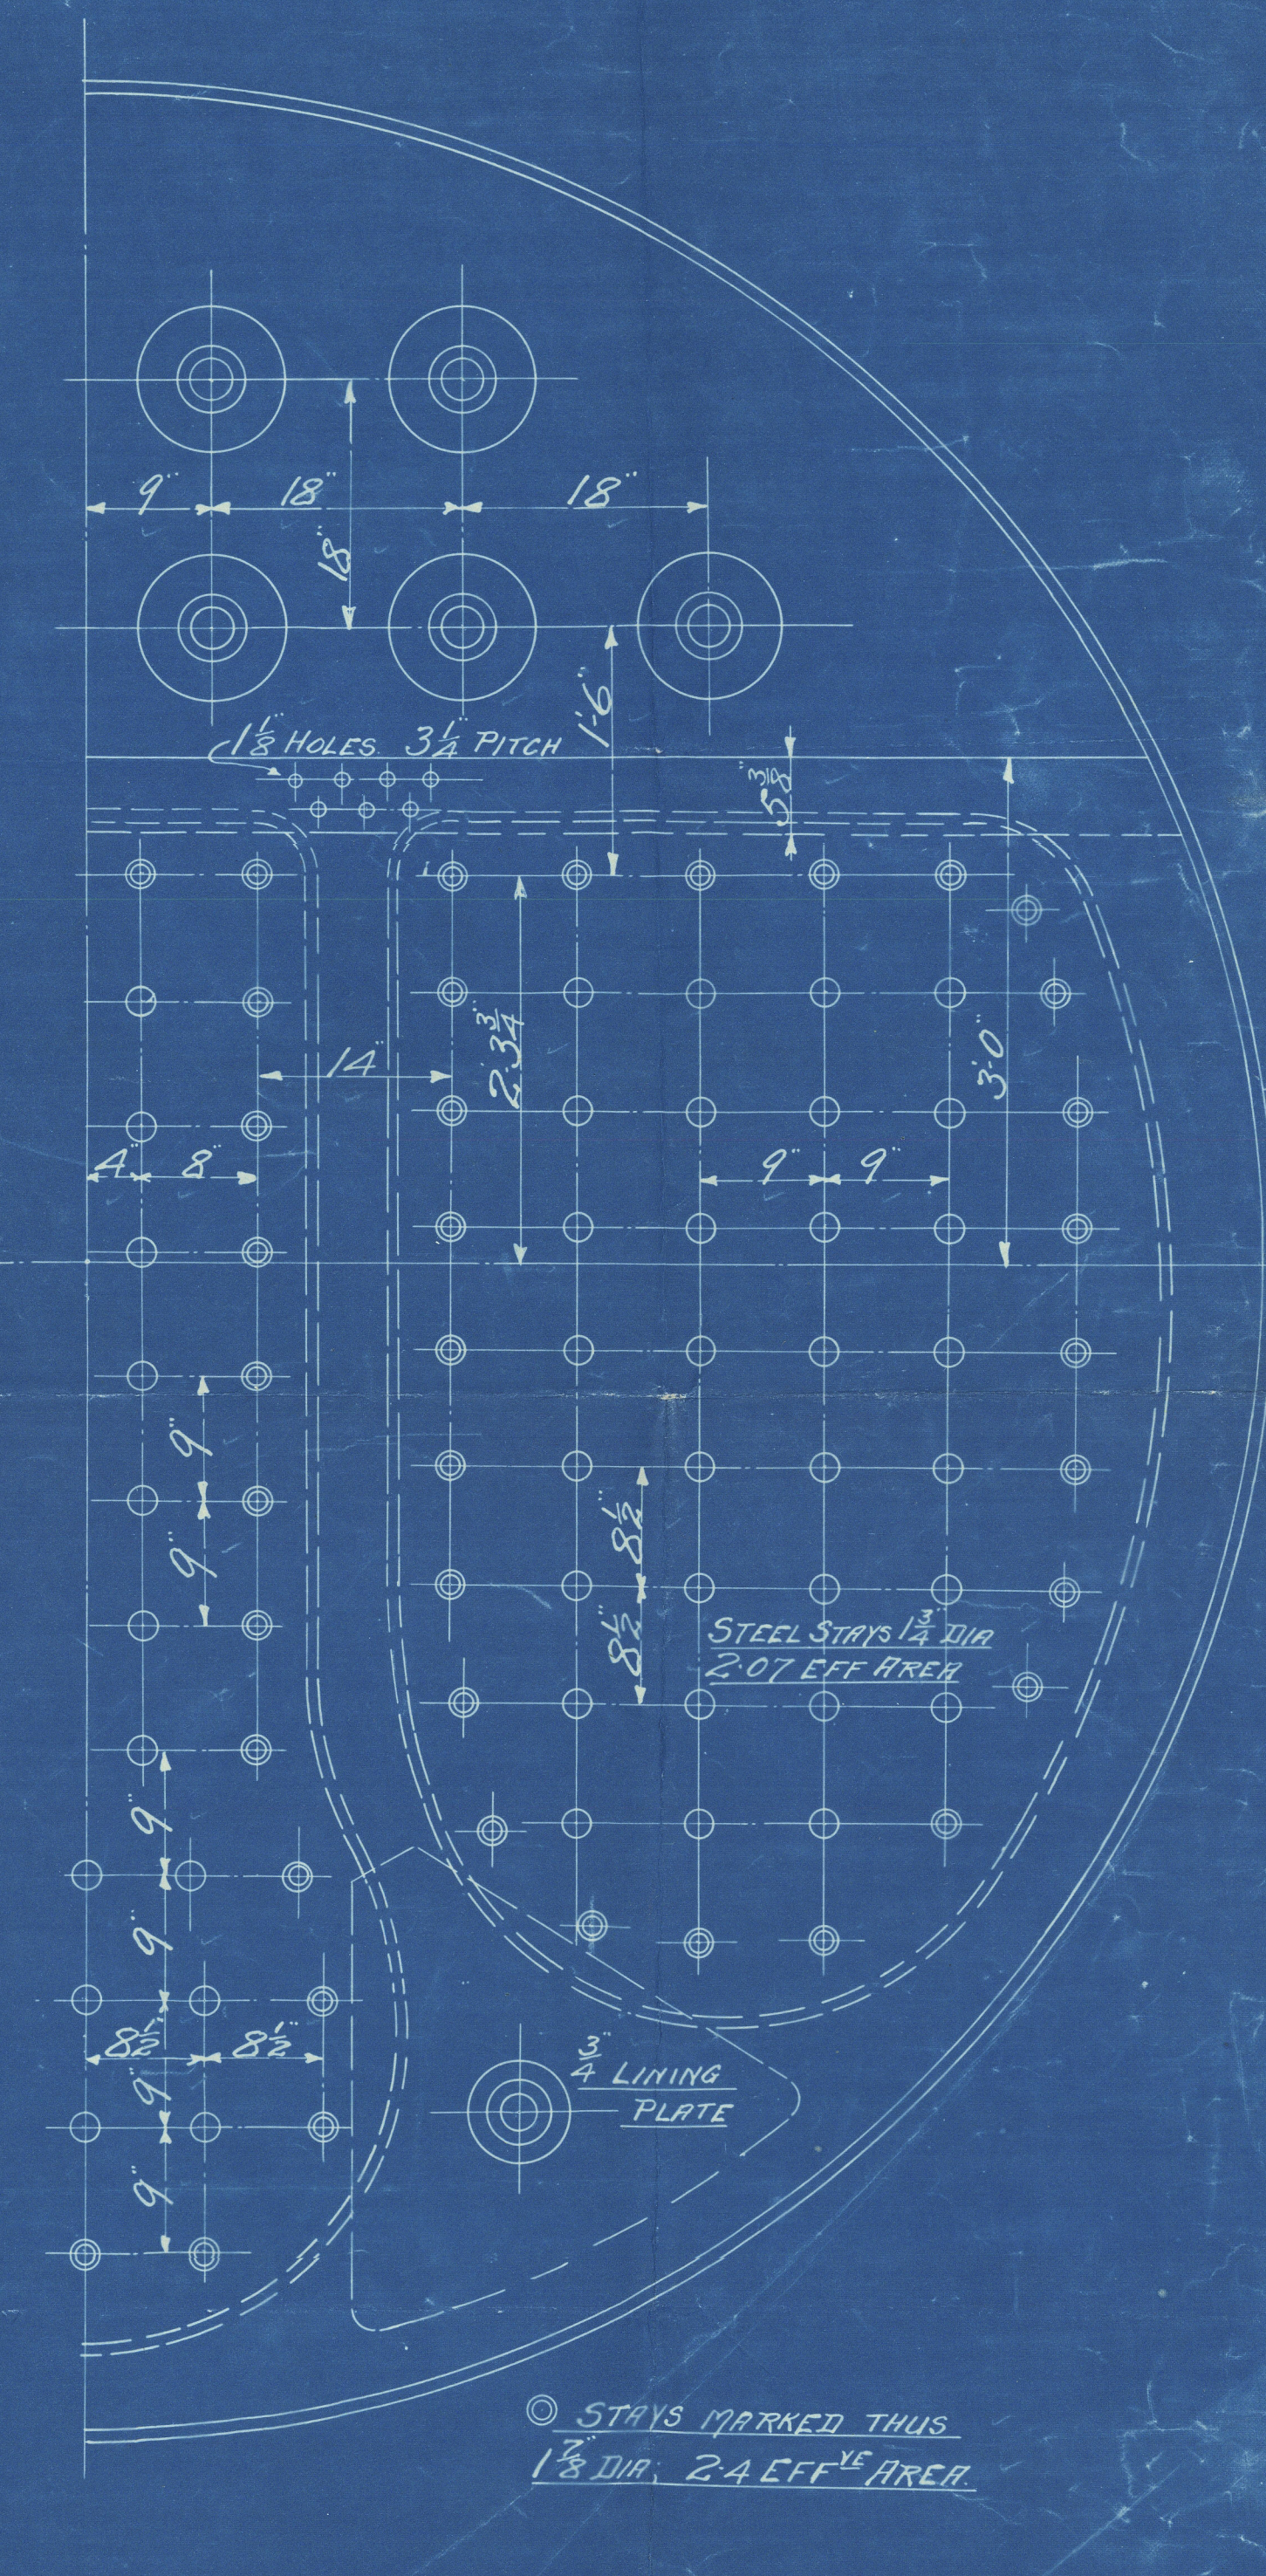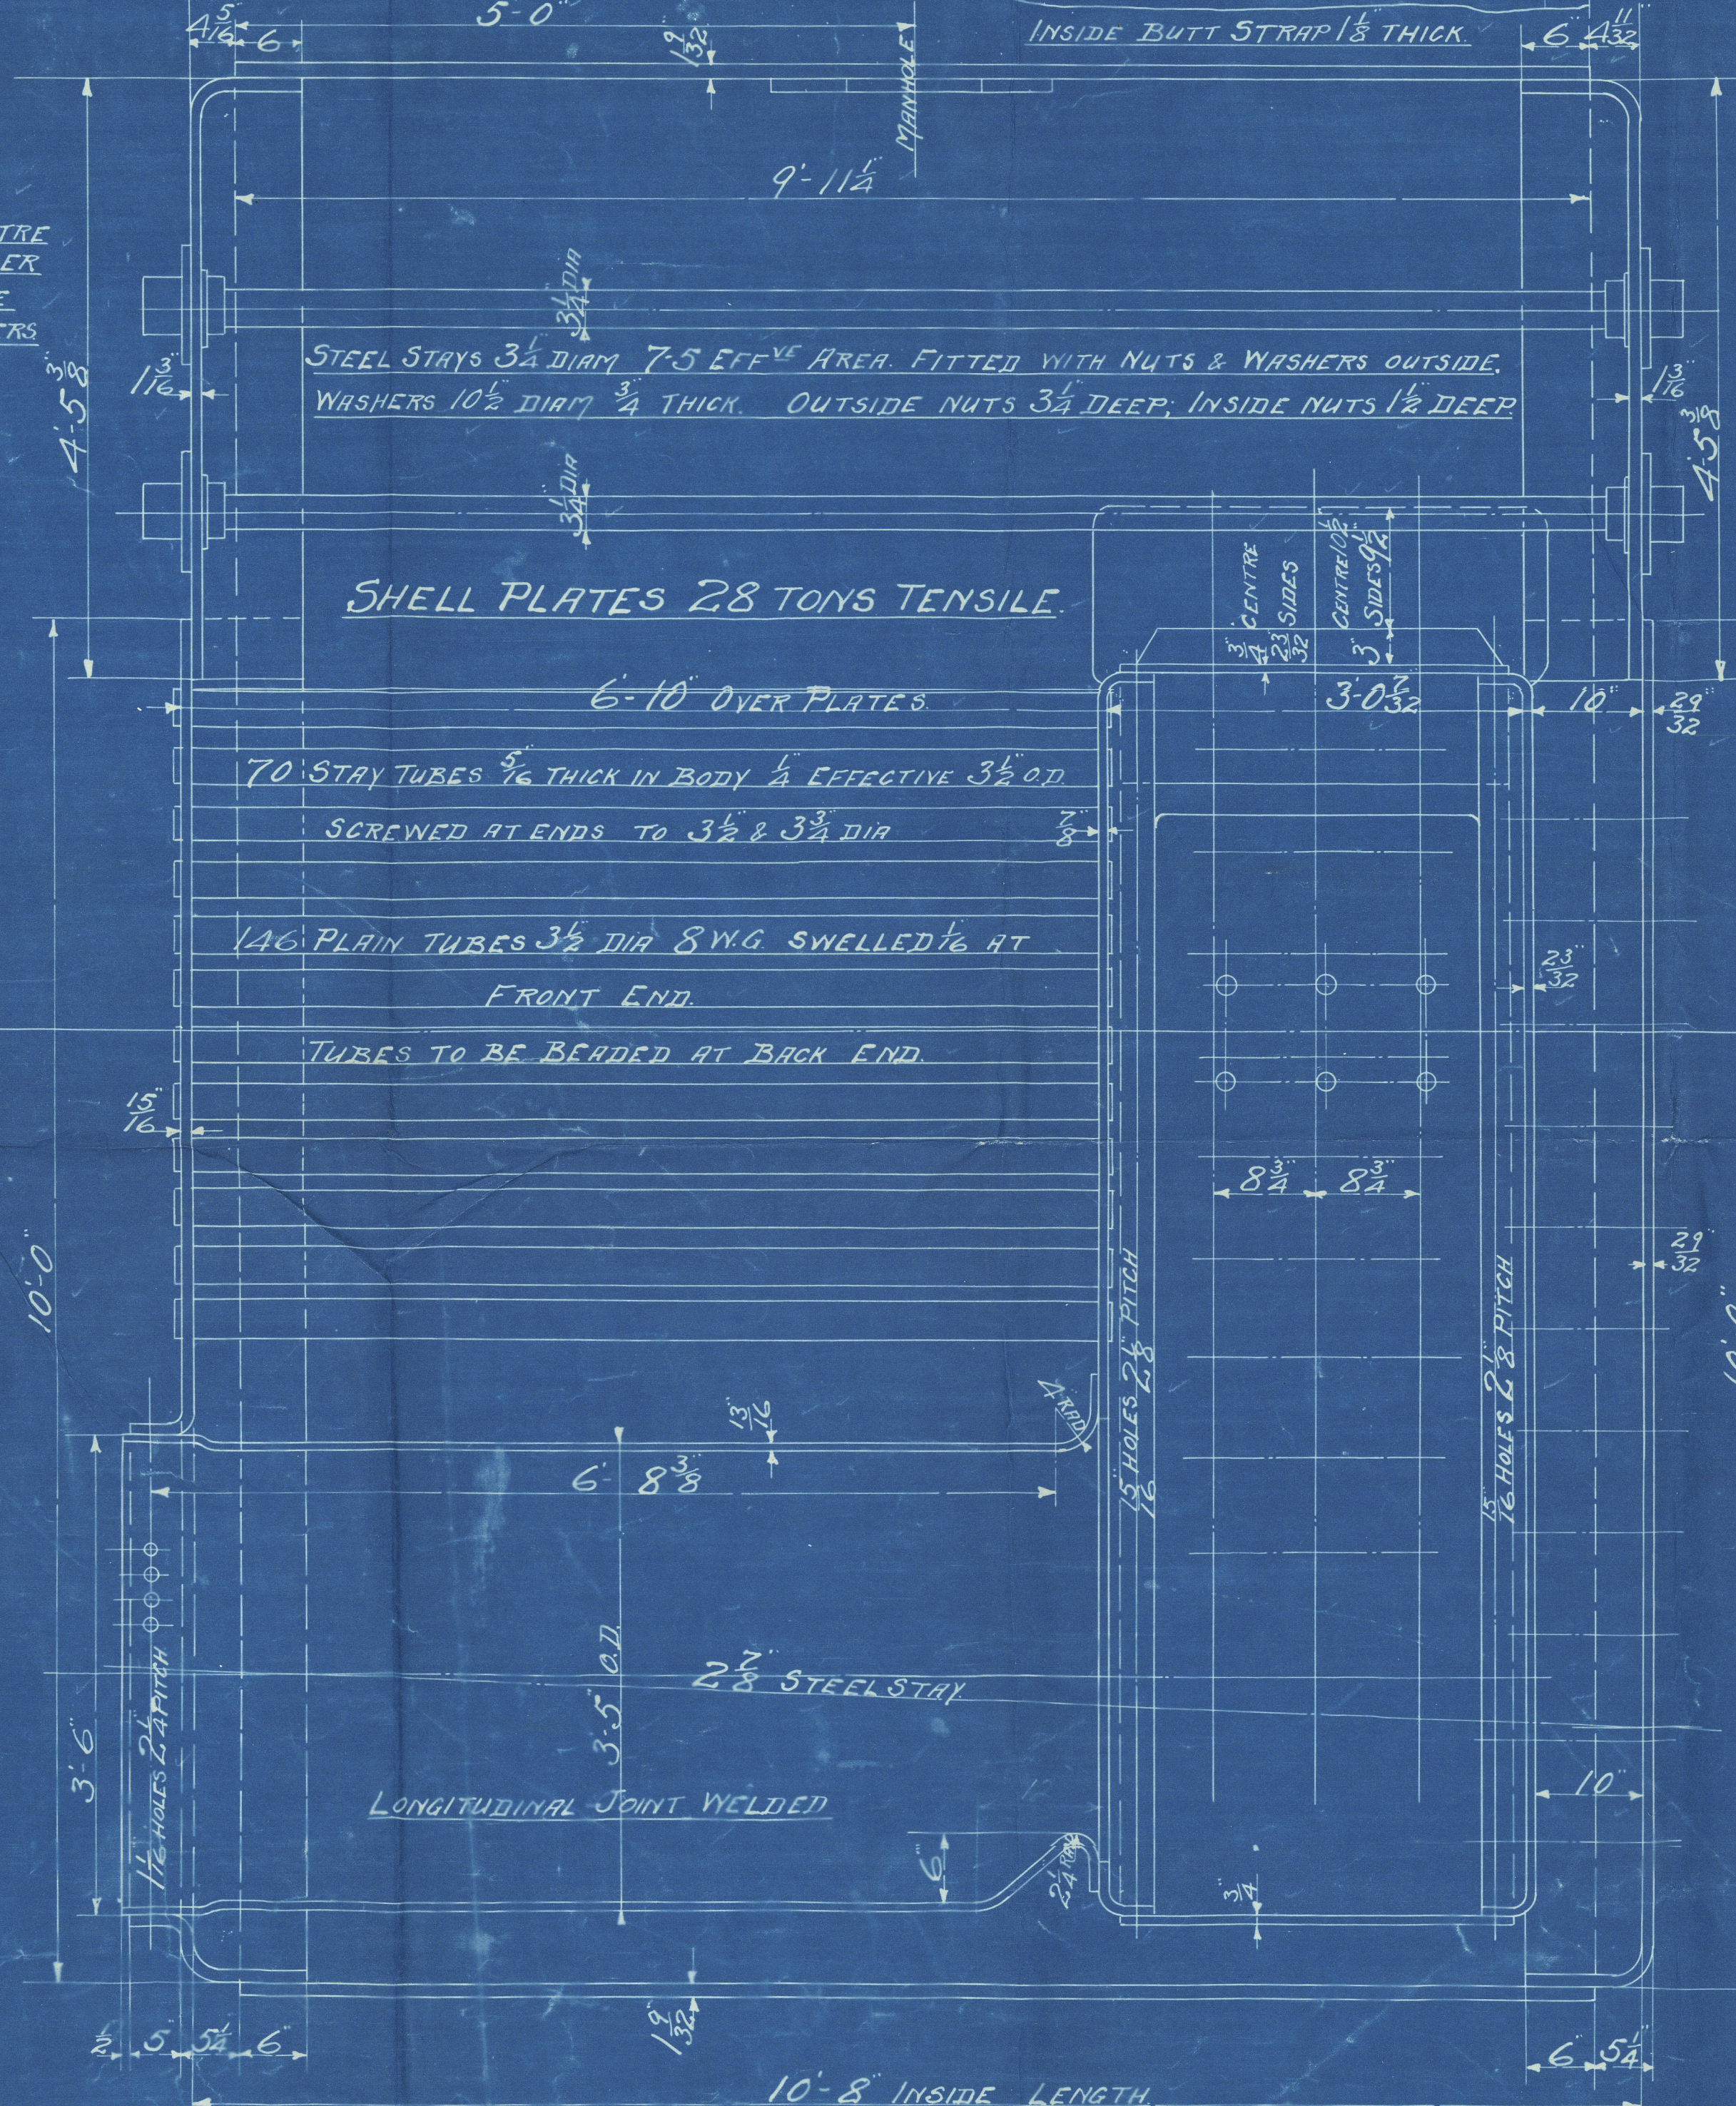

© STAYS MARKED THIS
 1 1/8" DIA. 2-4 EFF. AREA

STEEL BOILER NO 1356

CHARLES D. HOLMES & CO LTD
 ENGINEERS & BOILER MAKERS
 HULL 13-5-27

BULL
 6/11/28

PLAN NO 6992

DRAWER NO 112
 DRAWING NO 701

C&H Co Ld

Borles

1356

n/n "Kingston Sapphire"

Hul Rept. No. 396 '76.

RETAIL

RETAIL



© 2019

Lloyd's Register
Foundation

W987-0092