


DETAIL OF MAIN HATCH COAMINGS AT UPPER D<sup>5</sup>  
SCALE 1/2" = ONE FOOT

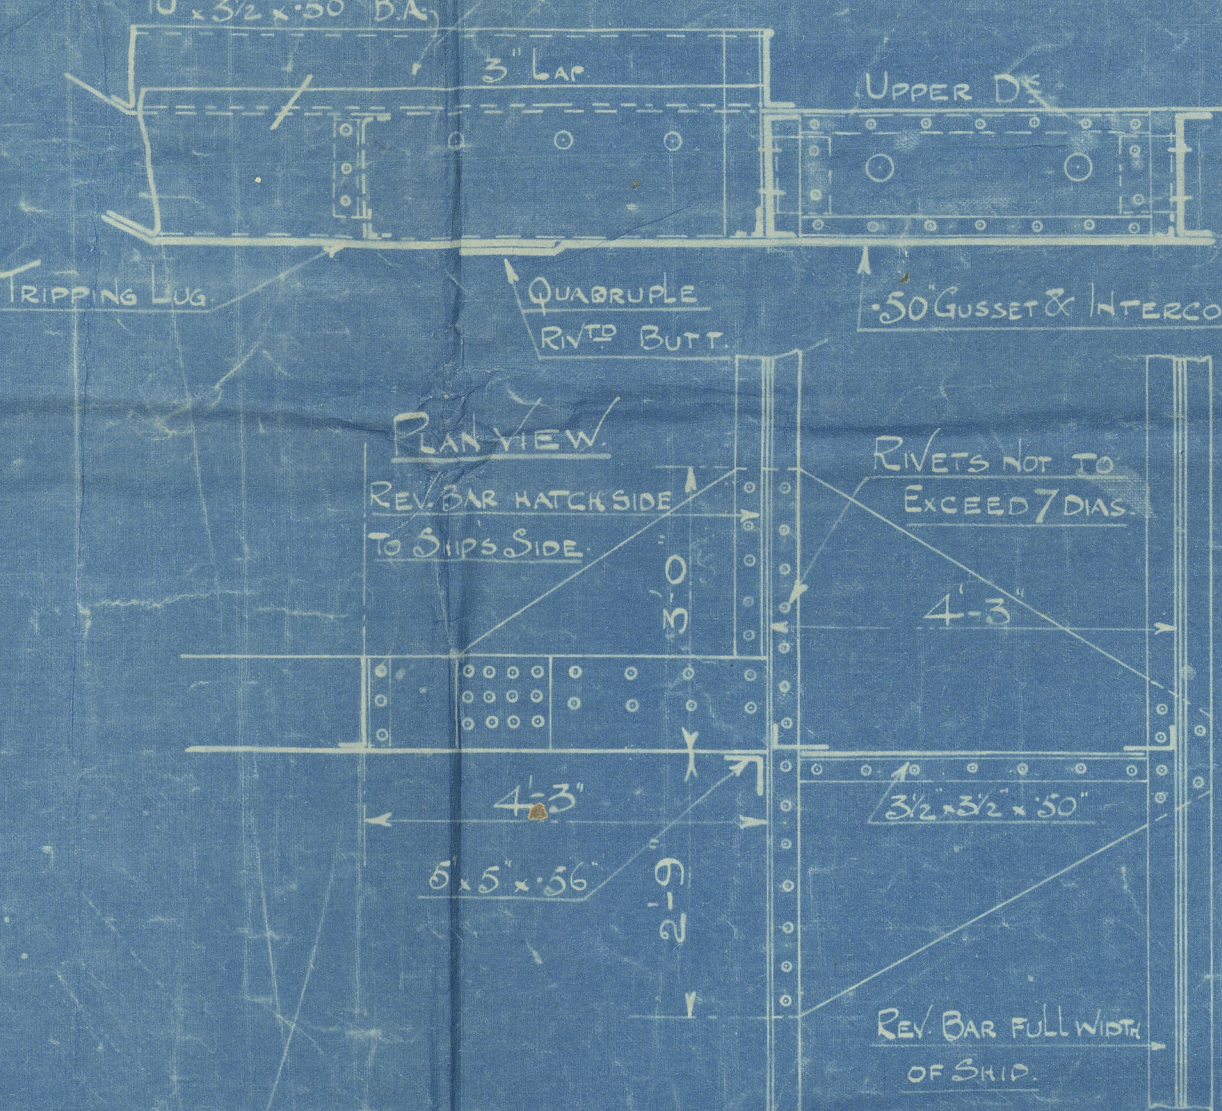

29-9 HATCH  
SIDE COAMING 100  
FLANGED 16  
RIDGE PLATE 12 x 70

34-0 HATCH  
SIDE COAMING 104  
FLANGED 16  
RIDGE PLATE 15 x 82


No 2  
S.S. CITTA - DI - MESSINA

# PROFILE & DECK PLAN.

LL5905 DIMS. - LENGTH 360' 6\"/>

SCALE 1/8\"/>

MAIN HATCHES.  
DETAIL OF SHELTER D<sup>5</sup> HATCH CORNER  
SCALE 1/2\"/>

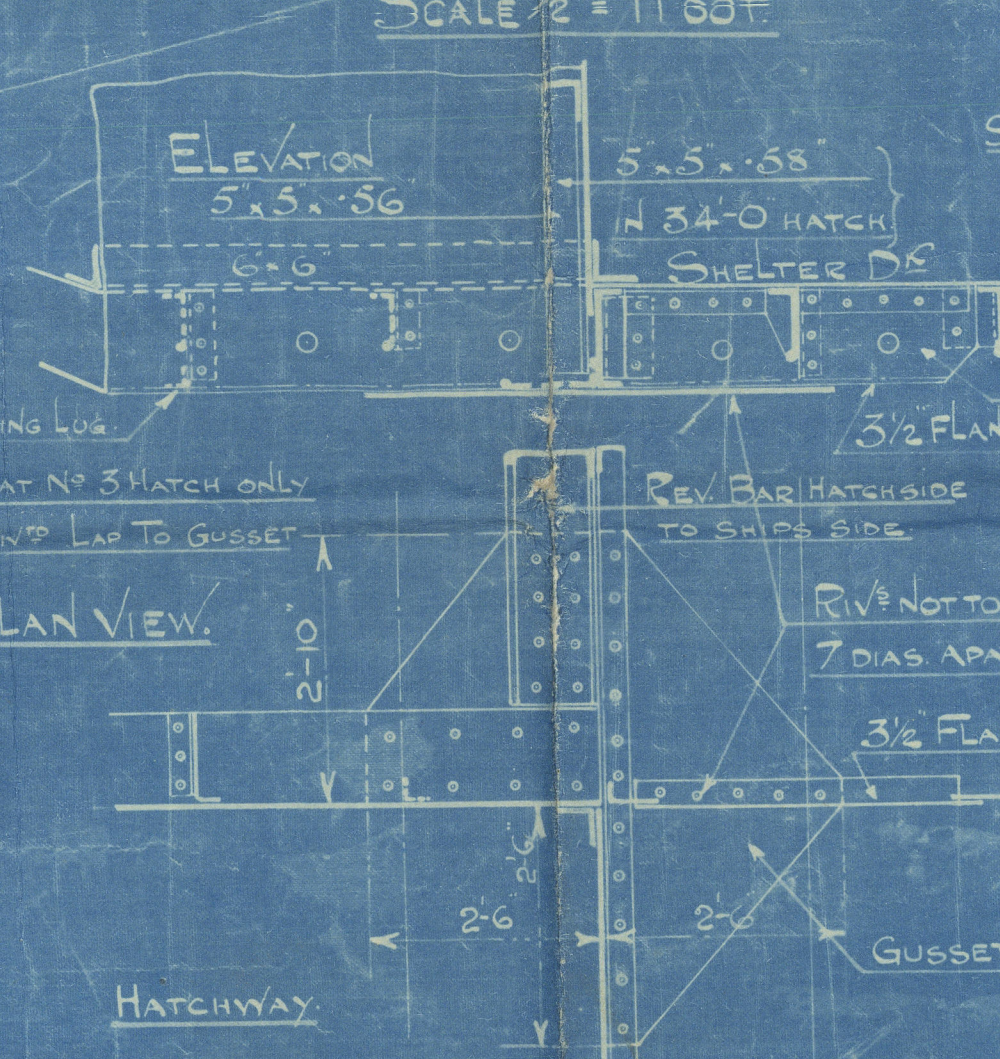


29-9 HATCH  
SIDE COAMING 100  
FLANGED 16  
RIDGE PLATE 12 x 70

34-0 HATCH  
SIDE COAMING 104  
FLANGED 16  
RIDGE PLATE 15 x 82

7/8\"/>

FO'LE DECK  
STEERING ANGLE 3/4\"/>

 

6.50  
X 1753  
4.1.21



FURNESS. S. B CO<sup>S</sup> LTD.

N<sup>o</sup> 2.

S. S. CITTA-DI-MESSINA

PROFILE AND DECK. PLANS

(as-built)

Genl. Rpt. No 10882

N/N " KING ROBERT "



© 2019

Lloyd's Register  
Foundation

W987-0145