

DIM^s 450'-0" x 58'-0" M² x 40'-0" M²
CLASS ~~BRITISH CORPORATION'S~~ LLOYD'S 100 A1
SCALE 1/2" = 1 FOOT

CLASS ~~BRITISH CORPORATION'S~~ LLOYD'S 100 A1


SCALE $\frac{1}{2}'' = 1 \text{ FOOT}$

Barclay Curle & Co.

Midships Section


N^o 572.

7910-686m

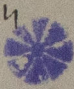M^m "FRESNO STAR" 

GLASGOW REPORT No. 39394

S/S ^{EX} Woodarra.
now named
"FRESNO STAR"

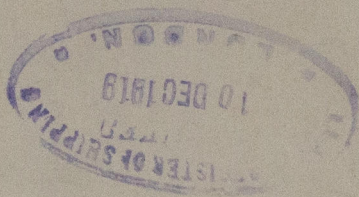

RETAIN



© 2020

Lloyd's Register
Foundation