

[illegible]

PILLARING THROUGHOUT TO SURVEYORS SATISFACTION.

DIMENSIONS - 125-0 BPX 22'-9" EX x 13-1 MLD

COOK, WELTON, & GEMMELL, L<sup>TD</sup>  
SHIPBUILDERS  
BEVERLEY.

[illegible]

© 2009  
Lloyd's Register  
Foundation  
H90-0014



Cook, Blanton Hemmels  
No 314

Profile Deck.




Loch Hope

Ex.



S.S. "Princess Marie José"

Hull Rpt No 28360.

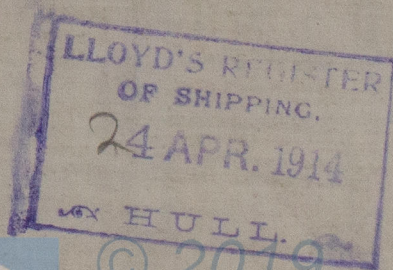

© 2019

Lloyd's Register  
Foundation

W990-0014