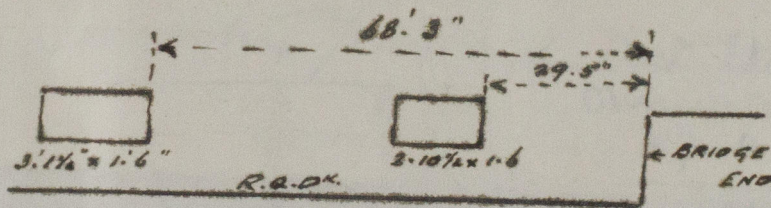


GLASGOW REPORT No. 52391

"THE VICEROY"

1. The air pipes in the forward well and raised quarter deck 11" in height, have the height to the opening increased to 36" and 30" respectively.
2. The freeing port area on each side of the raised quarter deck has been increased to $22\frac{1}{2}$ sq. feet by fitting two additional ports on each side thus:-

*W.L.*
27.5.32.*Particulars noted on report**L.O.B*

28.5.32



© 2020

Lloyd's Register
Foundation