

MIDSHIP SECTION

N.H.M.T. "ALIDA" 480

NUMERALS

$$\begin{aligned} 12.13 \quad B + D &= 22.83 + 13.60 \\ &= 36.43 \text{ TRANS } N^o \\ L \times (B + D) &= 128.33 \times (22.83 + 13.60) \\ &= 4594 \text{ LONG } N^o \end{aligned}$$

DIMENS. LENGTH B.P. 128'-4" x BREADTH EX. 23'-0" x DEPTH M^d 13'-6"

SCALE 1/2" = 1 FOOT


To CLASS 100 A.I. LLOYDS FOR FISHING PURPOSES

$$\frac{L}{B} = 5.54$$

$$\frac{L}{D} = 9.74$$

EQUIPMENT

1 BOWER ANCHOR STOCKLESS	11 CWTs	4 1/2 cuts
1 KEDGE ANCHOR EX STOCK	28 -"	6 1/2 cuts
105 FATHOMS 1 1/16" DIA. STUD LINK CHAIN		3 cuts
60 -" 6" HAWSER.		
60 -" 4 1/2" WARP.	5" warp	

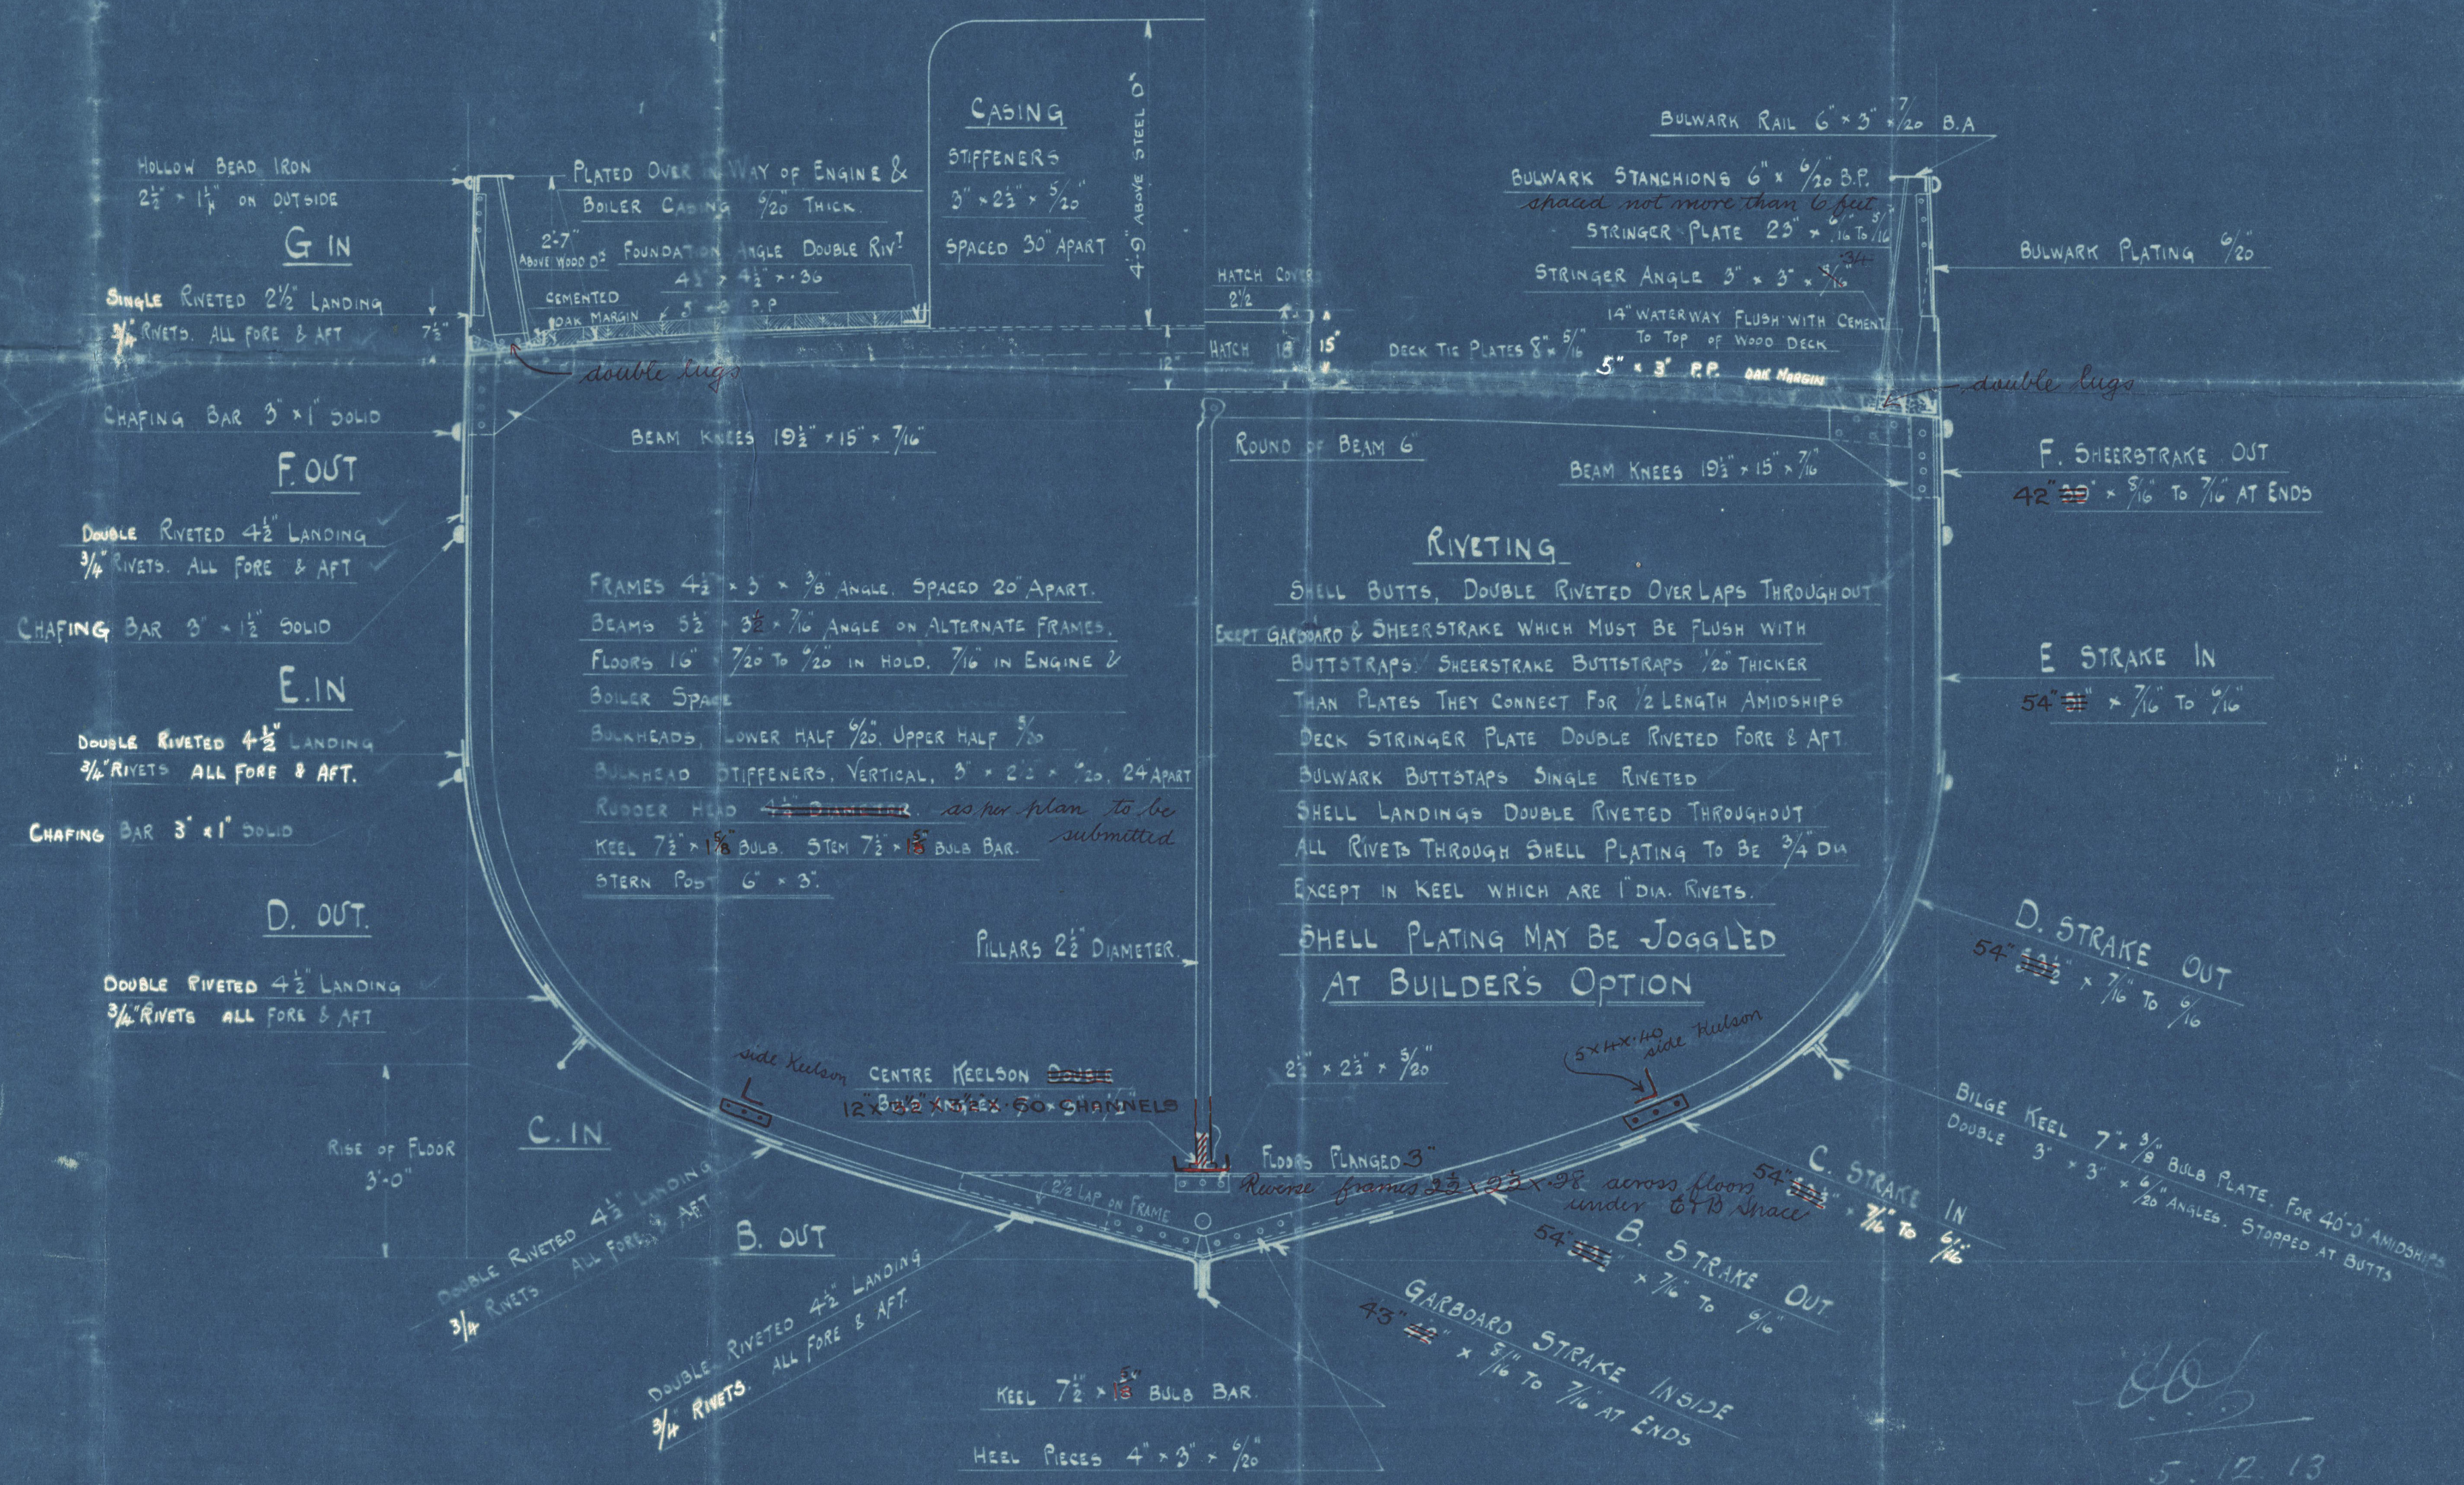

28/11/13

21 DEC 1915

MIDSHIP SECTION as Built.

DUNDEE S.B. Co., Ltd.

YARD N.° 275

STM. TRAWL. "ALIDA"

DUN. RPT. N.° 7912.



MAIN



© 2020

Lloyd's Register
Foundation

1991-0162