

FAMAGUSTA of London

O/N 181521

GT 454.20

NT 292.67

UD 274.98

W.B. 744 TONS

O.F. 2x15 TONS

BUR 1943



Sir Wm. Arncliffe
Partick Glasgow

P 25.4 Tons

T 75.59 "

F 14.00 "

Owner: William Bartram Cecil-Lowe
+ Mgr: P.O. Box 15 Famagusta Cyprus

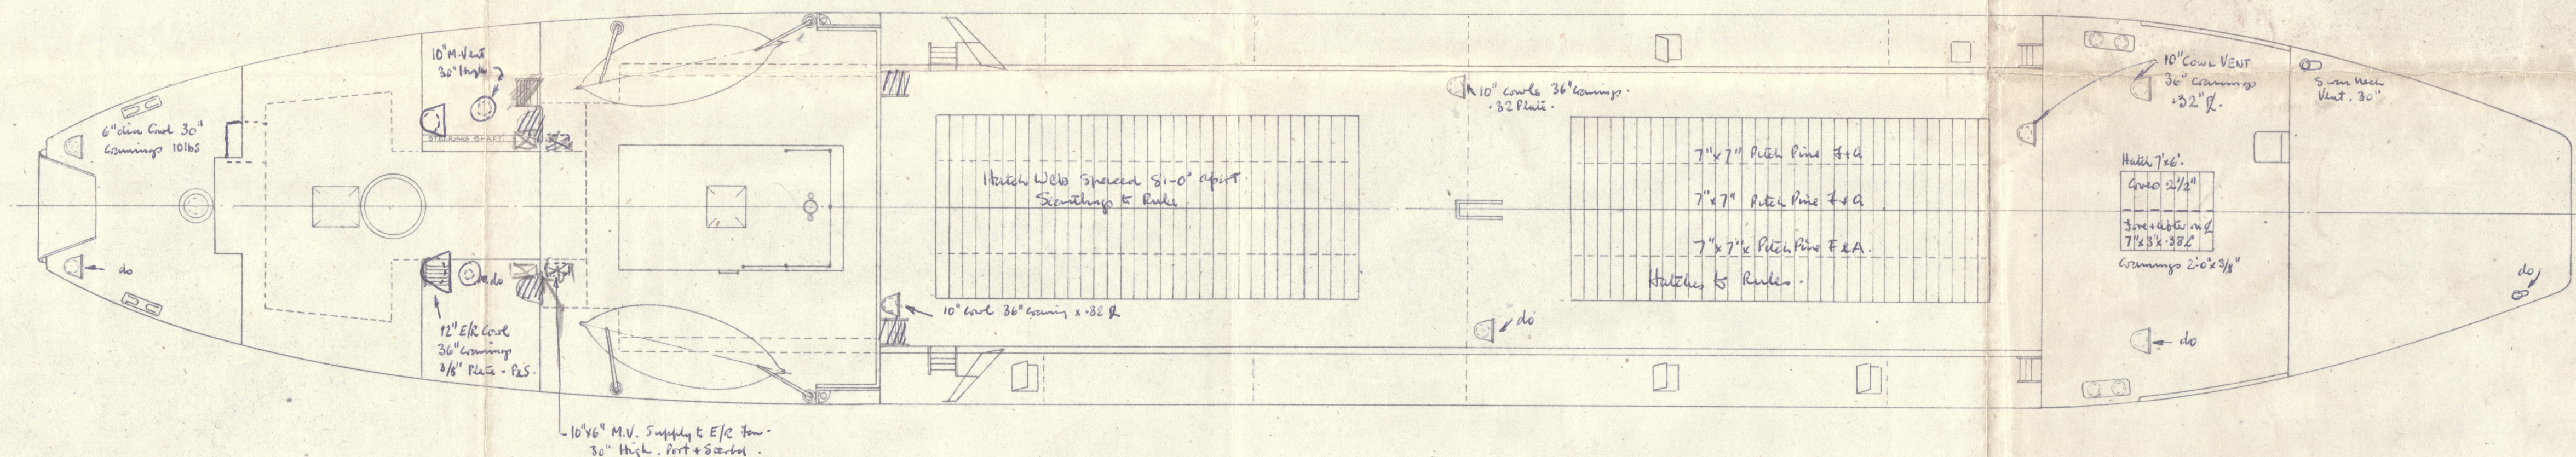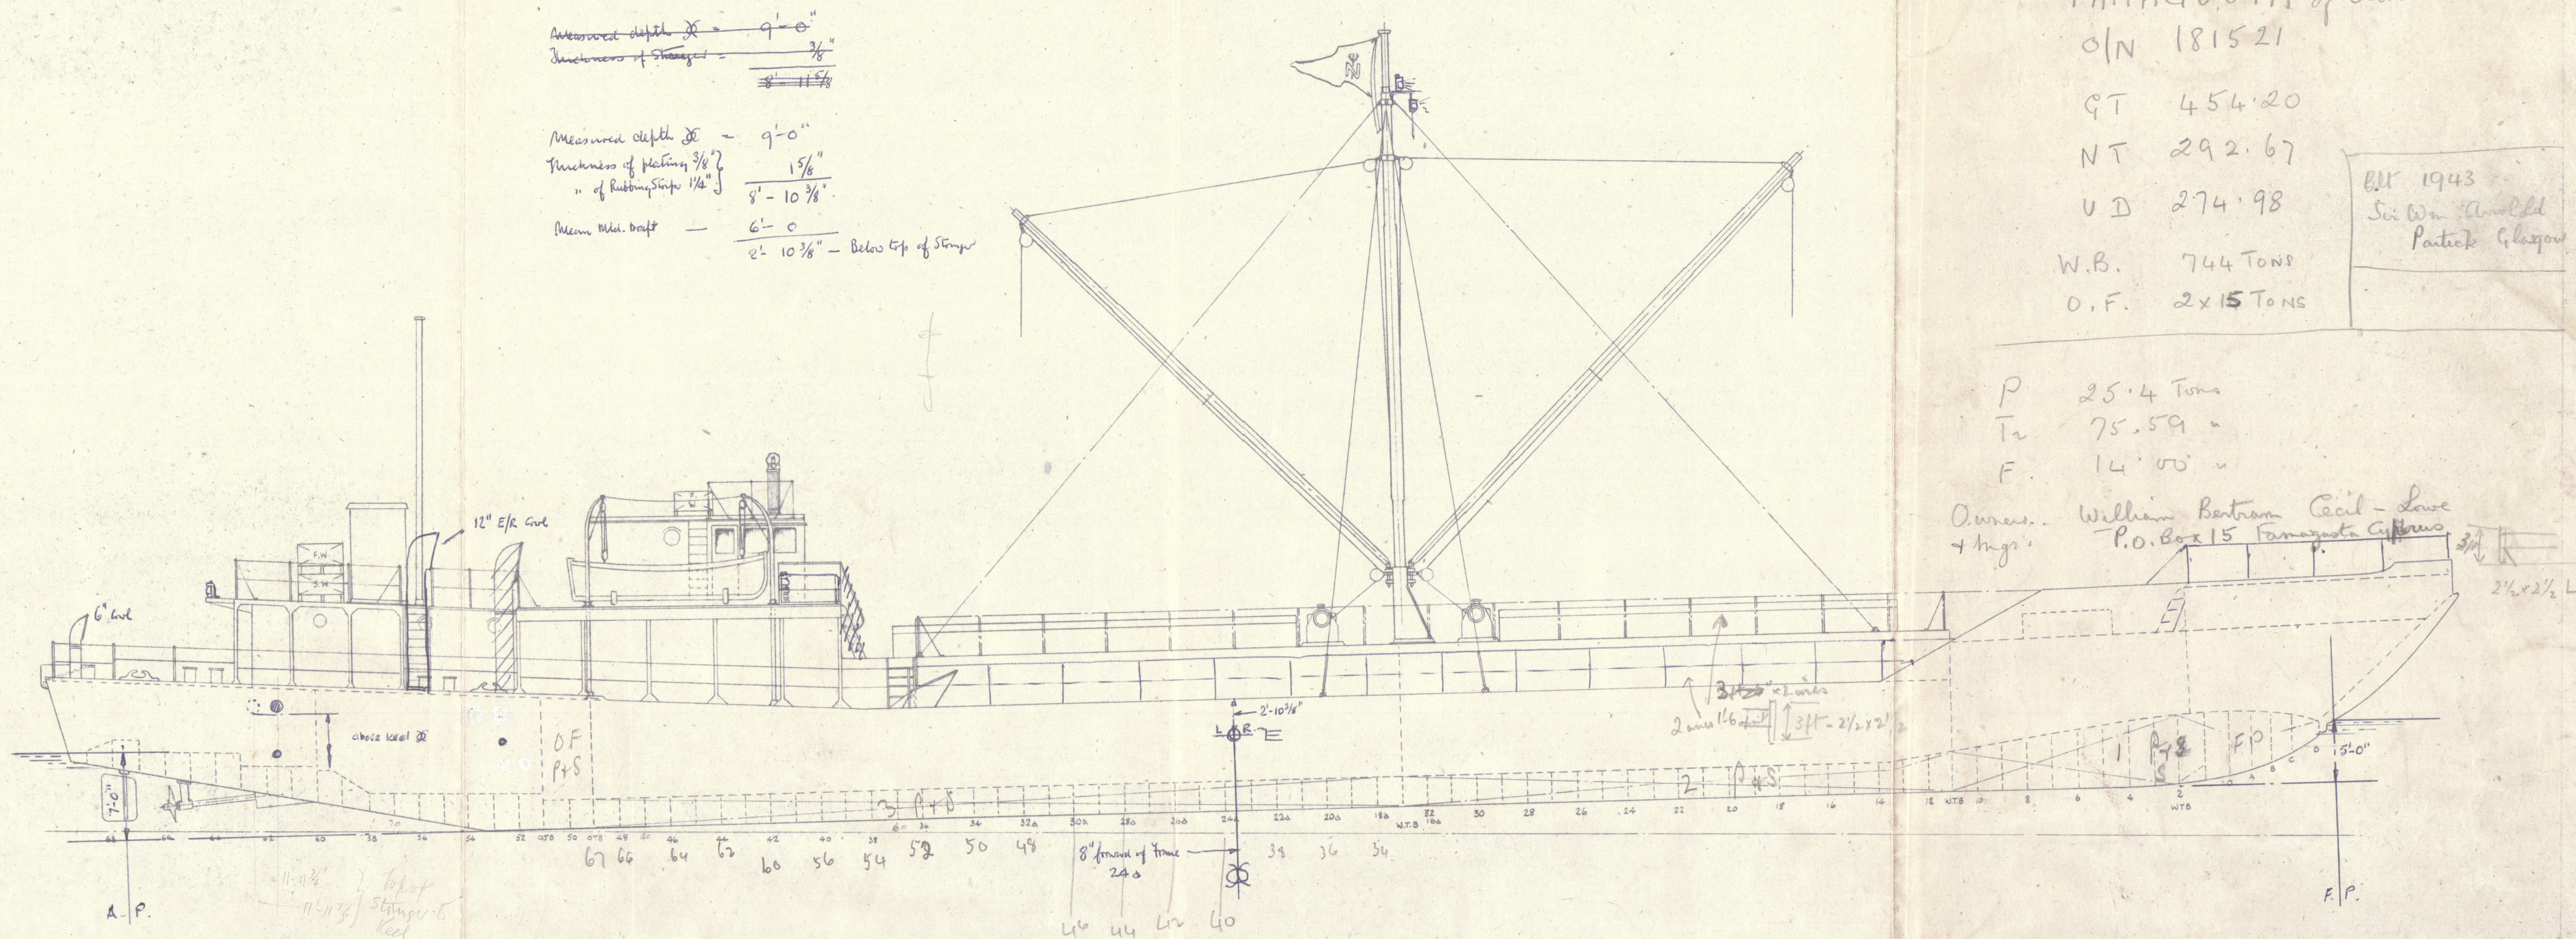


Ventilation Plugs + Covers

Coil Vents: Wood plugs + canvas covers to be supplied for all 44 coil vents.

Machroom Vents: Canvas covers to be supplied.

Summ. Deck air Vents: to be fitted with Wood Plugs in jack chains.

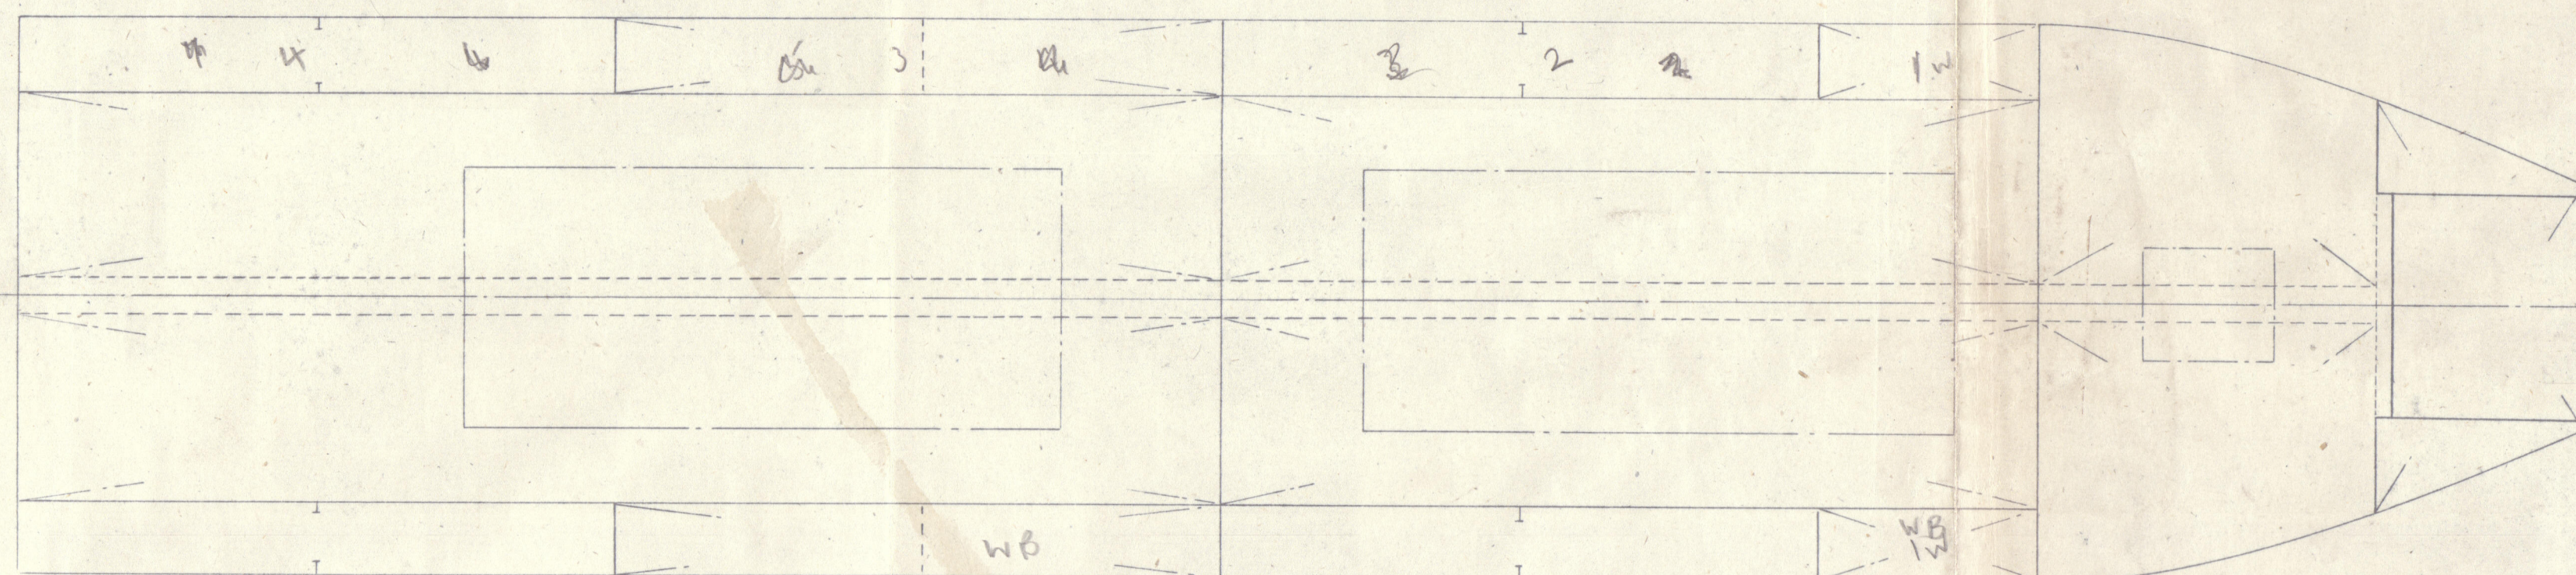

W. Pitt

30 x 9 x 4 #080

27

M.V. "Famagusta" - The Neptune Shipping + Trading Co. Ltd.

Scale 1/8" = 1 foot.

C.V. Hughes
53 Woodside Avenue,
Essex, Surrey

© 2020

Lloyd's Register
Foundation

W942-0187