


# GENERAL ARRANGEMENT M.V. FAMAGUSTA



## PRINCIPAL DIMENSIONS.

LENGTH (B.P.) - 175 FEET. LENGTH OVERALL - 181 FT 4 1/2 INS.  
BREADTH (M.L.D.P.) - 30 FEET. DEPTH (M.L.D.P.) - 8 FT 9 1/2 INS.

REG. TONNAGE - GROSS 454.2 : NET 292.67.

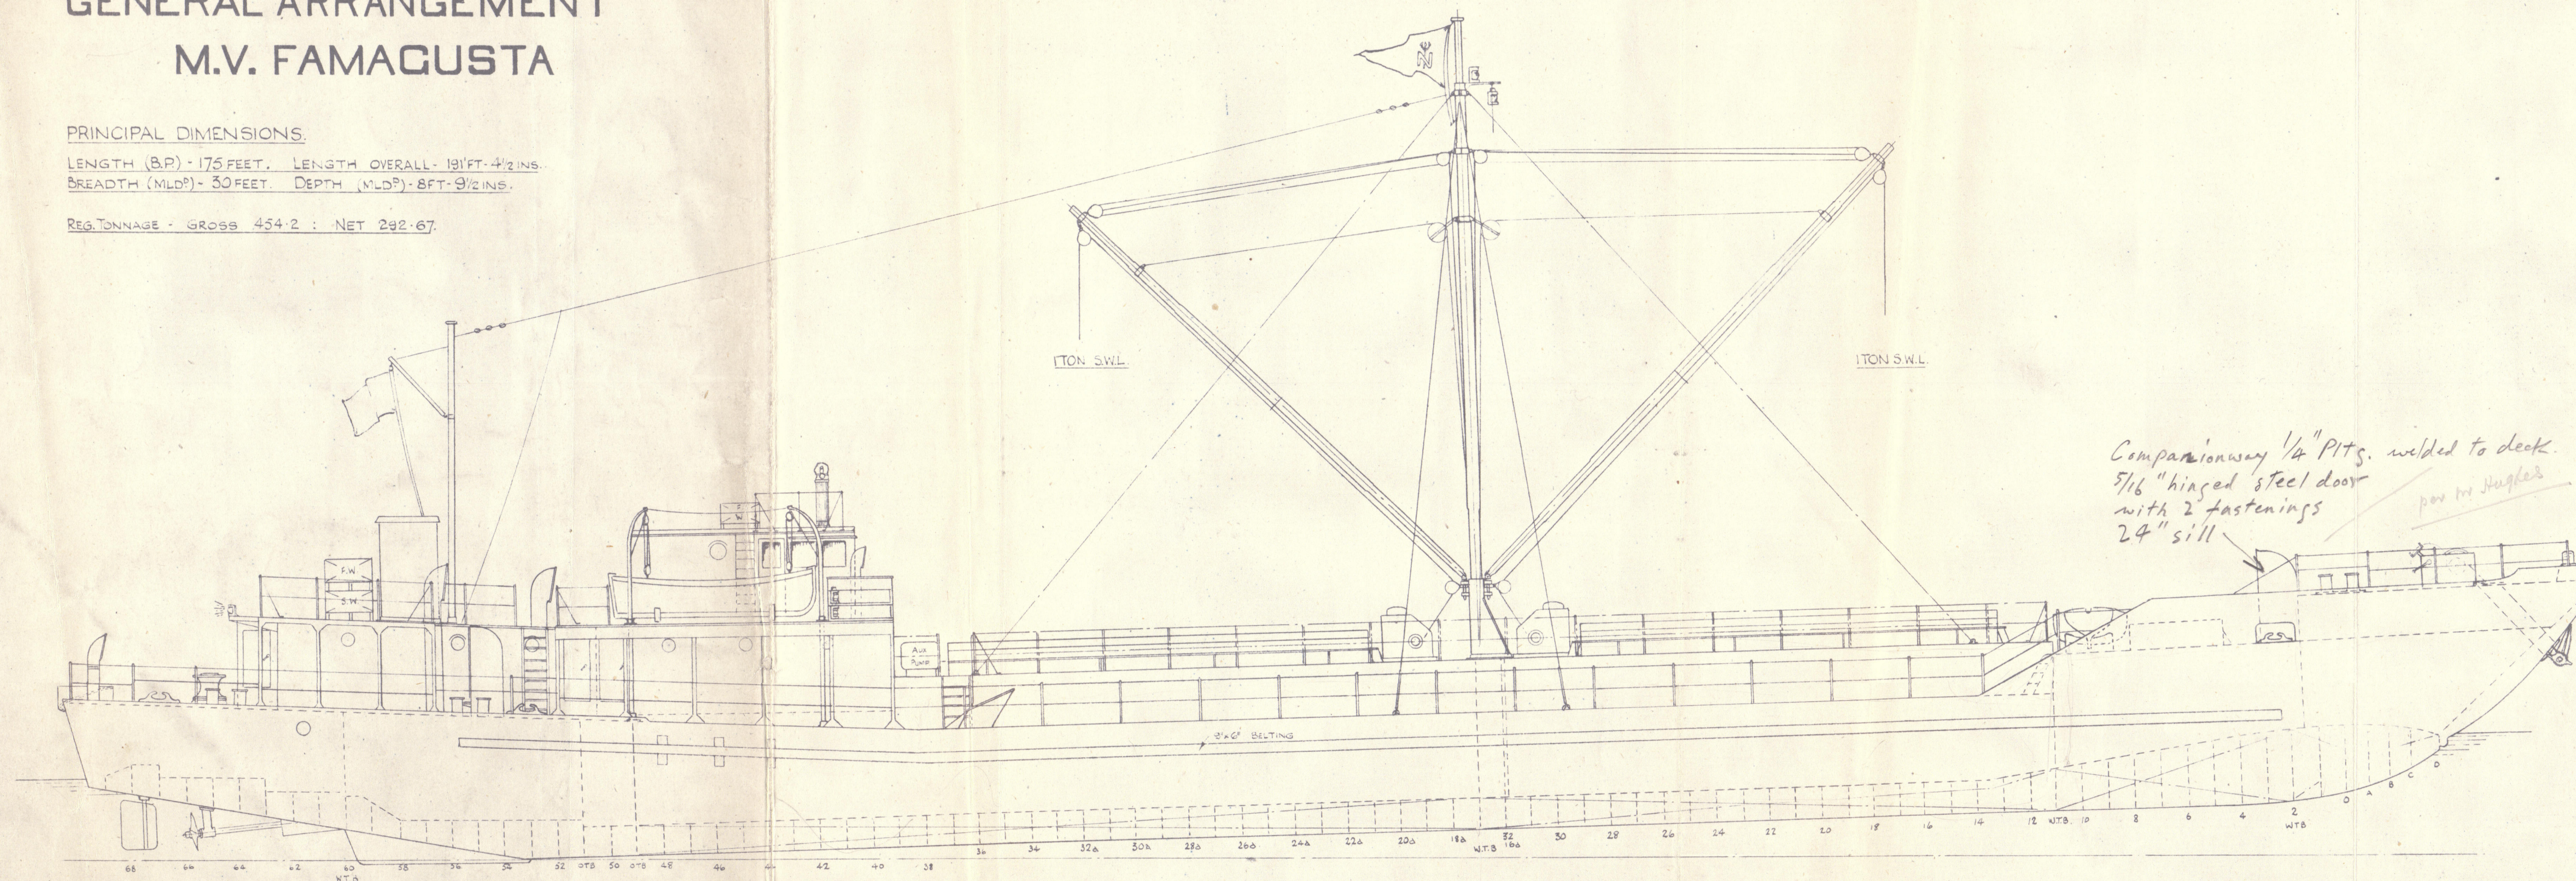

*Companionway 1/4\" Pits. welded to deck.  
5/16\" hinged steel door  
with 2 fastenings  
2 1/2\" sill*

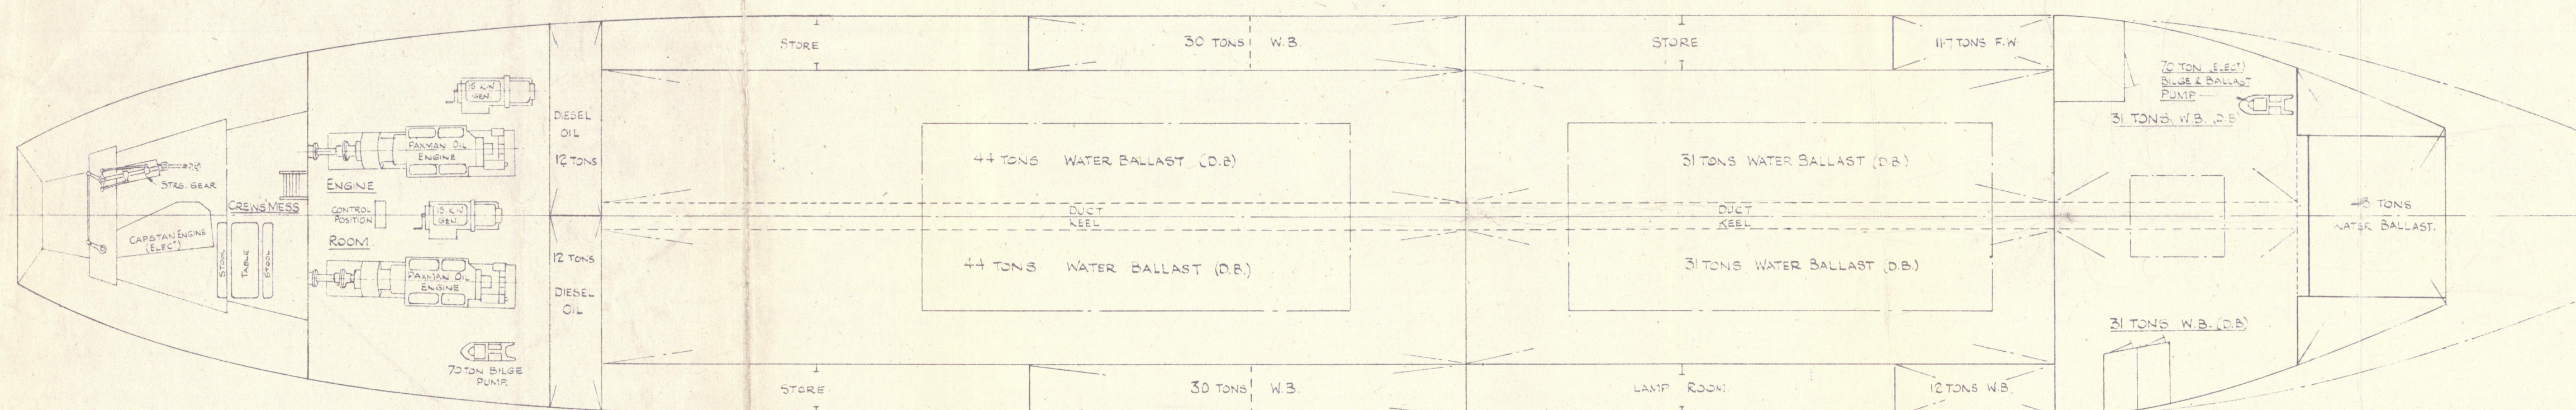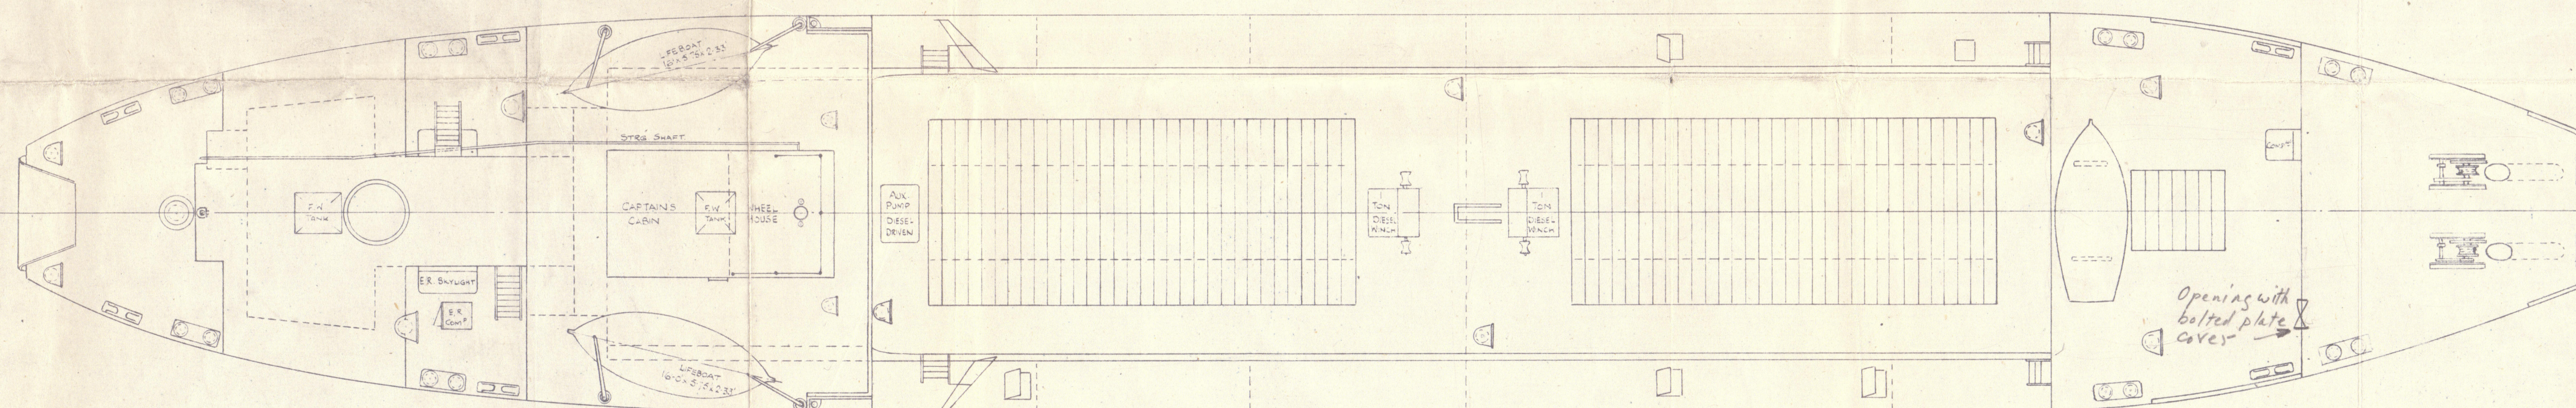

## OWNERS

THE NEPTUNE SHIPPING & TRADING  
COMPANY LIMITED,  
FAMAGUSTA, CYPRUS

CYRIL V. HUGHES, NAVAL ARCHITECT.  
53, WOODSIDE AVENUE,  
ESHER, SURREY,  
ENGLAND.