

TWIN SCREW STEAMER "FIELDMARSHAL."

PRINCIPAL DIMENSIONS


LENGTH B.P.P.	417'-0"
BREADTH MOULDED	50'-0"
DEPTH MOULDED TO MAINDECK	31'-0"
HEIGHT OF LONG POOPDECK	8'-0"
HEIGHT OF FORECASTLEDECK	7'-6"
HEIGHT FROM TWEENDECK TO MAINDECK	8'-0"



LONGITUDINAL.

SCALE 1/8 IN. = 1 FOOT.

*Mr. Robinson
+ Albert Robinson*

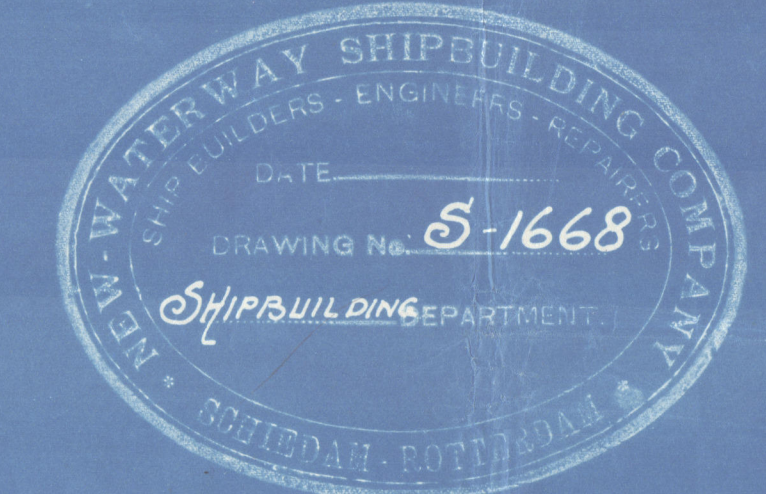

Runners under deck beams

*Strengthening at Rudder
and to the foremast satisfaction*

*Hatch 11'2" x 10'0"
FORE & AFTERS 9 1/2' x 6 1/2' AND 8' x 5 1/2'*

*Hatchway 40'2" x 14'0" 3'3" HIGH
FORE & AFTERS 9 1/2' x 6 1/2' AND 8' x 5 1/2'*

FOR GIRDER AND PILLARS SEE MIDSHIP SECTION.

*Hull Point of the Oil Fuel to be above 150° Fahr
Section 49 of the Rules to be complied with*

*Strengthening of bottom forward and
hanging arrangements to the Surveyors
satisfaction*



18 Dec 1910



© 2020

Lloyd's Register
Foundation

W992-0229



n/n "Hong Kheng"

Rot. 12599

"Ling Ham"
Rot 12599.

T.S. "Field Marshall"
Profile Plan

New Waterway S.B. Co

RETAIN



© 2020

Lloyd's Register
Foundation