

Lloyd's Register of Shipping.

SURVEYS FOR FREEBOARD.-STEAM SHIPS.

25595

PARTICULARS RELATING TO ~~THE~~ STEAM SHIP ~~WHICH~~ ~~FLUSH DECKED, OR WITH~~ ~~TOP GALLANT FORECASTLE, SHORT POOP, AND BRIDGE HOUSE, DISCONNECTED, OR~~ ~~WITH TOP GALLANT FORECASTLES HAVING LONG POOPS, OR RAISED QUARTER DECKS~~ ~~CONNECTED WITH BRIDGE HOUSES, OR OTHERWISE.~~

Port of Survey *San Francisco*Date of Survey *While building*Name of Surveyor *S. A. Bennett**P. Mc. Gresh*

Particulars of Classification.

100 A-1. Carrying Petroleum in bulk
(Class contemplated)

Ship's Name.

Herbert L. Pratt
Iron Works Co's No 144
Number in Register Book

Port of Registry and Nationality.

Philadelphia
Pa.

Official Number.

Gross Tonnage.

Date of Build.

*L**1917-18*

Registered dimensions from Ship's Register.

LENGTH.	BREADTH.	DEPTH.	UNDER DECK TONNAGE.
<i>435.0</i>	<i>56.0</i>	<i>31.58</i>	<i>6350</i>

Length on LOADLINE.

Frame Depth Rule	Ceiling Sheer	Peak Tanks
<i>56.0</i>	<i>+35</i>	<i>✓</i>

Tonnage calculated by builders to a 35" floor + 65" frame, allowing for ceiling + sparring

CORRECTED DIMENSIONS.

LENGTH.	BREADTH.	DEPTH.
<i>435.0</i>	<i>56.0</i>	<i>31.93</i>

Co-efficient of fineness..... *.8162*

Any modification necessary { [Para. 4 (a) to (e)]* }

Co-efficient as corrected *.81*

Sheer { Stem..... *88* } *133 ÷ 2 = 66.5* ...Mean
at { Sternpost... *45* }

Sheer at $\frac{1}{2}$ of the length from { Stem *49* } *73 ÷ 2 = 36.5* ...Mean
Sternpost *24* } *55-66.36*

Gradual mean Sheer *66.36* ✓Standard mean Sheer [Table, Para. 18] *53.50* ✓ CorrectionDifference..... *12.86 ÷ 4 = 3.21* ✓§ If limited as Para. 18 (f)..... *-3 1/4"* x

Rise in Sheer { At front of bridge house..... *L*
from amidships { At after end of forecastle *L*
[Para. 18 (e)]

Fall in Sheer { Para. 18 (d) } *L ÷ 2 =*

Length uncovered Correction

ALLOWANCE FOR DECK ERECTIONS:—

Freeboard, Table C..... *5-11* ✓Correction for Length, if required (Para. 12, 13, and 14) *+ 2 3/4* ✓*6-1 3/4* ✓Freeboard by Table A, corrected for sheer, and for length, if required (Para. 12, 13, and 14) } *9-4 3/4* ✓Difference *3'-3"* x

Percentage as below.....

*30.95**32.95* ✓*12.07**-12.85* x

Correction for R. Q. Dk. if engine and boiler openings not covered by bridge house (Para. 11)

Allowance for Deck Erections *-12 0 3/4* x

	Length.	Length allowed.	Height.
Forecastle.....	<i>42.0</i>	<i>42.0</i> ✓	<i>7.9"</i>
Bridge House.....	<i>38.0 + 10.75 + 1.25</i>	<i>46.68</i> ✓	
+ Raised Qr. Dk.....			
Poop.....	<i>134.0</i>	<i>134.00</i> ✓	
Total.....		<i>222.68</i> x	
Length of Ship.....		<i>435.00</i>	

Corresponding percentage { (Para. N, 12, N, or N) } *32.95* ✓

FREEBOARD recommended amidships from centre of Disc to top of Statutory Deck Line, Wood (Iron) Deck:—

Fresh Water Line above centre of Disc ... *6 1/2"*Indian Summer Line " " " " " " " " *6*Winter Line below " " " " " " " " *6*Winter North Atlantic Line " " " " " " " " *6*

If the frames, skin planking, or ceiling are of unusual thickness the breadth of vessel to inside of ceiling should be reported if possible.

In vessels obtaining an allowance for deck erections under Para. 11 where the sheer drops abaft amidships the height of the R.Q.D. is to be taken from the level of the top of the amidship beam.

In flush-decked vessels the total standard mean sheer means the sheer measured at the stem and stern.

In vessels having poops and forecastles, it means the sheer measured at the stem and stern.

Moulded Depth as measured..... *33' 6"* ✓Addition for Keel below base line for draught record..... *2.36* inches.

CORRECTION FOR LENGTH.

Length of Ship on Loadline..... *435.0*Length in Table *402.0* ✓Difference *33.0* ✓Correction for 10ft., Table A. *1.7* Table C.× Difference divided by 10 *+ 5 1/2* (if required.) *+ 2 3/4* ✓If $\frac{1}{10}$ ths length covered divide by 2

CORRECTION FOR IRON DECK.


Proportion covered, if less than $\frac{1}{10}$ ths length covered *.5119*Thickness of usual wood deck, less stringer *-1 1/4"* ✓

CORRECTION FOR ROUND OF BEAM.

Breadth at Gunwale amidships..... *55.0*Round of Beam *12"*Normal round..... *13 3/4"* ✓Difference *÷ 2 = 1.75* ✓Proportion of Deck uncovered (Para. 19) *.488* ✓Freeboard, Table A *9' 2 1/2"* ✓Correction for Sheer *- 3 1/4"* ✓Correction for Length *+ 5 1/2"* ✓Allowance for Deck Erections *- 1-0 3/4"* ✓Correction for Round of Beam..... *+ 1/2"* ✓Correction for fall in Sheer (if any)..... *8'-4 1/2"* ✓Correction for Iron Deck (if required) *- 1 3/4"* ✓Additions for non-compliance with provisions of { Para. 11 (d) and (e) } *8-2 3/4"* ✓Other Corrections (if any) *L*Winter Freeboard *8'-2 3/4"* ✓Summer Freeboard *7'-8 3/4"* ✓Indian Summer Freeboard *7'-2 3/4"* ✓N. A. Winter Freeboard *L*Correction necessary because clearside amidships, measured in accordance with the Statute is not taken at the intersection of the wood or iron deck with side. *+ 1 3/4"* ✓Winter Freeboard from deck line *8'-4 1/2"* ✓Summer " " " " " " " " *7'-10 1/2"* ✓Indian Summer " " " " " " " " *7'-4 1/2"* ✓N. A. Winter " " " " " " " " *L*Winter Freeboard from deck line *8'-4 1/2"* ✓Summer " " " " " " " " *7'-10 1/2"* ✓Indian Summer " " " " " " " " *7'-4 1/2"* ✓N. A. Winter " " " " " " " " *L*

† State dimensions of freeing port area on back of this form.

‡ The Surveyor should state whether the fall in sheer as reported is measured relatively to the straight line of keel or to the water line. If measured relatively to water line the vessel's draft at this survey, and also the usual load draft forward and aft should be reported.

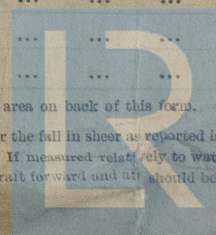

© 2020

Lloyd's Register Foundation

Do all the Frames extend to the top height in the Poop?
To what height do the Reverse Frames extend?

Raised Quarter Deck?

Bridge House?

Forecastle?

Has the Poop or Raised Quarter Deck an efficient Iron Bulkhead at the fore end?

Give particulars of the means for closing the openings in Bulkhead

Is the Poop or Raised Quarter Deck connected with the Bridge House?

Give particulars of the means for closing the openings in Bulkhead

What is the thickness of the Bridge Front plating?

Give scantlings and spacing of the Stiffeners

Are bracket plates fitted at each end of the Stiffeners?

Has the Bridge House an efficient Iron Bulkhead at the after end?

How are the openings closed?

Is the Forecastle at least as high as the main or top-gallant rail?

Are the Engine and Boiler openings covered by a Bridge, Poop, Raised Quarter Deck or enclosed by a Strong Iron or Steel Deckhouse?

If the openings are not so protected are the exposed parts of the Casings efficiently constructed?

Give thickness of plating; scantlings and spacing of Stiffeners

What is the height of the exposed Casings?

Are suitable means provided for closing all openings in them in bad weather?

Are the Weather Deck Hatchways efficiently constructed and at least equal to the requirements of Section 28 of the Rules for 1904-5? Give particulars below:—

Position and Size.		N ^o 1. 10'0" x 10'0"									
Item.		Ship.	Rule.	Ship.	Rule.	Ship.	Rule.	Ship.	Rule.	Ship.	Rule.
COAMING	Height above top of DECK	24"		18 Oil hatchways 6'0" x 4'0"							
	Thickness { Sides.....	44		10 " " 4'0" x 2'6"							
	Ends.....	44									
WEATHER DECK WEB PLATES	Number	One		Coamings 8' x 3 1/2' x 1/2" angles							
	Section and Scantlings	Plate 30		with covers efficiently stiffened							
	Material	3' x 3' x 40									
FORE AND AFTERS	Number										
	Section and Scantlings										
	Material										
HATCHES Thickness		3"									
Remarks.....		Solid									

* The depth of Fore and Afters should be stated from the underside of the hatches in all cases.

(If the sill of the lowest side scuttle will be less than 6 inches above the Indian Summer Load Line if assigned under the tables, state vertical distance from top of deck at side amidships to lower edge of lowest side scuttle.)

The following information is to be given in all Cases of vessels dealt with under Paras. 11, 12 (under 15 feet Moulded depth) and under Shelter Deck Rules.

What is the thickness of the Bridge Sheerstrake?

Strake between Main and Bridge Sheerstrakes?

Delete the words { The Crew are, are not, berthed in the bridge house.

that do not apply { The arrangements to enable them to get backwards and forwards from their quarters are, are not satisfactory.

Length of Bulwarks in well

Area of Freeing Ports required by Para. 11 (e) each side of vessel =

Sq. ft.


Ft. Tenths. Ft. Tenths. No.

Freeing Ports (each side of vessel) =

Sq. ft.

Total deficiency or excess =

Sq. ft.

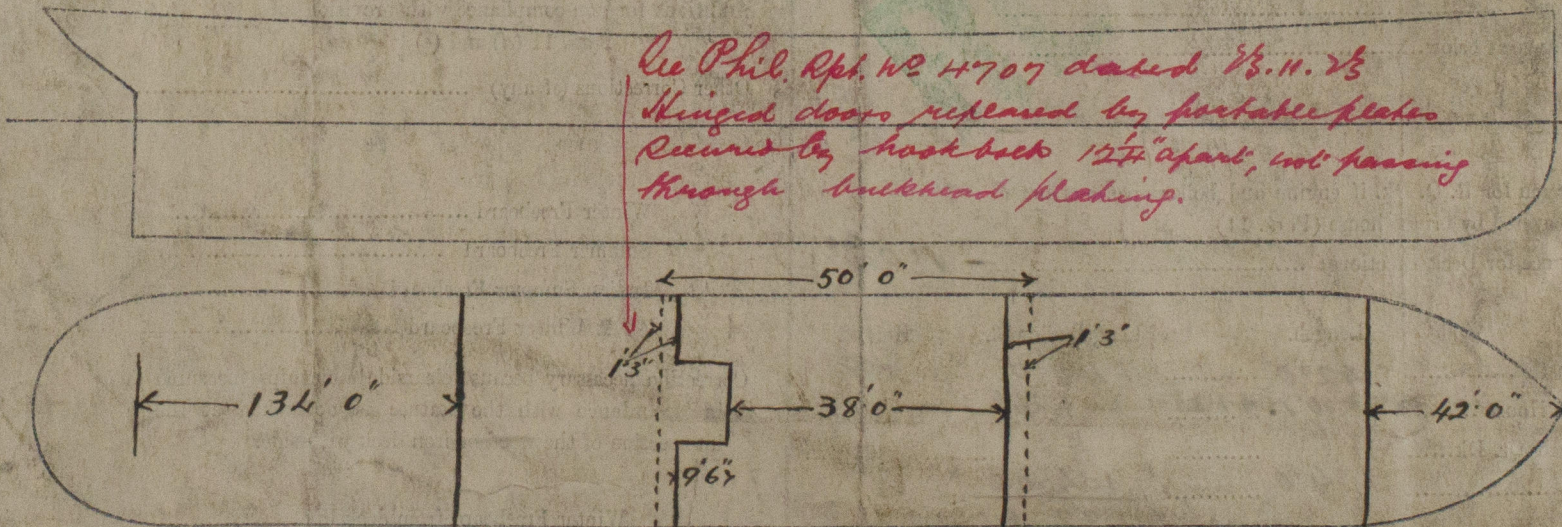

Show hereon line of Floors or Tank Top with position of any Breaks in same; also height of Peak Tank tops, &c., &c.

State any special features in the construction of the Vessel

Sister vessel to S/S J. E. O'Neil, see

S. Y. Rpt. N^o 2573.

In order to get the free board marked before the vessel leaves this Owners port, it will be necessary to have the particulars cable

Address

Recd.

received by me



Lloyd's Register Foundation