

MANHOLE 13x16 1/2

PLATE 1/32 THICK RIVETS 1/32 DIA




DOOR & SPIGOT 1/8 THICK

TO BE FITTED TO MESSRS PICKERSGILLS S.S. N° 206.

TO PASS LLOYD'S SURVEY FOR A WORKING PRESSURE OF 180 LBS PER IN²

TO BE TESTED IN THE PRESENCE OF LLOYD'S & OWNERS SURVEYORS.

TENSILE OF SHELL PLATES.	28.0 TO 32.0 TONS.
FLANGE & GIRDERS.	26.0 - 30.0 -
FURNACES	26.0 - 28.0 -
MAIN STAYS	28.0 - 32.0 -
SCREW	26.0 - 30.0 -
RIVET BARS	26.0 - 30.0 -

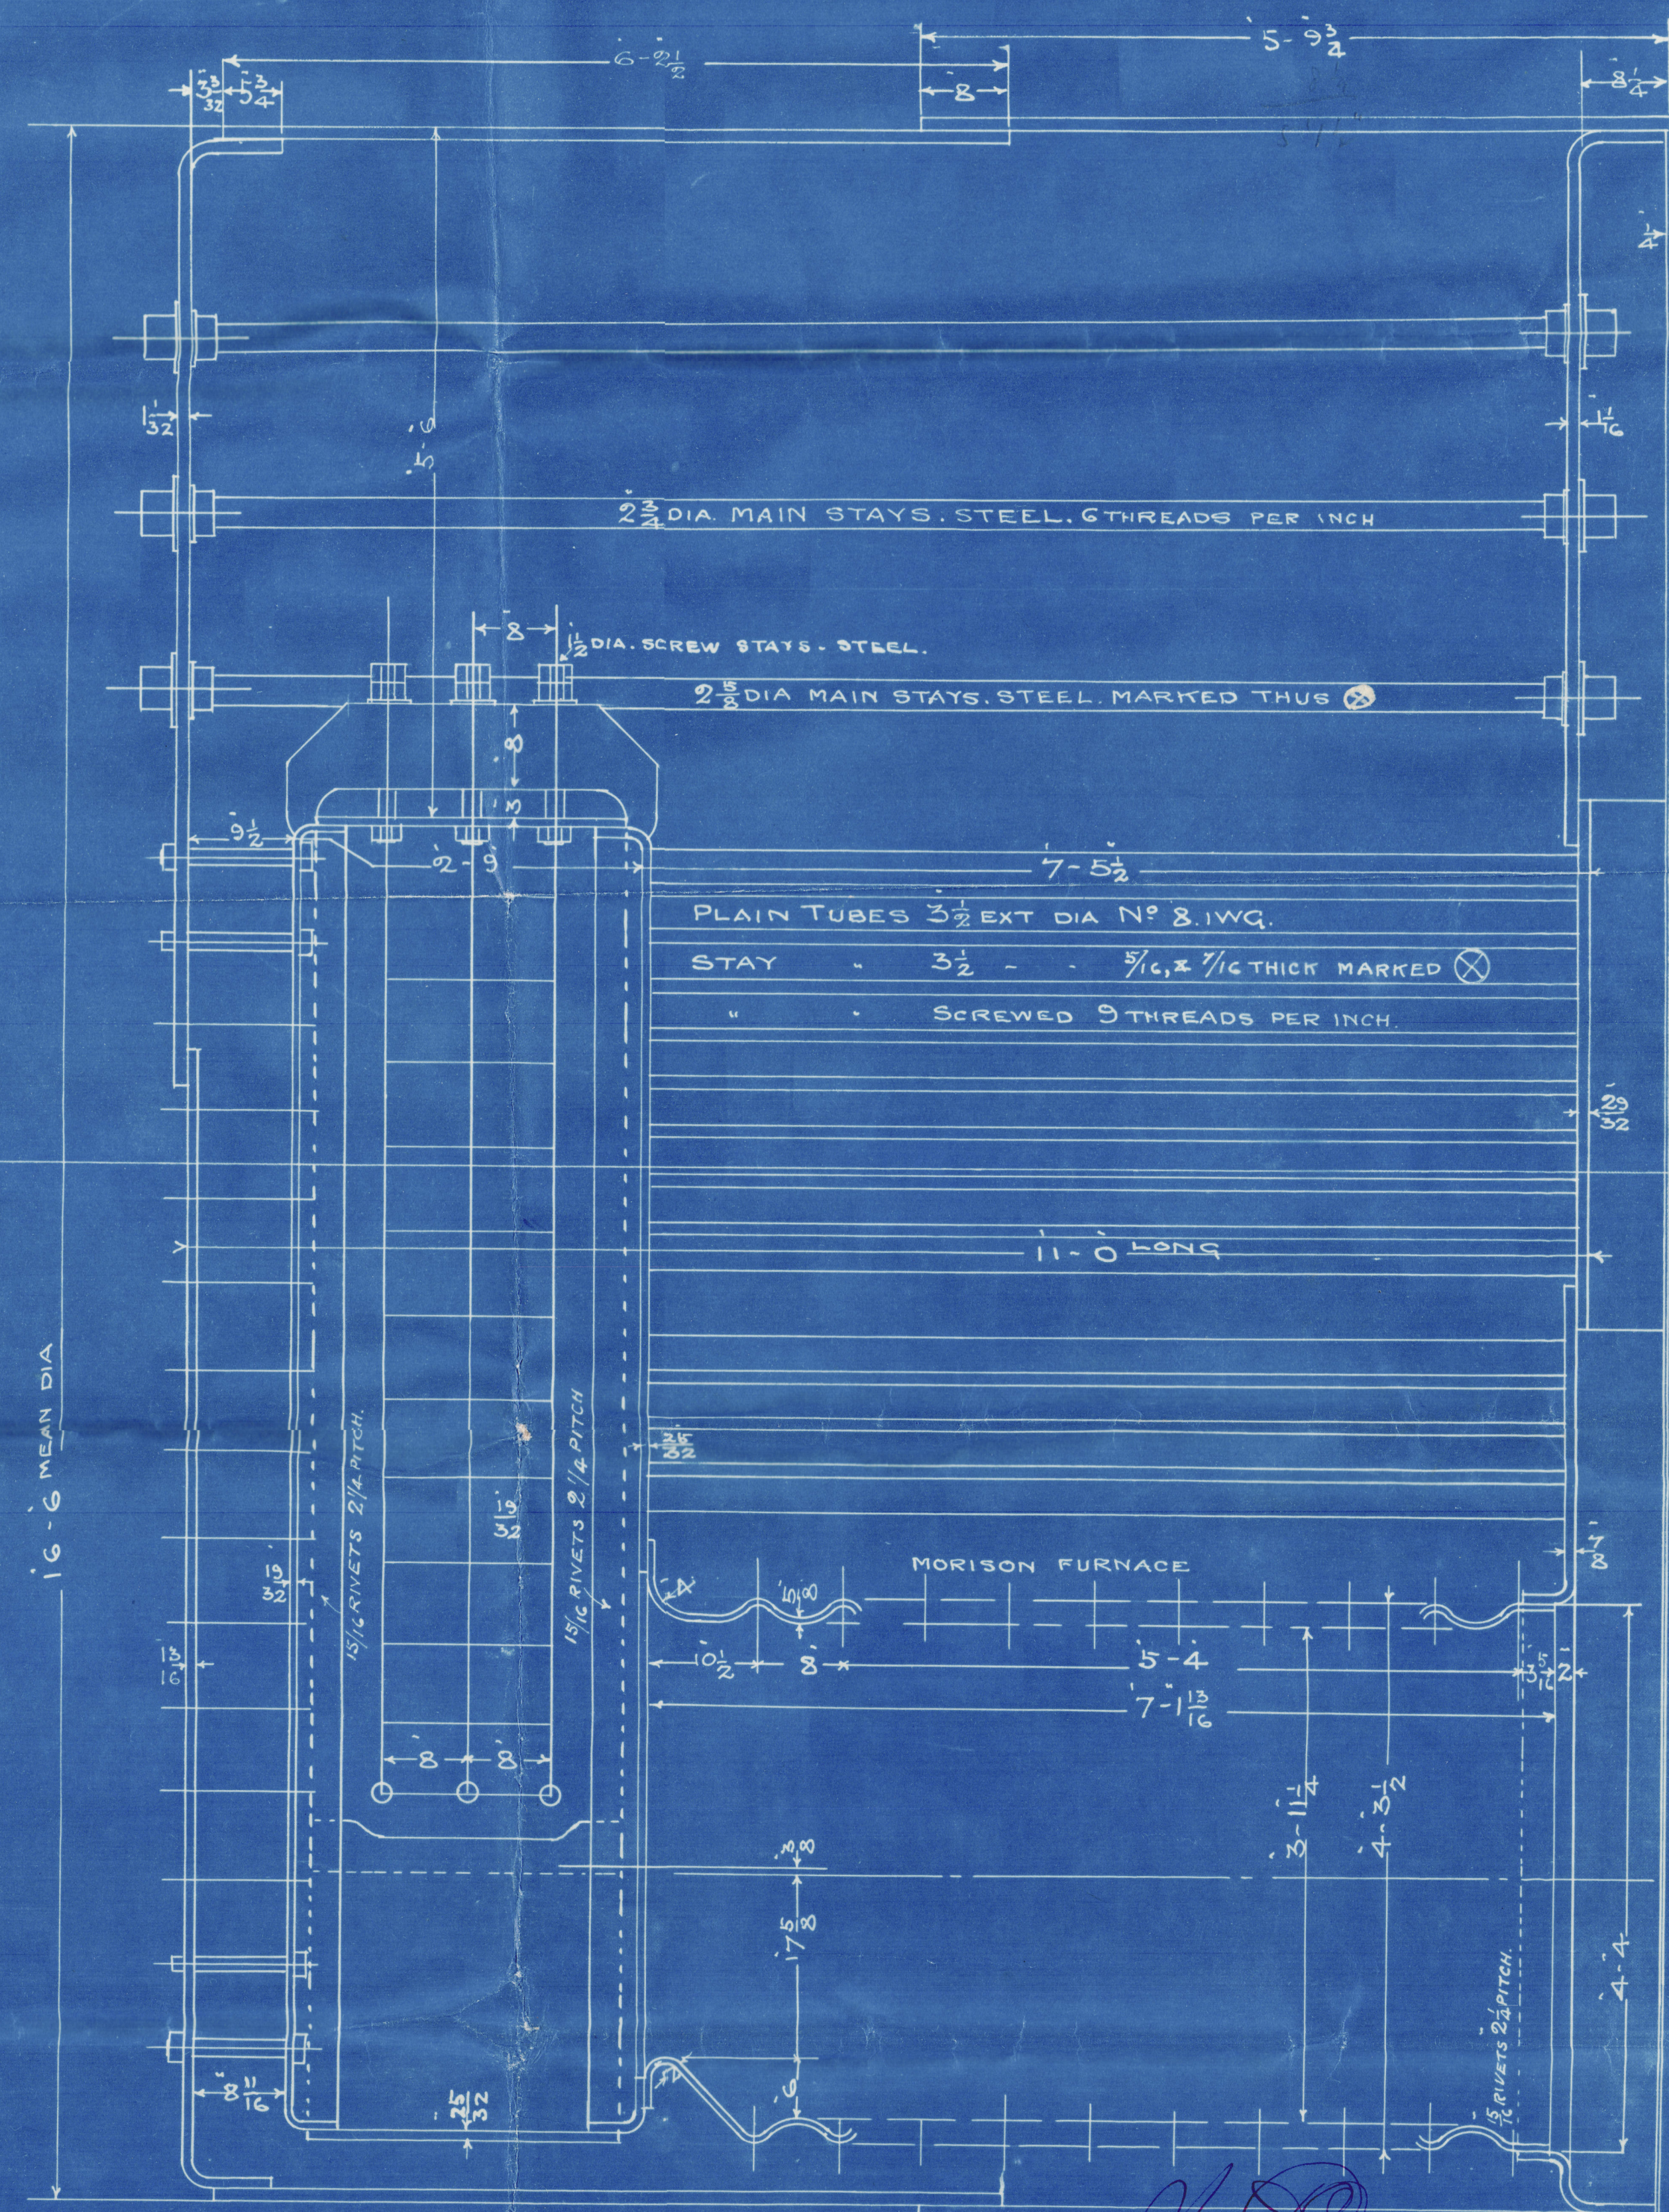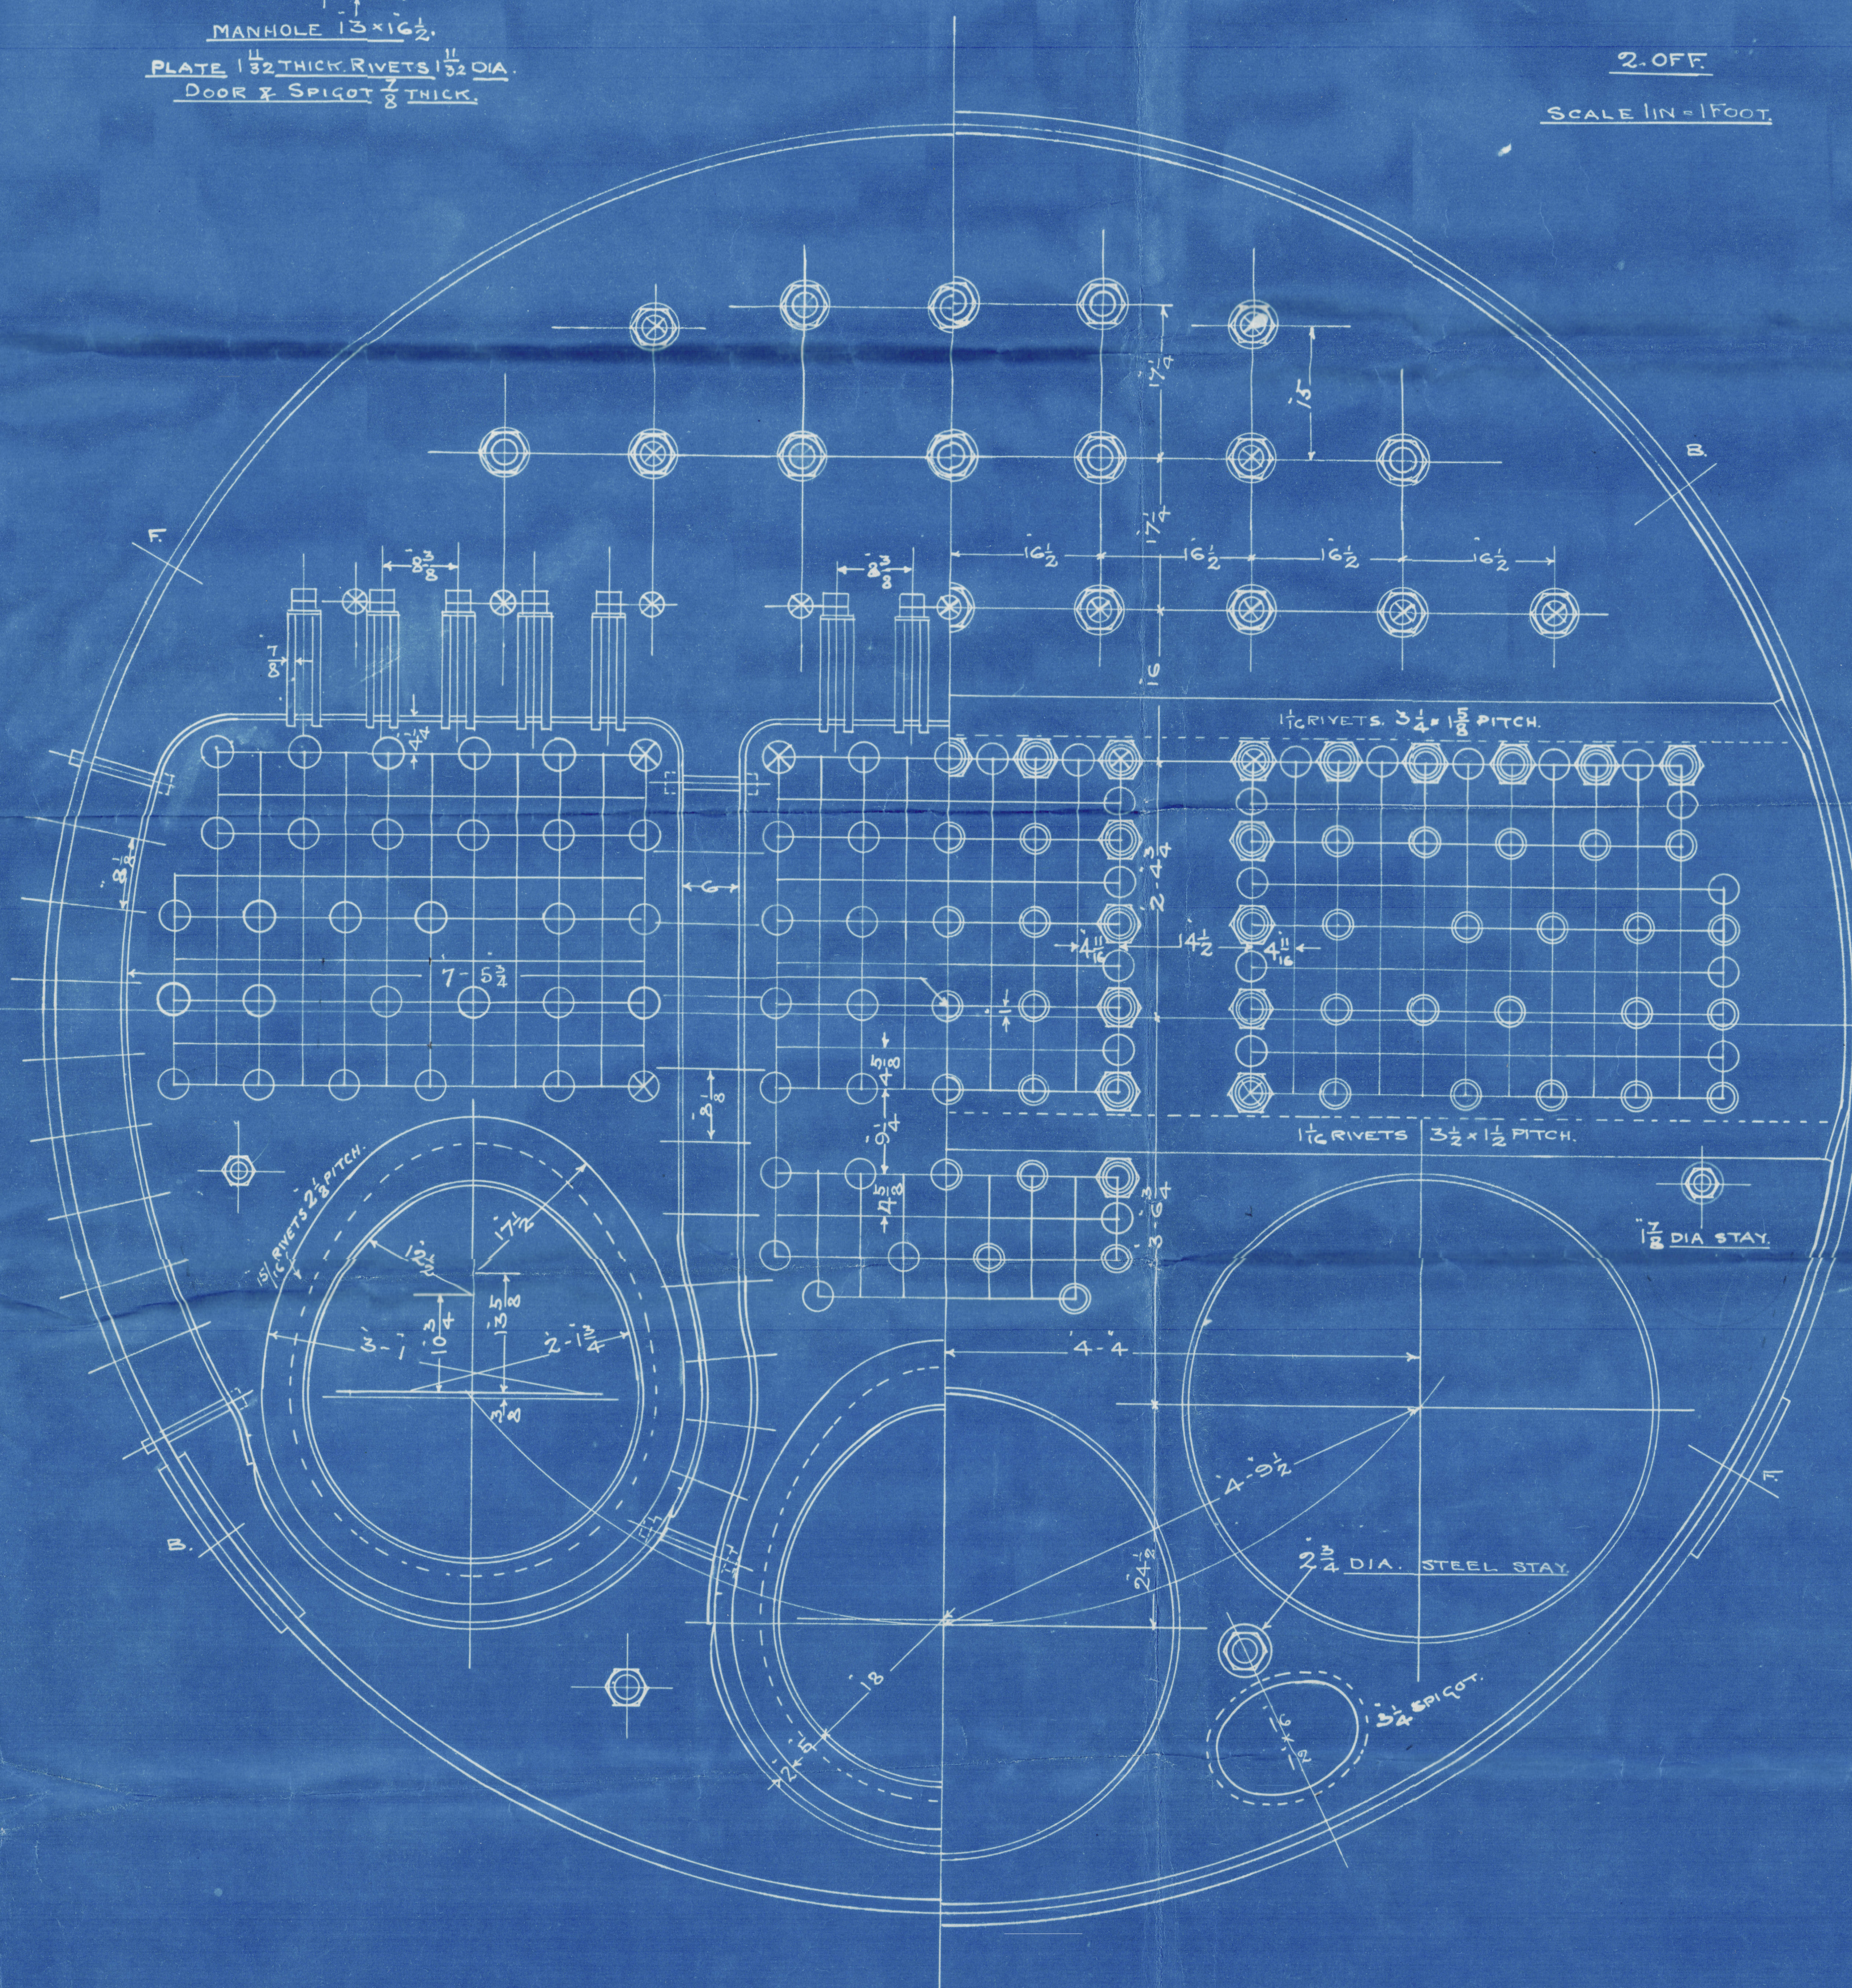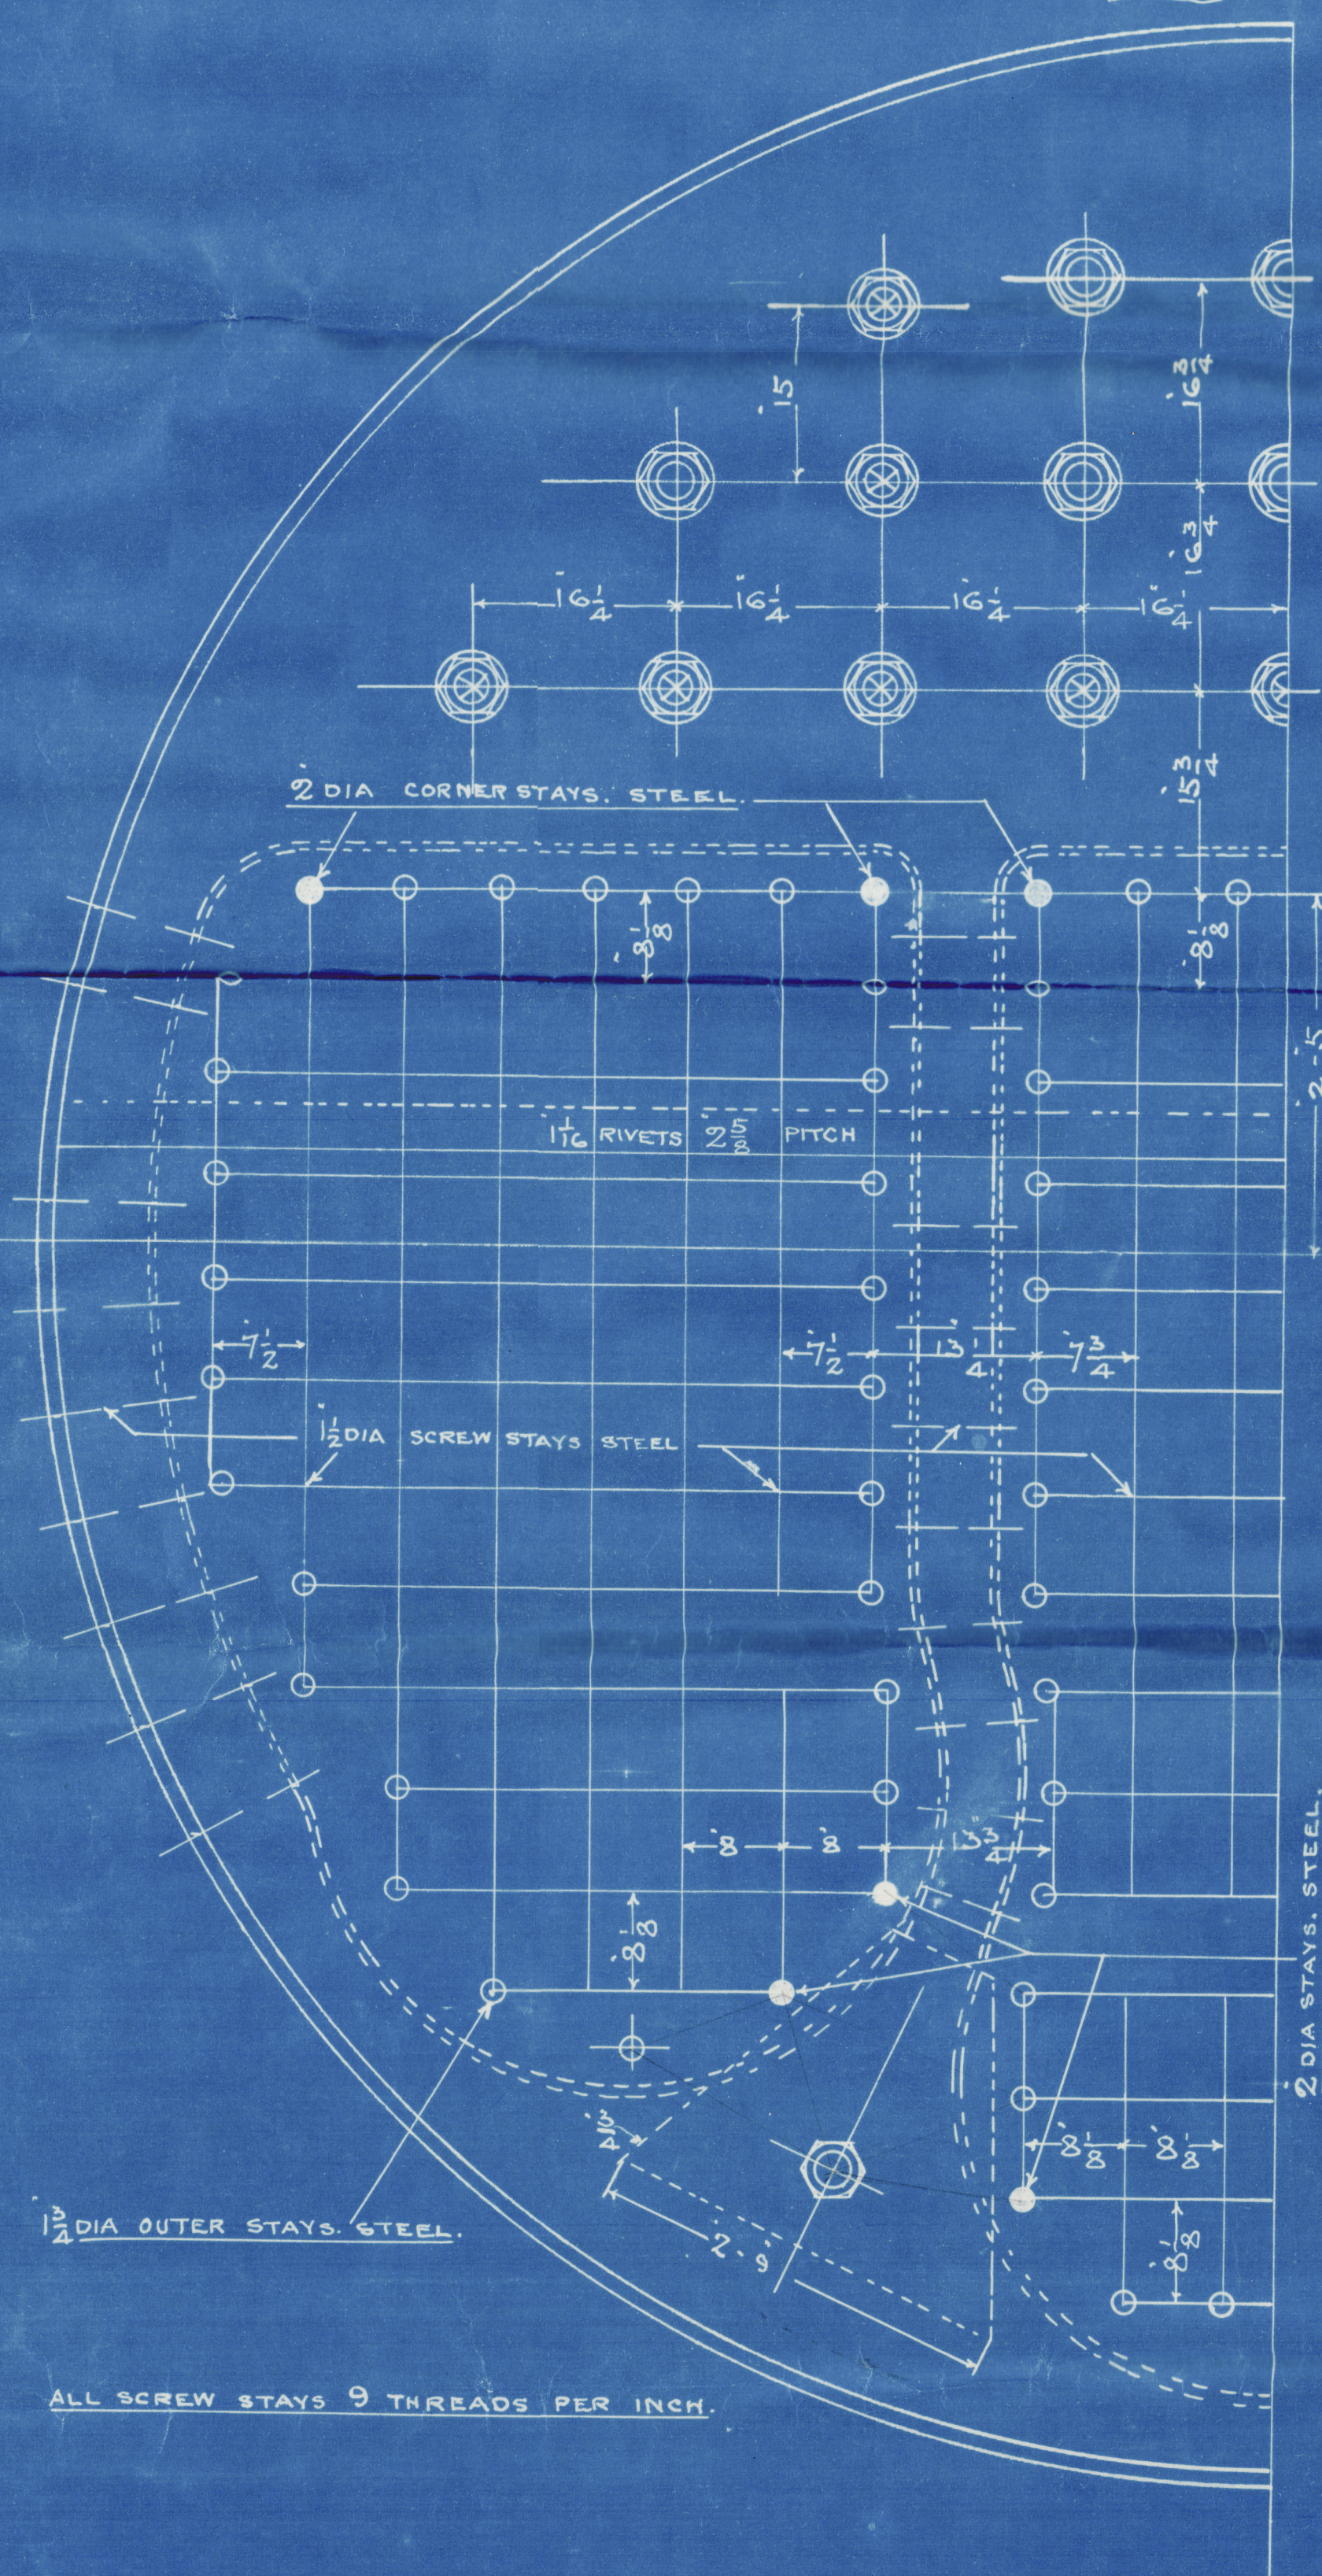

BOILERS N° 2640



MAIN BOILERS

^{INTER} RICHARDSONS

WESTGARTH & Co

Nº 2640.

WM PICKERSGILL
& SONS

S.S. Nº 206.

Nº 3629
LLOYD'S TEST
320 LBS
V.V.P. 180 LBS
25.9.23 RDS

s/s ⁷ KILDALE ⁶⁰

Sed 28788.

RETAIN



© 2020

Lloyd's Register
Foundation

L99938-0119