


22 No 280

17.10.13
 15.10.14 (604/5 - 619/20)
 4.11.14 (626-7-8)
 6.2.15 (629-640)
 8.3.16 (656-7; 660-1 + 664-671)

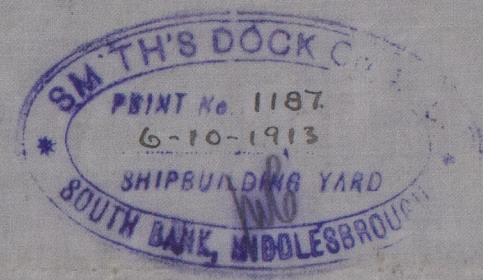


MIDSHIP SECTION
 OF A
 STEEL SCREW TRAWLER
 DIMS 125' O.B.P. x 23'6" E.T. x 13'6" M.L.D.
 TO CLASS 100A.1. STEAM TRAWLER
 1/2" SCALE

NUMERALS
 B = 23'33" + D = 13'5"
 TRANSVERSE HP = 36'83"
 LENGTH = 125'0" =
 LONGth = 46'03'75"
 d = 12'17"
 b = 9'26"

EQUIPMENT
 1 ANCHOR 5 3/4 CWT EX STOCK OR 7 1/2 CWT STOCKLESS
 1 " 5 1/4 " " " 6 1/2 " "
 1 " 3 " " " " " "
 105 FATHOMS 1 1/2" STUD LINK CHAIN
 50 " 6" HAWSER OR 2 1/2" STEEL WIRE } *Steel wire with owner's consent*
 50 " 5" " " 1 3/4" " " }

RIVETING
 KEEL & LOWER EDGE OF GARBOARD TO HAVE 1" RIVETS
 ALL SHELL SEAMS & BUTTS, & C* KEELSON TO HAVE 3/4" RIVETS, REMAINDER OF WORK TO HAVE 9/8" RIVETS
 SHELL SEAMS TO HAVE 10 RIVETS BETWEEN FRAMES, IN EACH FRAME SPACE, EXCLUSIVE OF RIVETS IN FRAMES
 TWO RIVETS IN LANDING EDGES AT EACH FRAME

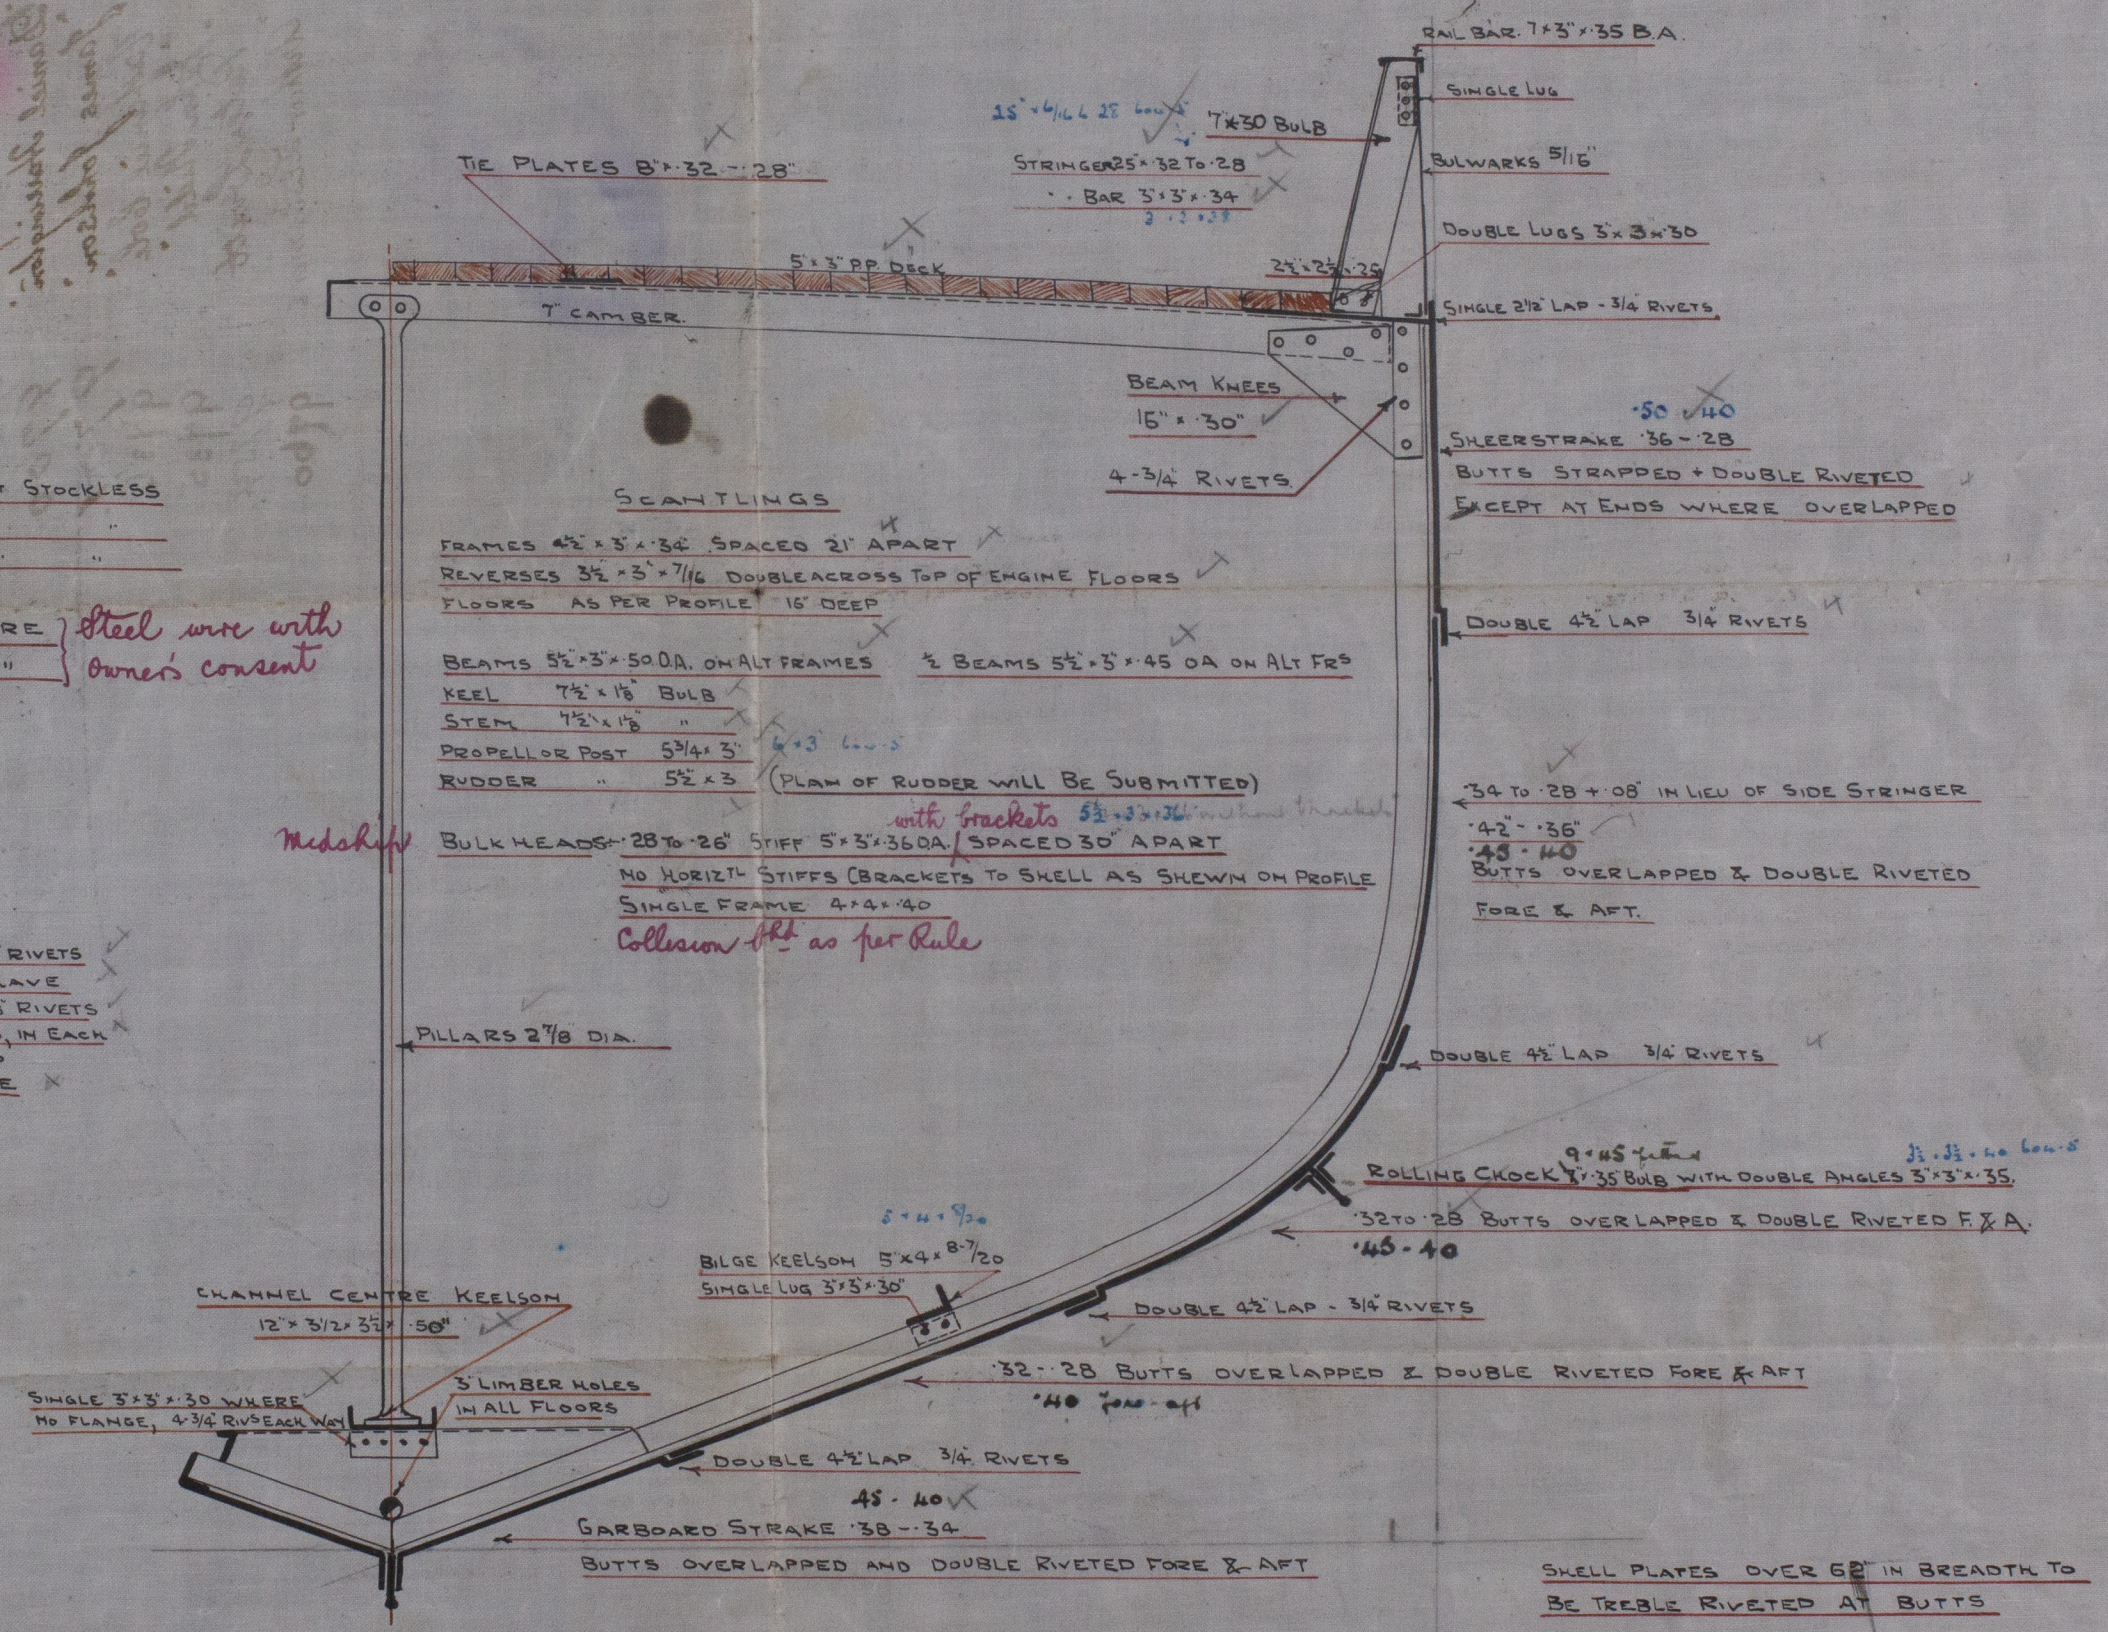

SMITHS DOCK COY LTD
 SHIPBUILDERS & ENGINEERS
 SOUTH BANK ON TEES

bbf
 5.2.15.
JW.
 17.10.13

-N° 576-

W.S. 507

New Smith Dock Co. Ltd.

S.S. No 576

Midship Sealine
(amended) 629-640

* Kilgerran Castle

S.S. City of Dundee

Mat. Rpt. no 8467.

607 s/s. David Math. Rpt No 8208

608 s/s. Mikasa Math Rpt No 8209

619 s/s. Isolde Mat 8099

620 s/s. Lena Mellins 9143

626 s/s. Raylan Castle Mat 9162

627 s/s. Hebe. Carter Mat. 9168

628 s/s. Harfat Castle " 9182

629 s/s. Conway Castle " 9281

630 s/s. Forecon Castle " 9288

631 s/s. Harlech Castle " 9306

632 s/s. Mursladi " 9309

633 s/s. Hegari " 9345

634 s/s. Burnley " 9346

635 s/s. Foss

636 s/s. Dhooon

637 s/s. Hirose

638 s/s. Miura

639 s/s. "

640 s/s. "

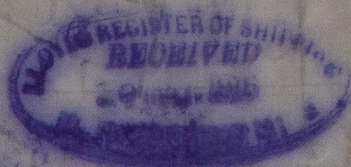

635	Mrs. Math Rpt	9356
636	Dhooon	9357
637	Hirose	9379
638	Miura	9380
639	Heath Castle	9560
640	Flint Castle	9561
656	RUTHIN CASTLE	9577
657	"POWIS CASTLE	9578
660	DUNRAVEN CASTLE	9592
661	Caswell	9599
664	Daniel Henley	9670
665	JAMES John Hummelford	9682
666	Daniel Harrington	9700
667	James Johnson	9701
668	Nathaniel Cole	9736
669	John Kidd	9735
670	Peter Lovett	9754
671	Arthur Lessimore	9760

