

# MIDSHIP SECTION.

Twin Screw Fishery Cruiser.

Mo. DIMENSIONS. 155' x 24' 6" x 13' 6"

SCALE  $\frac{1}{2}$ " = ONE FOOT.

CLASS A1. IRISH CHANNEL SERVICE.

SEE PROFILE AND DECK PLAN ALREADY SUBMITTED.

NUMERALS TAKEN AT LOWEST  
POINT OF STEER 15' 5" AFT  $\Phi$ .  
3 GIRTH 21.95  
2 BREADTH 12.25  
DEPTH 13.67  
1<sup>st</sup> No. 47.87  
L.L. 154  
2<sup>nd</sup> No. 73.42  
EJECTION 382.5  
Equip. No. 7462

17.12.07

27.12.07

NUMERALS  
1/2 GIRTH 22.20  
2/2 BREADTH 12.25  
1/2 DEPTH 13.67  
1/2 1<sup>st</sup> No. 47.87  
1/2 2<sup>nd</sup> No. 73.42  
1/2 EJECTION 382.5  
1/2 Equip. No. 7462

16.11.08

16.3.08

134

7462


382.5

7831.48

Tele 33x7x45 = 346

bridge 40x7.5 = 300

Equip. tel. = 8108

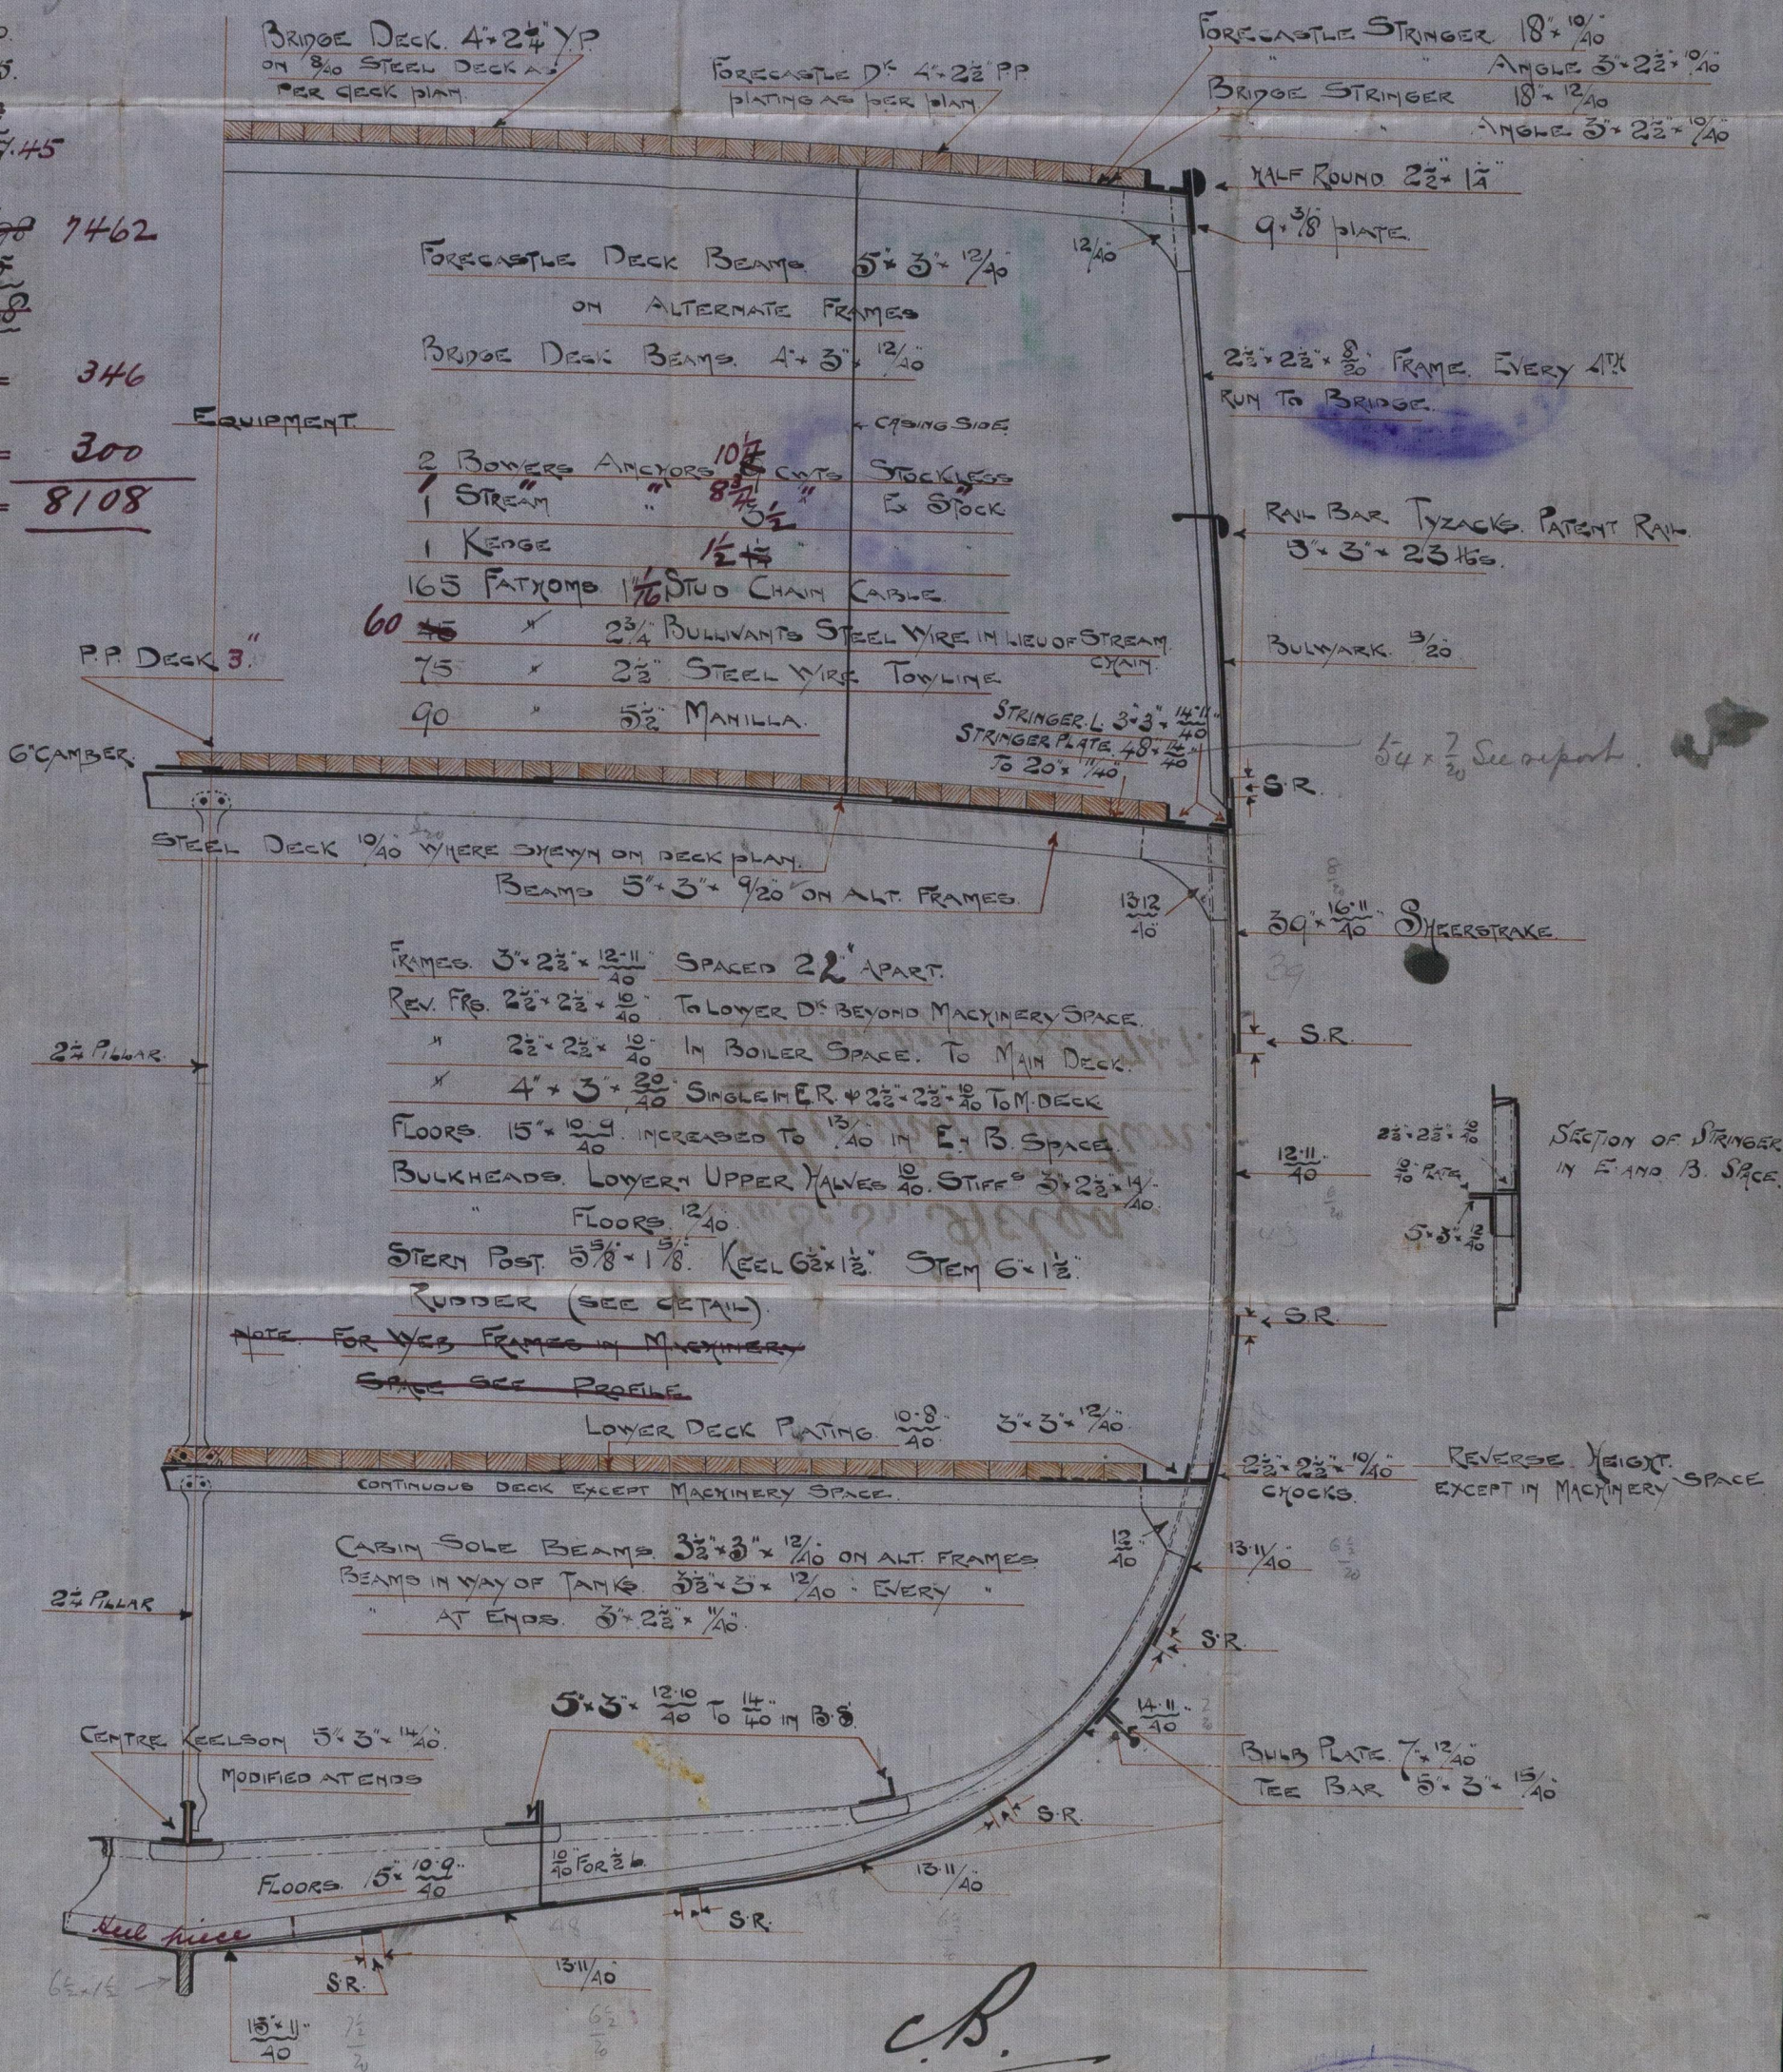

C.B.

17.12.07.



Tw. Sc. Sr. "Helga".  
Midship Section.

Dublin Report No. 2747.

Dublin 2747

W<sup>m</sup> "MUIRCHU".

W996-0032



© 2020

Lloyd's Register  
Foundation