


AMENDED PROFILE PLAN
T.S.S. No 62
SCALE 1/8" = ONE FOOT.

16.3.08

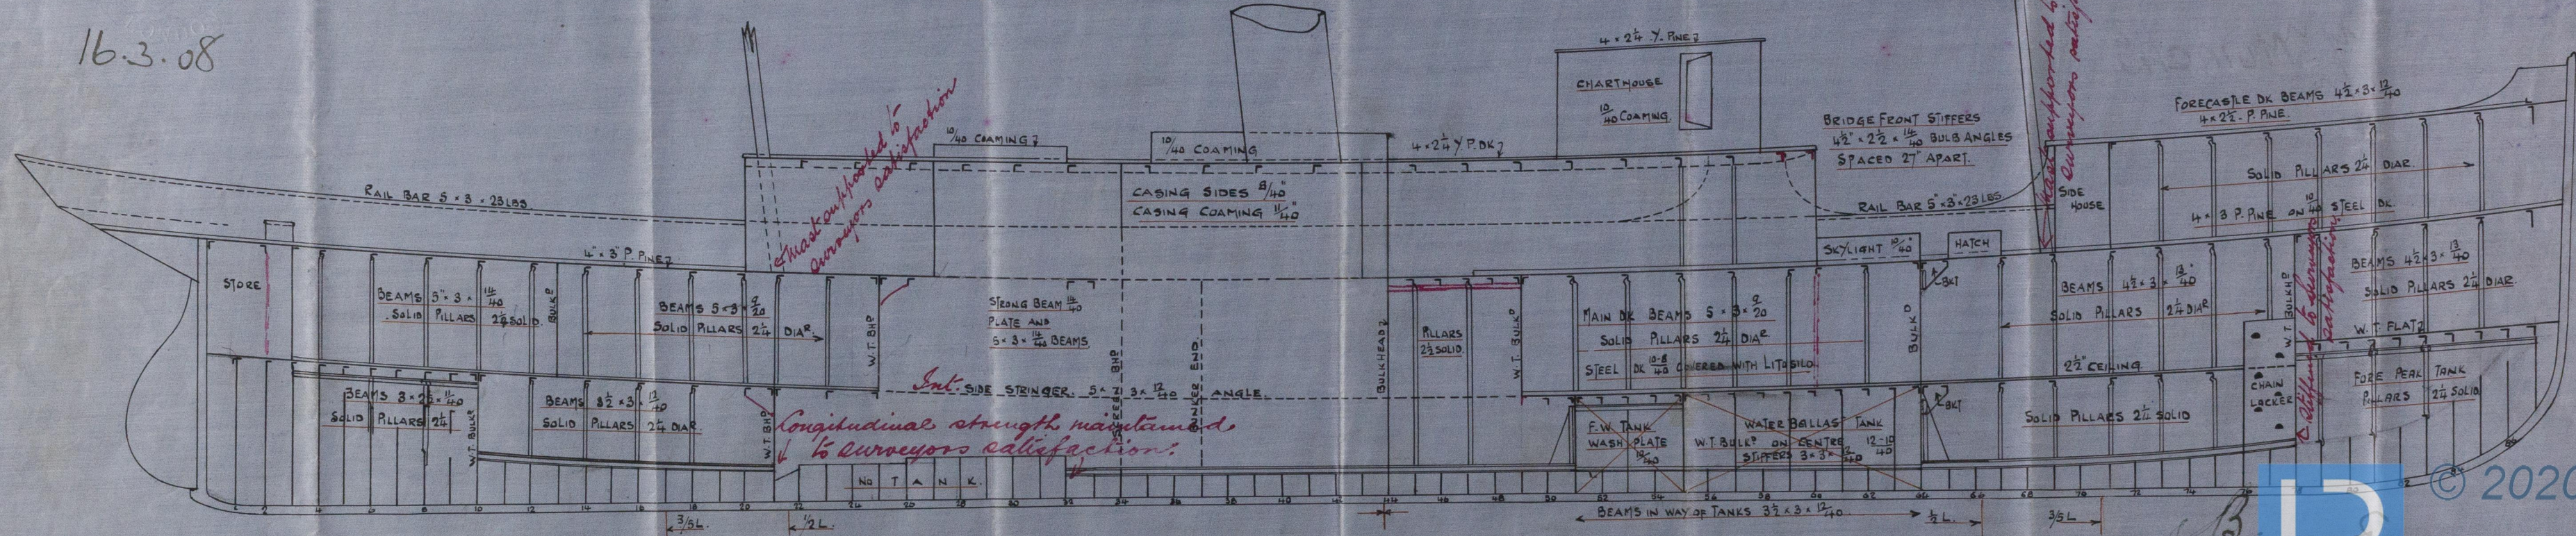

© 2020

Lloyd's Register
Foundation

W946-0033



T.S.S. "Helga".

Amended Profile.

Dublin Report

No. 2747.

Y^m MUIRCHÚ

W996 0033



© 2020

Lloyd's Register
Foundation