


17.5.11
19.5.11
13.7.11
2.8.11
14.8.11
1.12.11


No 870
PROFILE & DECK PLANS

TO CLASS 100A.1 AT LLOYDS
DIMENSIONS: 285'-0" PP x 43'-6" B.M.L.P x 22'-6" TO UPPER D^Y
SCALE 1" = 1'-0"


Pillaring throughout to Surveyor's satisfaction.

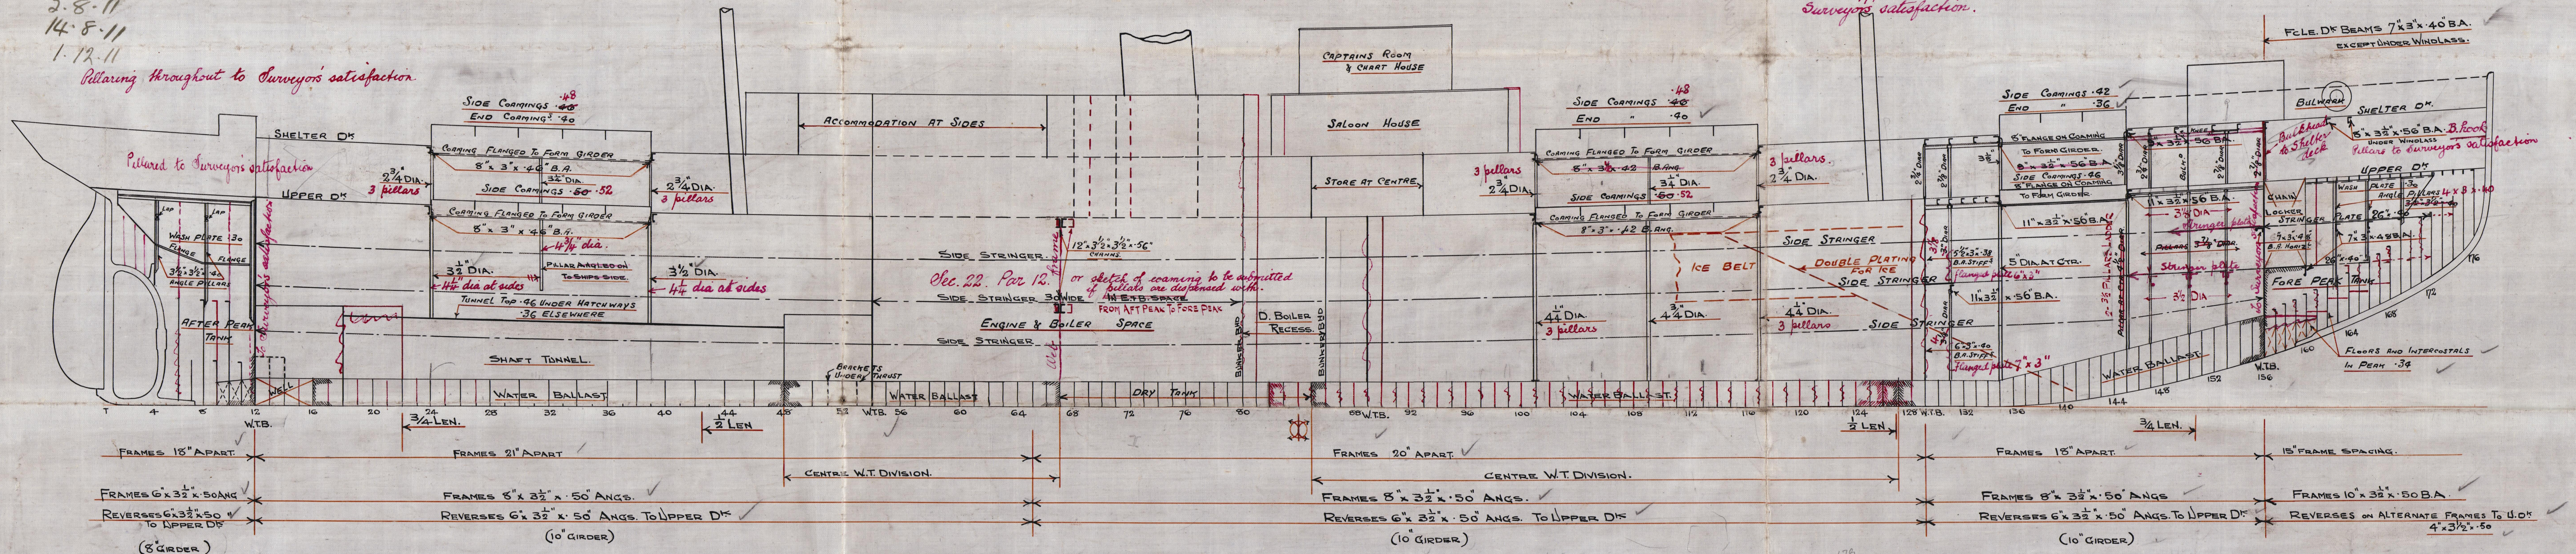

SHELTER DECK

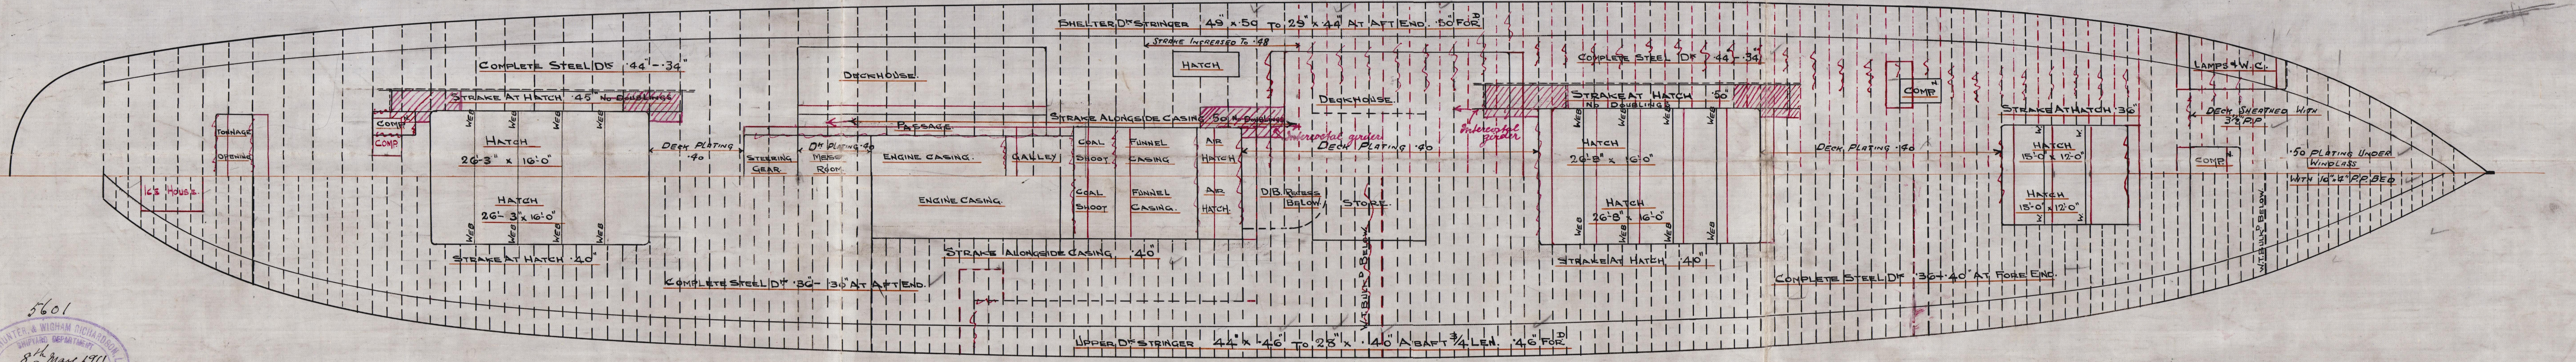

UPPER DECK

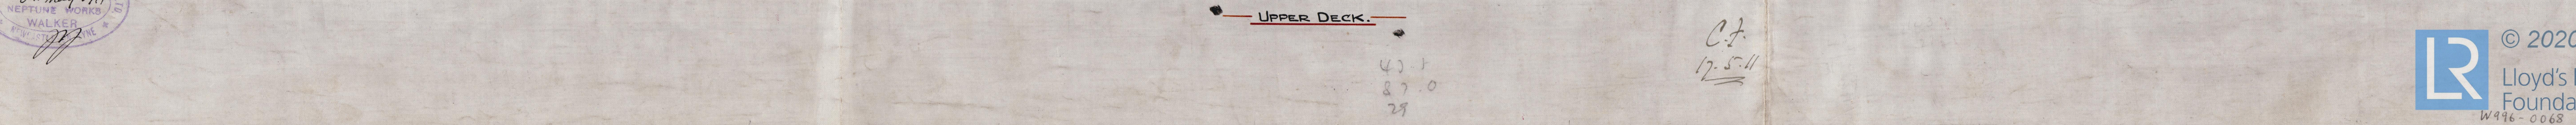

5601
8th May 1911
NEPTUNE WORKS
WALKER
NEWCASTLE

Messrs Swan Hunter &
Wigham Richardson Ltd

SS 870

Profile & Deck plans

W996-0068

S.S. Macsopie
NEWCASTLE-ON-TYNE

Report No. 65722

RETAIN



© 2020

Lloyd's Register
Foundation