

SS. "MARKAY."



TEMPORARY REPAIRS - AS FITTED.

SEE NOTE ON SHEET 1.


SCALE:  $\frac{1}{8}'' = 1 \text{ FOOT}$

3 SHEETS


SHEET: 2

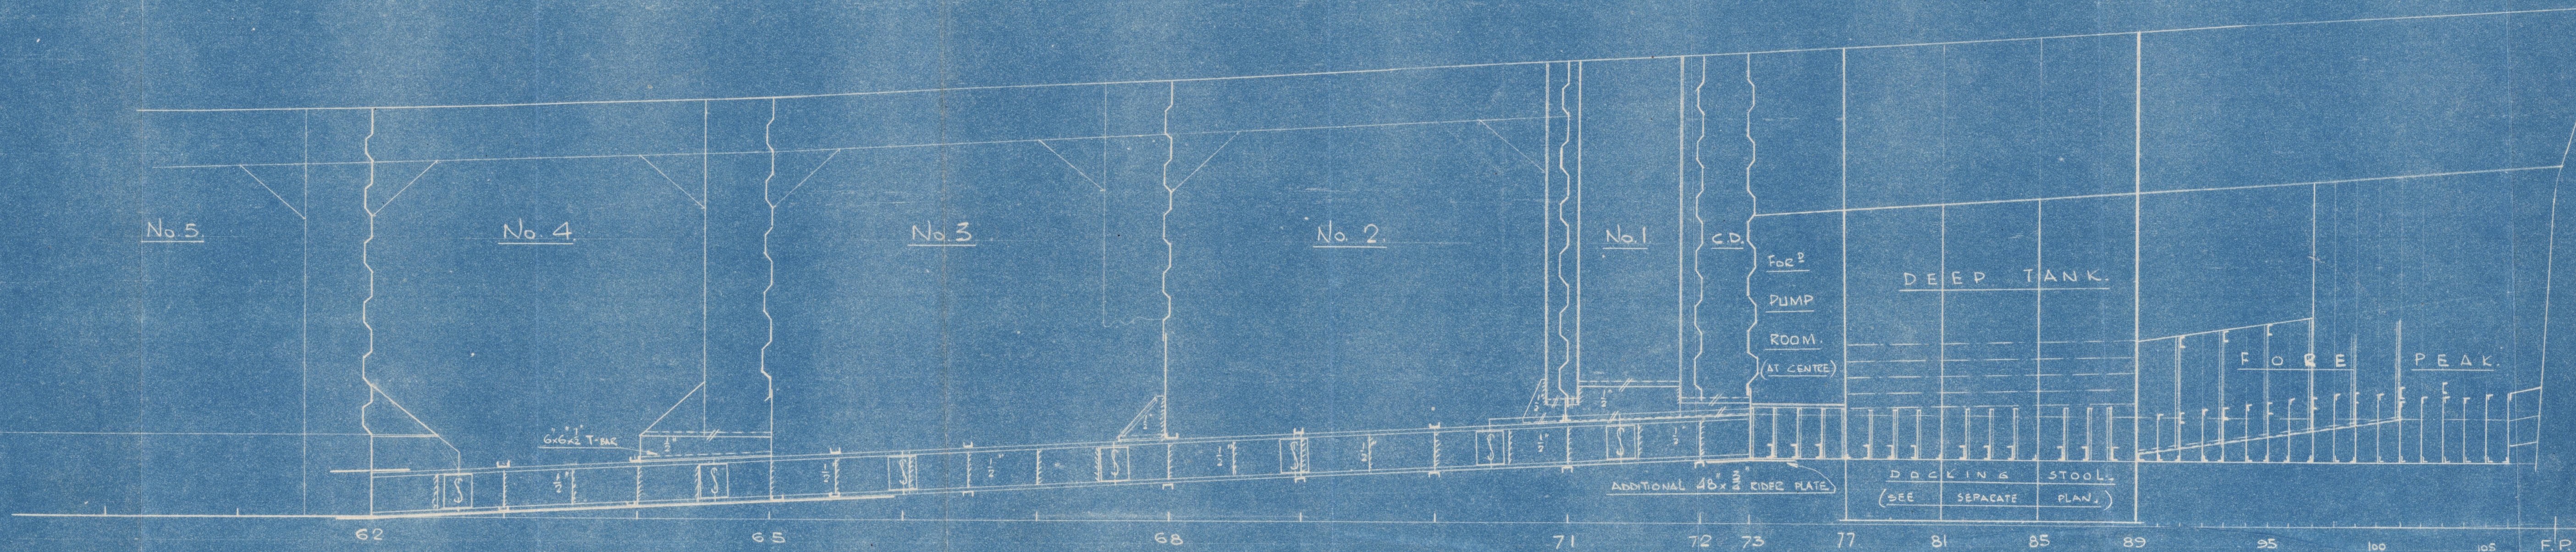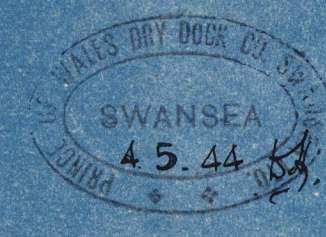


ELEVATION AT CENTRE LINE.

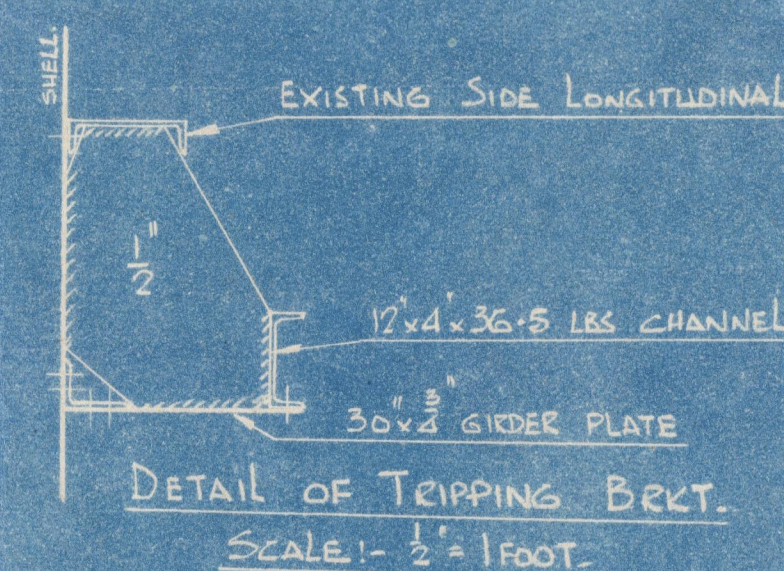

DETAIL OF TRIPPING BKT.  
SCALE:  $\frac{1}{2}'' = 1 \text{ FOOT}$

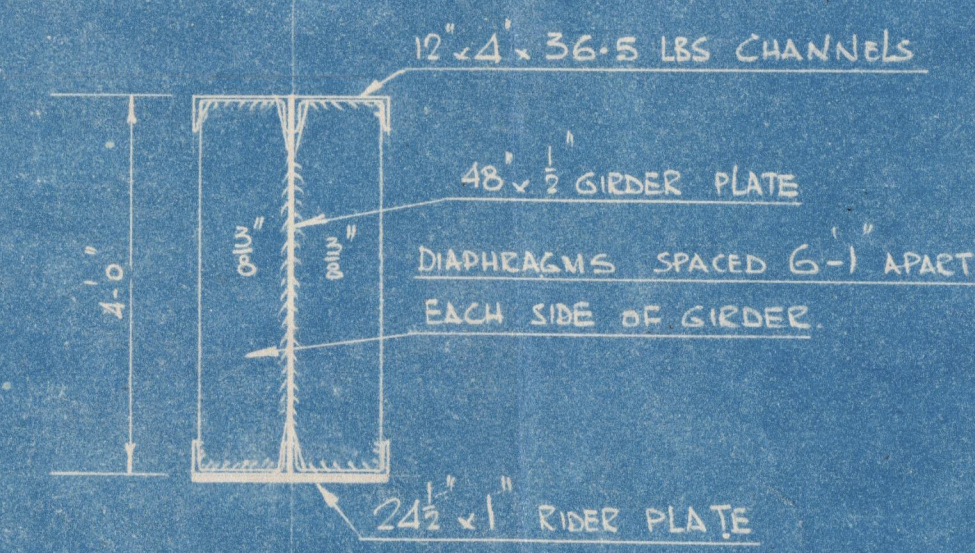


DETAIL OF CENTRE GIRDER  
SCALE:  $\frac{1}{2}'' = 1 \text{ FOOT}$

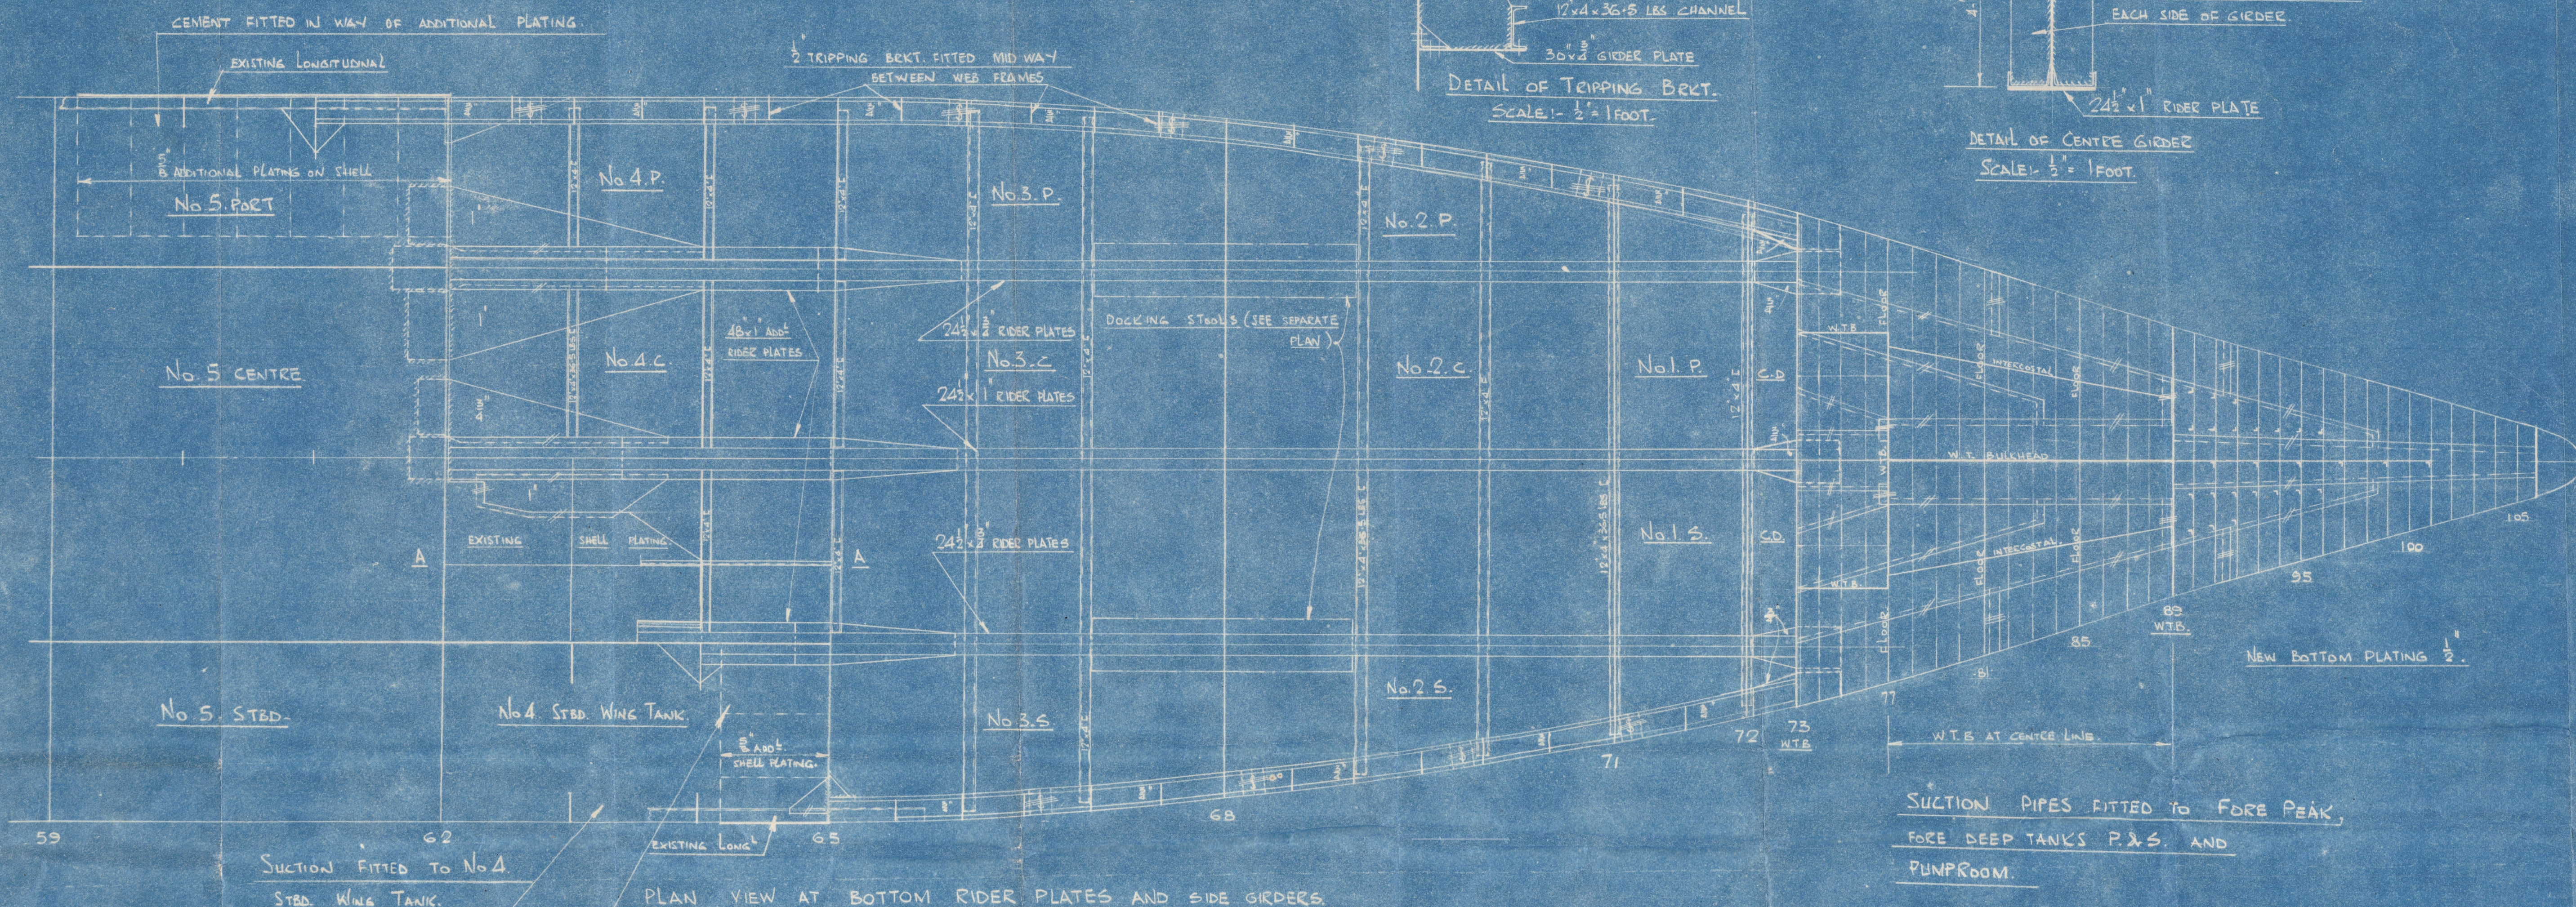


PLAN VIEW AT BOTTOM RIDER PLATES AND SIDE GIRDERS.

CEMENT FITTED IN WAY OF ADD<sup>d</sup> PLATING

SUCTION FITTED TO No. 4 STBD. WING TANK.

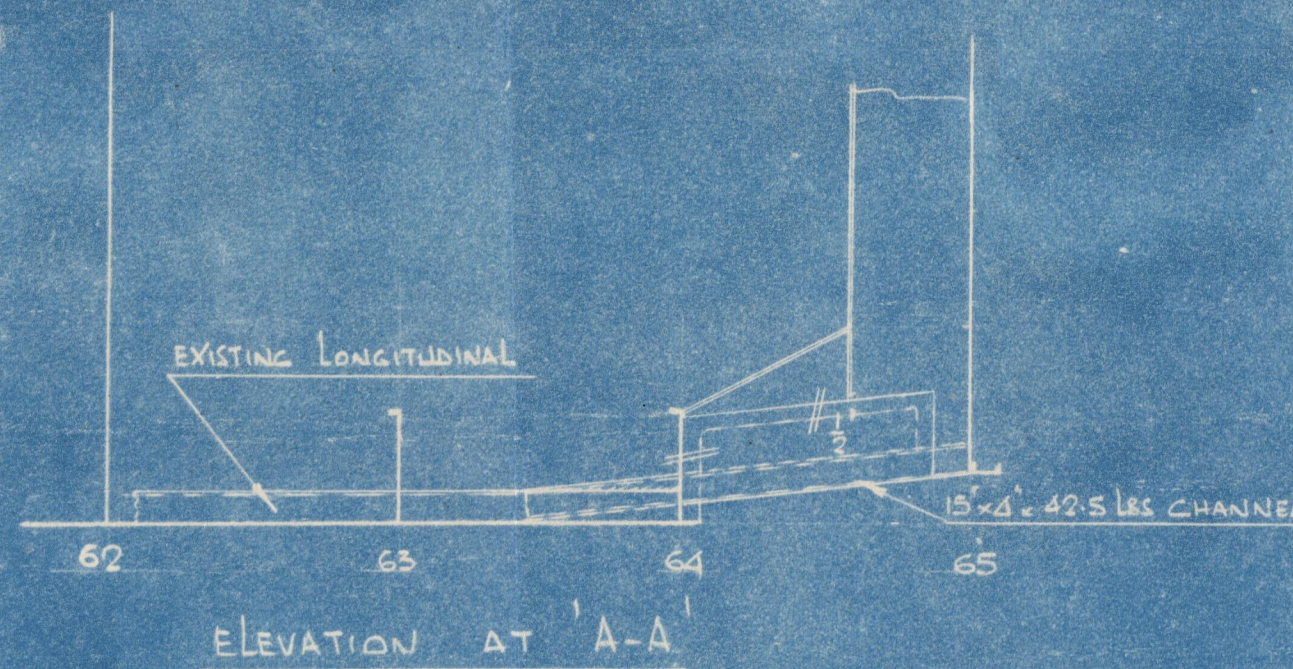

ELEVATION AT A-A

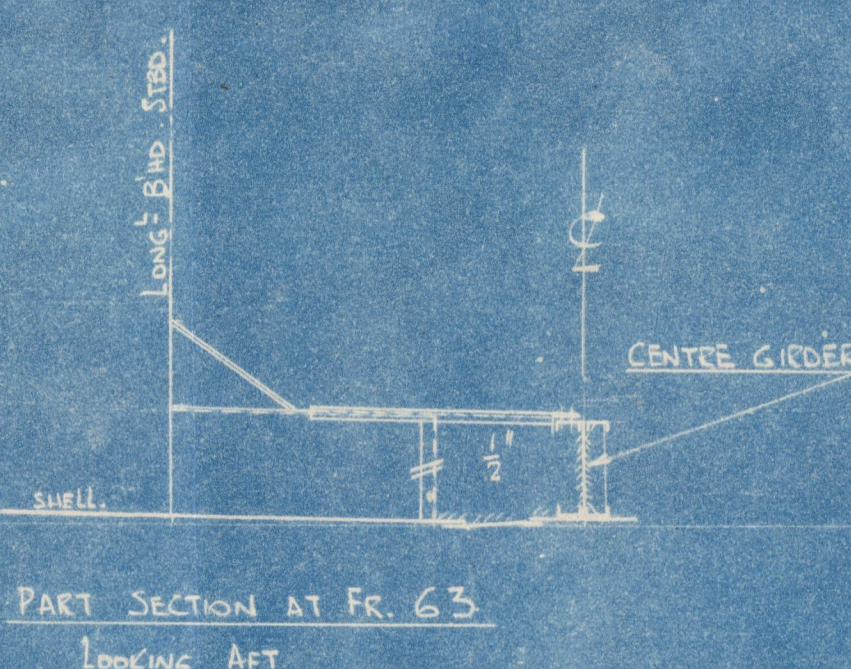

PART SECTION AT FR. 63  
LOOKING AFT.

SUCTION PIPES FITTED TO FORE PEAK, FORE DEEP TANKS P.A.S. AND PUMP ROOM.