



8003.2 2461.
 SS MARKAY.
 TEMPORARY REPAIRS - AS FITTED.
 SCALE :- $\frac{1}{8}$ " = 1 FOOT.

3-SHEETS
 SHEET - 1.
 SHELL -
 STARBOARD.



NOTE
 ARRANGEMENTS SHOWN ARE
 THOSE REQUIRED BY LLOYDS
 REGISTER OF SHIPPING FOR
 ISSUE OF INTERIM CERTIFICATE
 FOR VOYAGE IN BALLAST TO
 A PORT IN THE U.S.A.

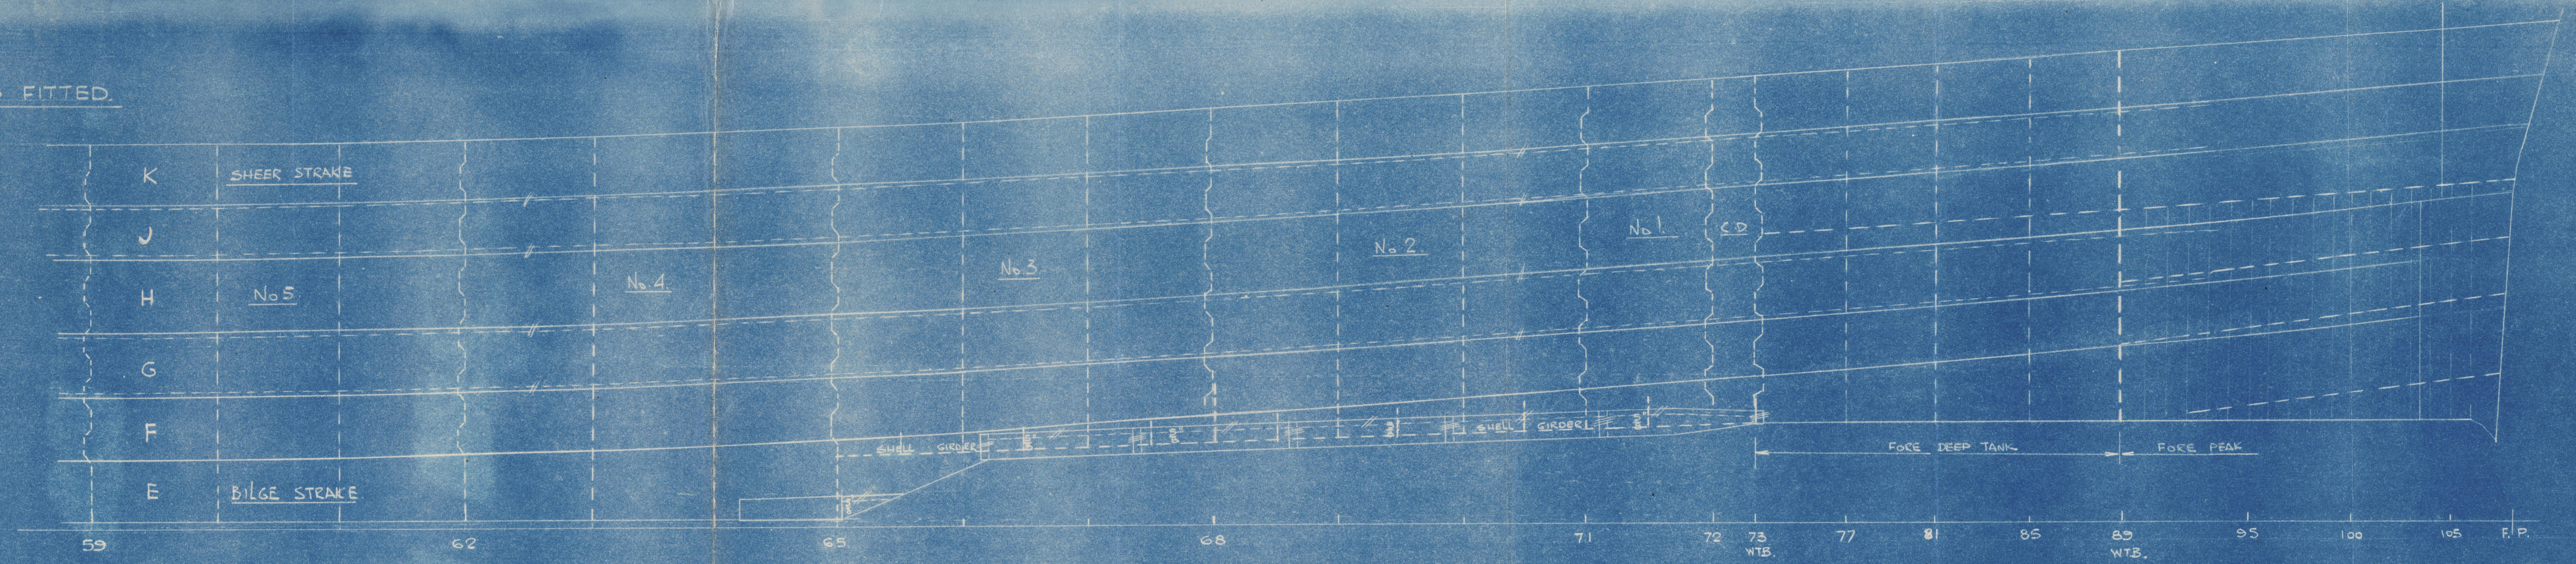

SHELL -
 PORT.

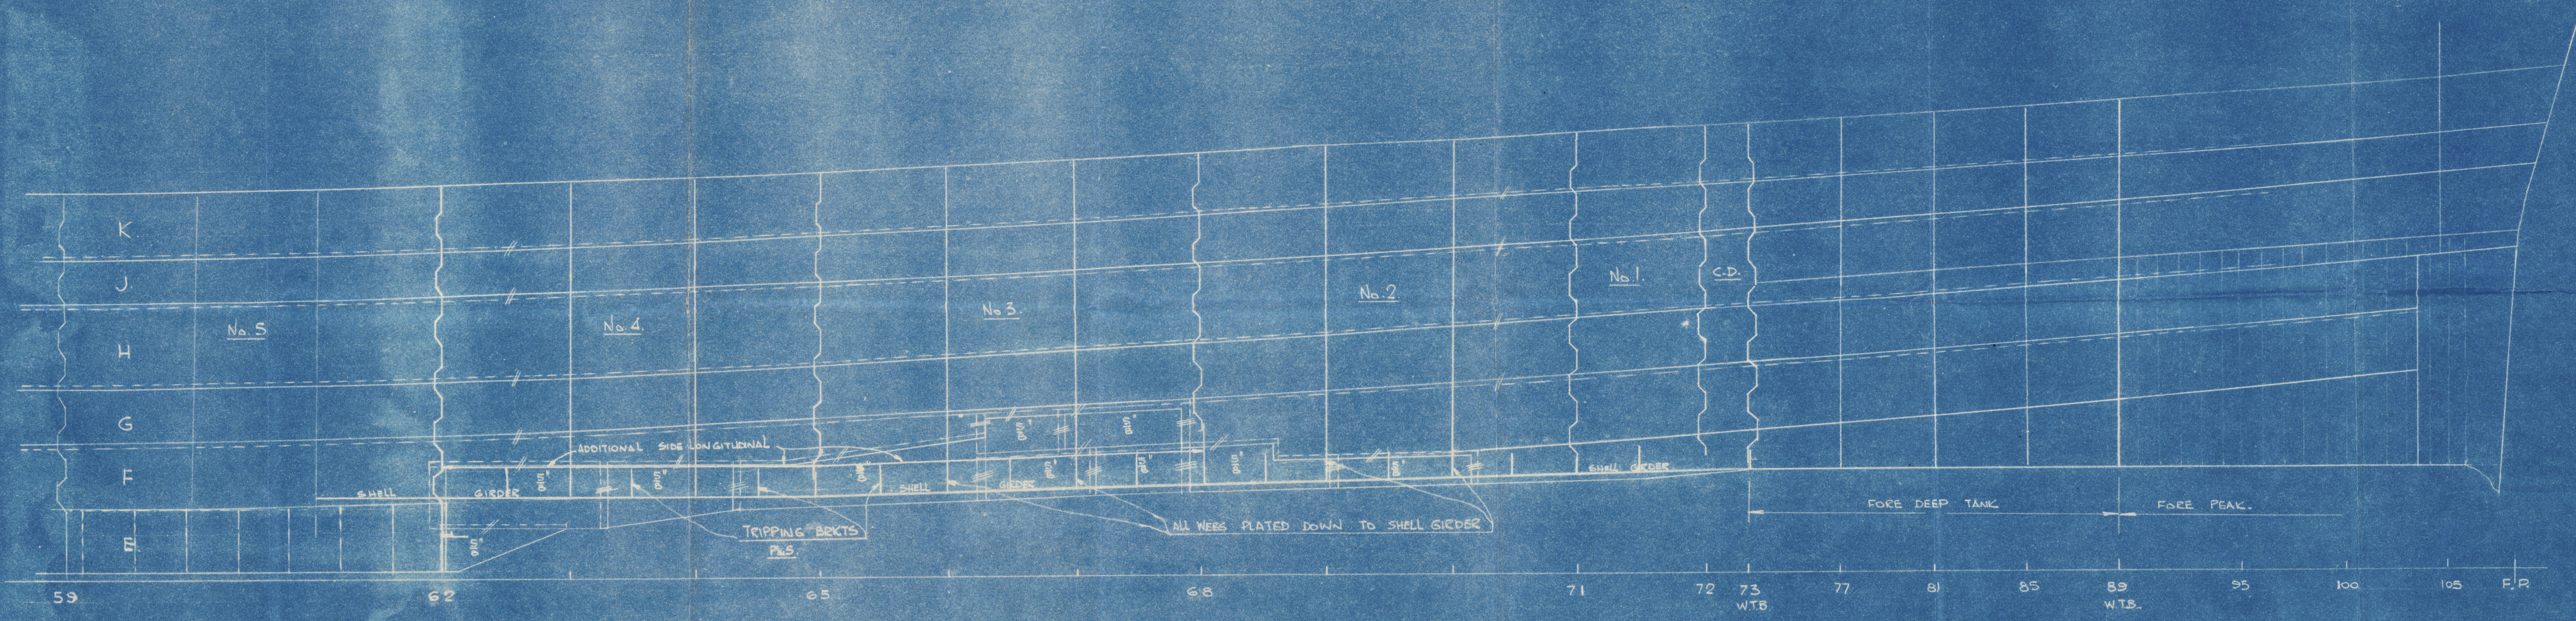

LONGITUDINAL BULKHEAD -
 STARBOARD.

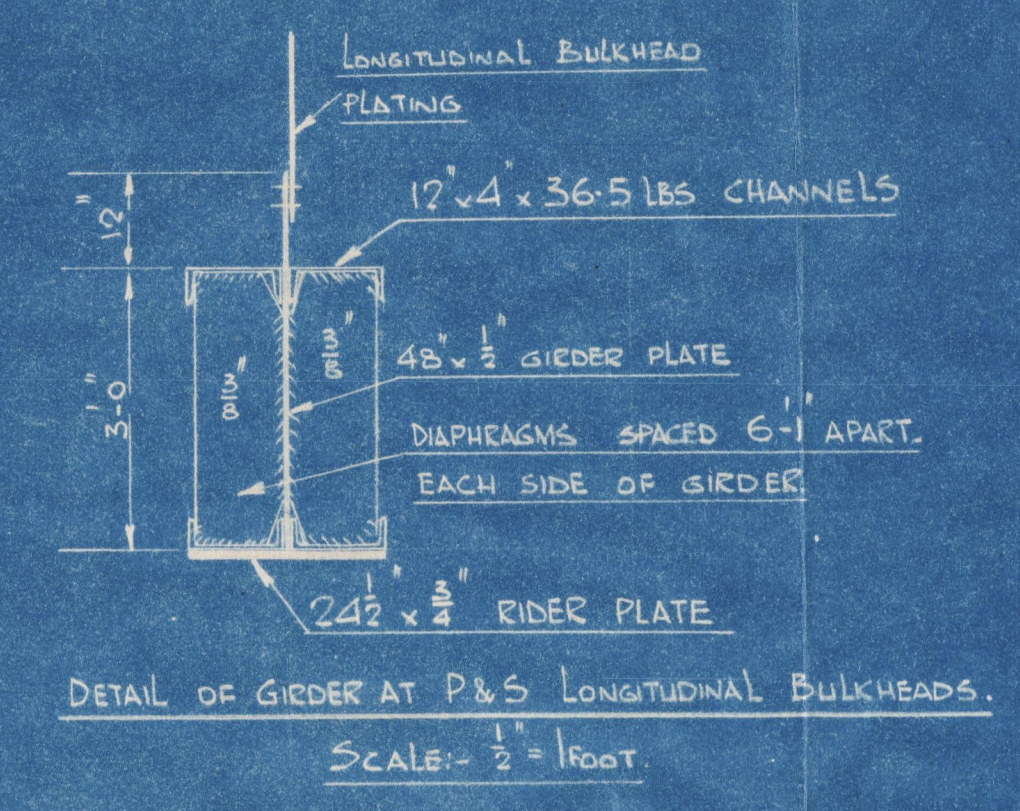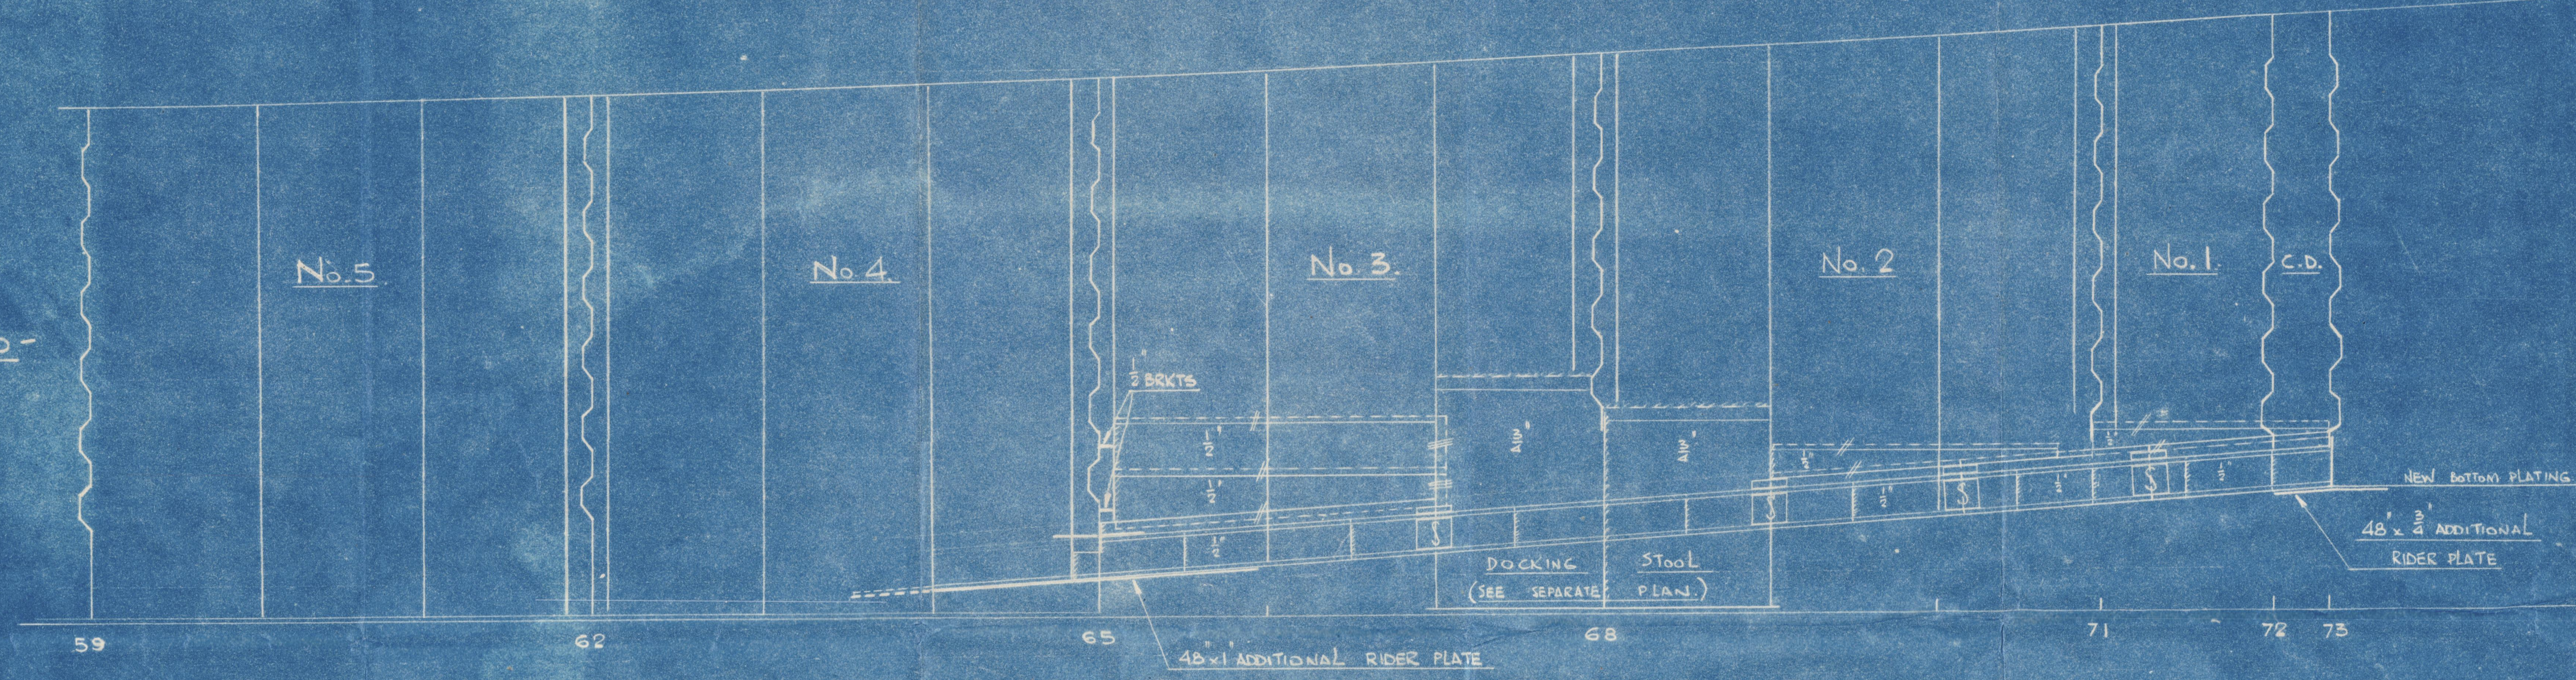

LONGITUDINAL BULKHEAD -
 PORT.

